


CONSTRUCT DRIVE		
Sta	Pos	
74+25	LT	
75+20	RT	
76+25	LT	
76+25	RT	

PARCEL INSTRUMENT DATE	GRANTOR	GRANTEE	RECORDED BRIGHTON BOOK	PAGE	DATE	REMARKS
#4 A, B, C Rev. 11 72+310=72+303	W. D.	S. J. & MILDRED HEATH ST. OF VT.	23	330-331	6-30-48	

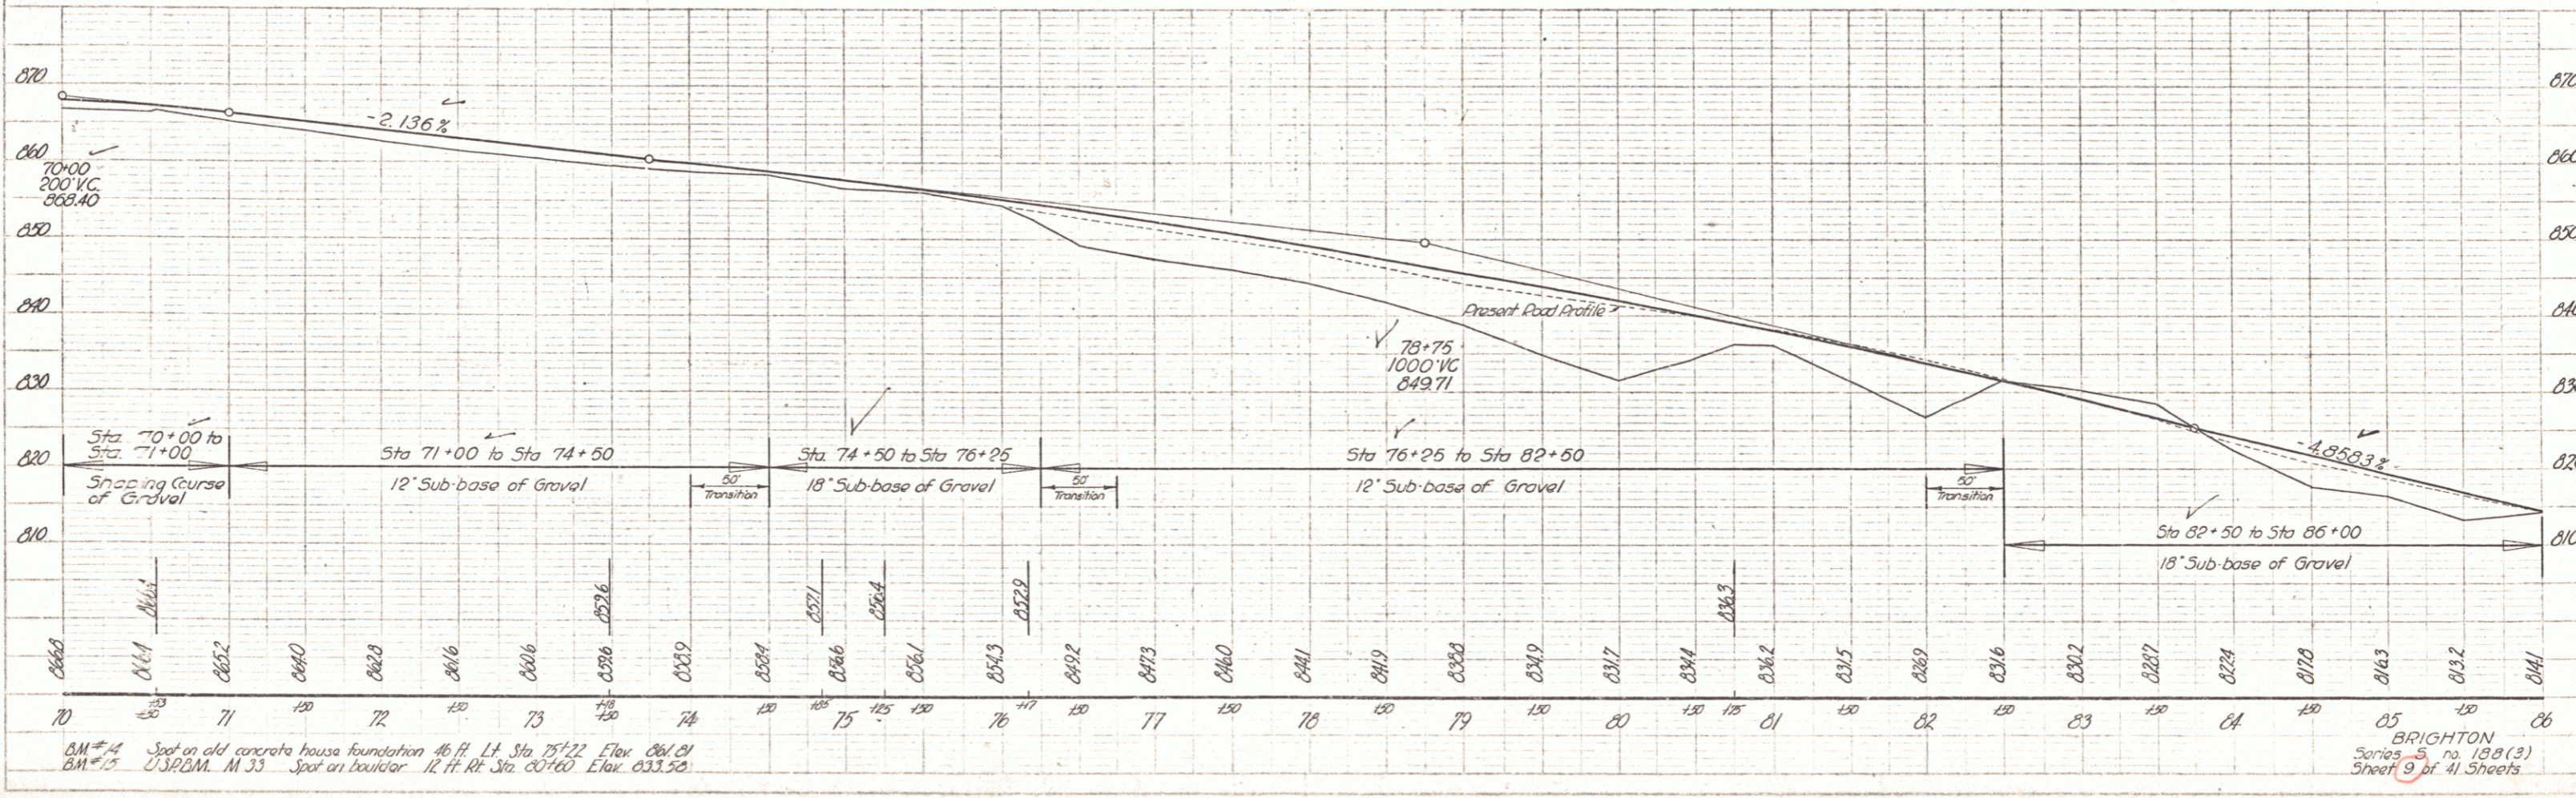

BM #4 Spot on old concrete house foundation 46 ft. LT Sta 75+22 Elev. 061.01
 USPB.M. M 33 Spot on Boulder 11 ft. RT Sta 80+100 Elev. 033.50

BRIGHTON
 Series 5, no. 199(3)
 Sheet 9 of 41 Sheets