


PLAN
 DRAWING
 SHEET NO. 10013
 DATE 1927

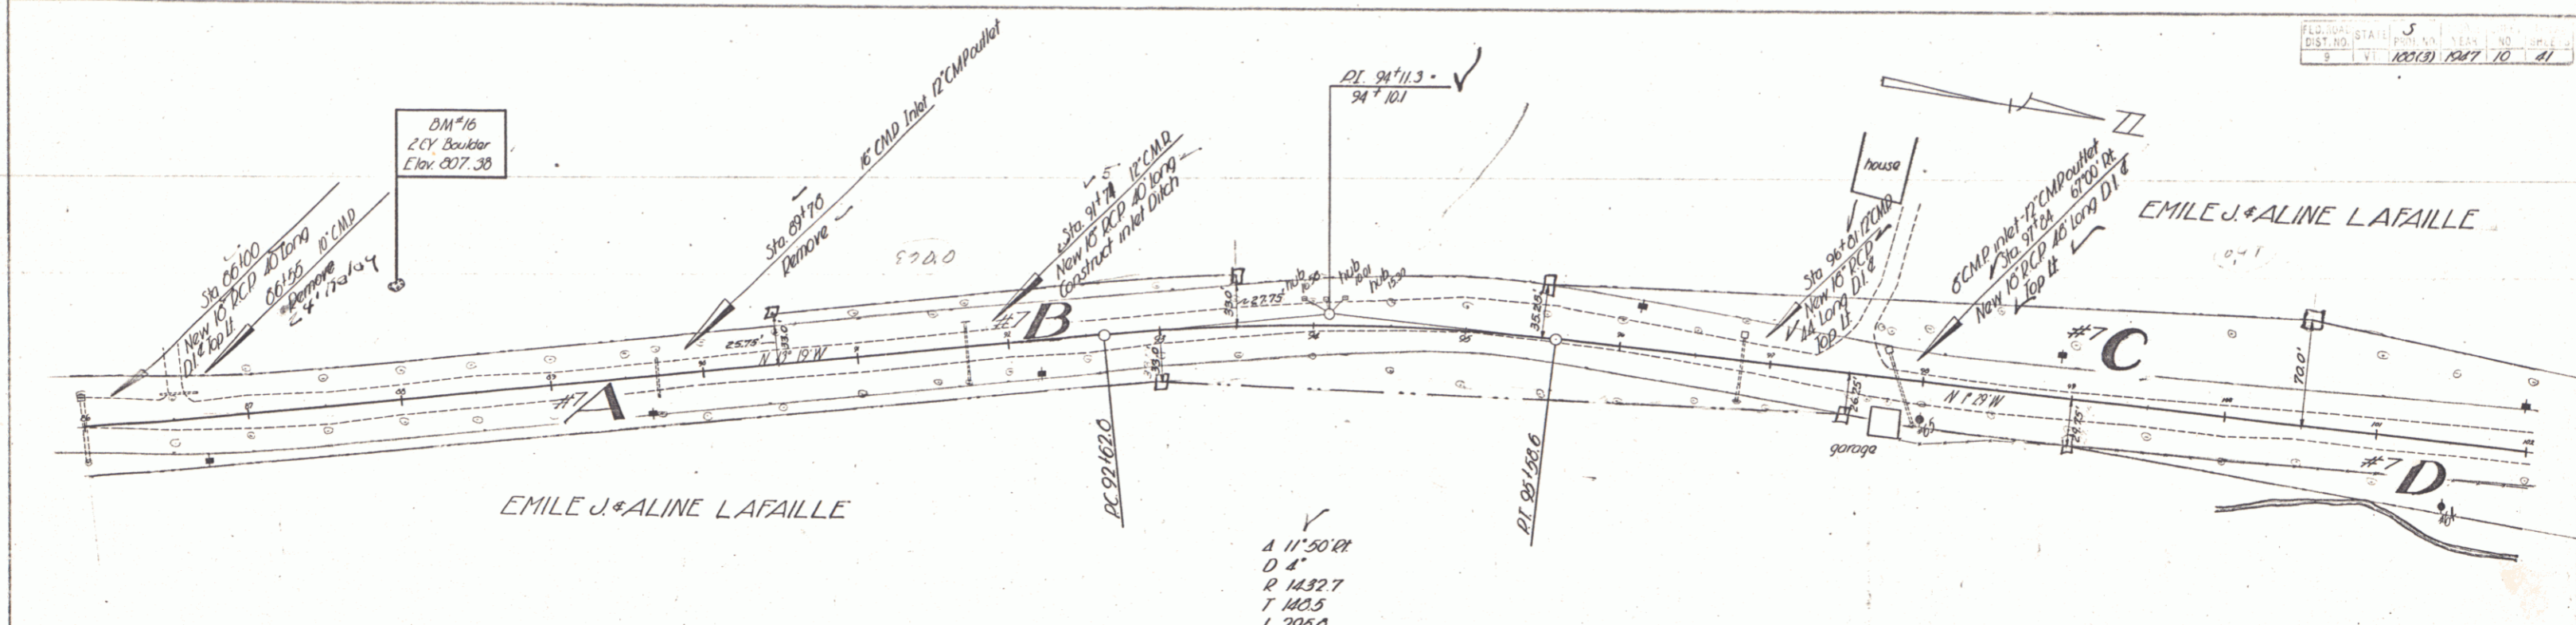

PARCEL	INSTRUMENT	DATE	GRANTOR	GRANTEE	RECORDED	REMARKS
#7 A, B, C, & D	W. D.	5-21-48	EMILE J. & ALINE LAFAILLE	ST. OF VT.	BOOK 23 PAGE 299-230 DATE 5-27-48	

Δ 11°50' RT
 D 4'
 R 1432.7
 T 140.5
 L 223.0
 E 77'
 Bank 1/2 per ft

CONSTRUCT DRIVE		
Sta	Sta	Pos
97+50		LT
97+50		LT

PROFILE
 DRAWING
 SHEET NO. 10013
 DATE 1927

