



PLAN
 DATE 7-18
 DRAWN BY G. Daugherty
 CHECKED

PROFILES
 DATE 7-18
 DRAWN BY G. Daugherty
 CHECKED

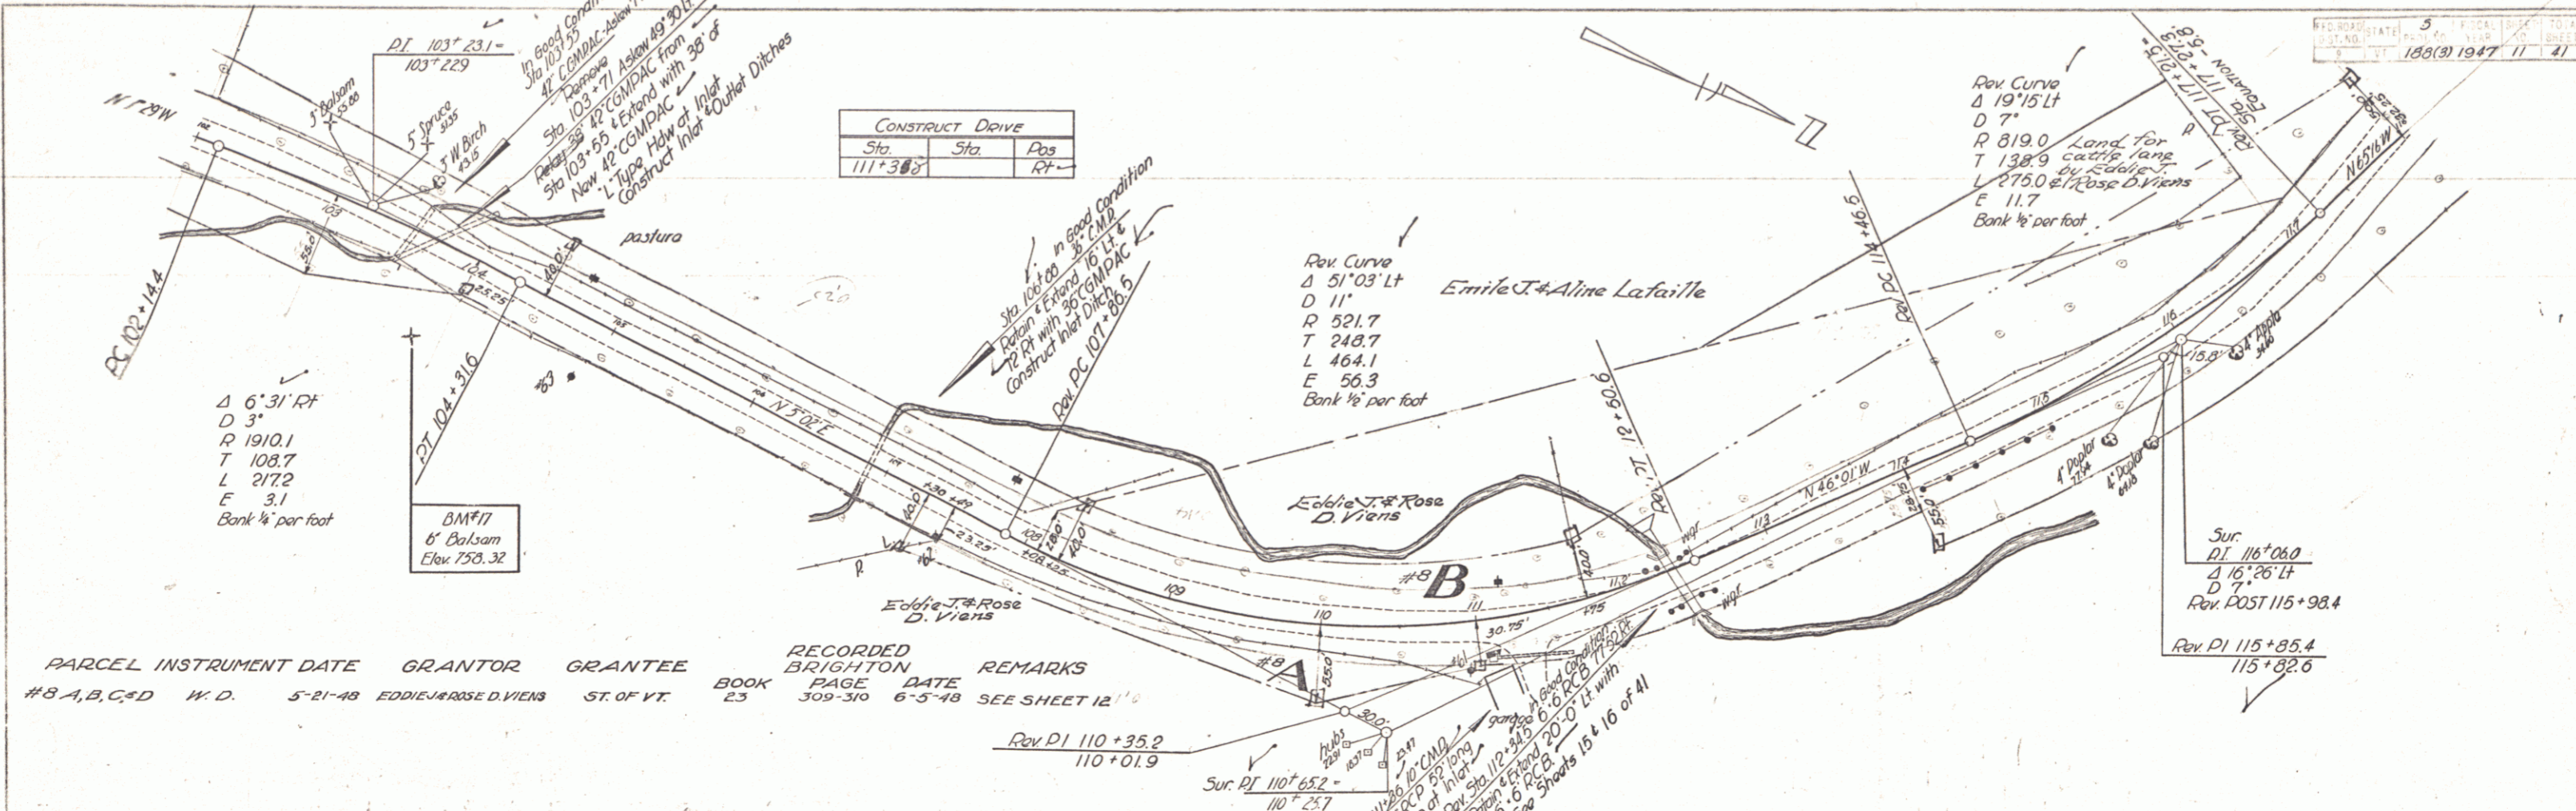

PARCEL INSTRUMENT DATE	GRANTOR	GRANTEE	BOOK	PAGE	DATE	REMARKS
#8 A, B, C, D	W. D.	5-21-48	EDDIE J. & ROSE D. VIERS	ST. OF VT.	23	309-310 6-5-48 SEE SHEET 12

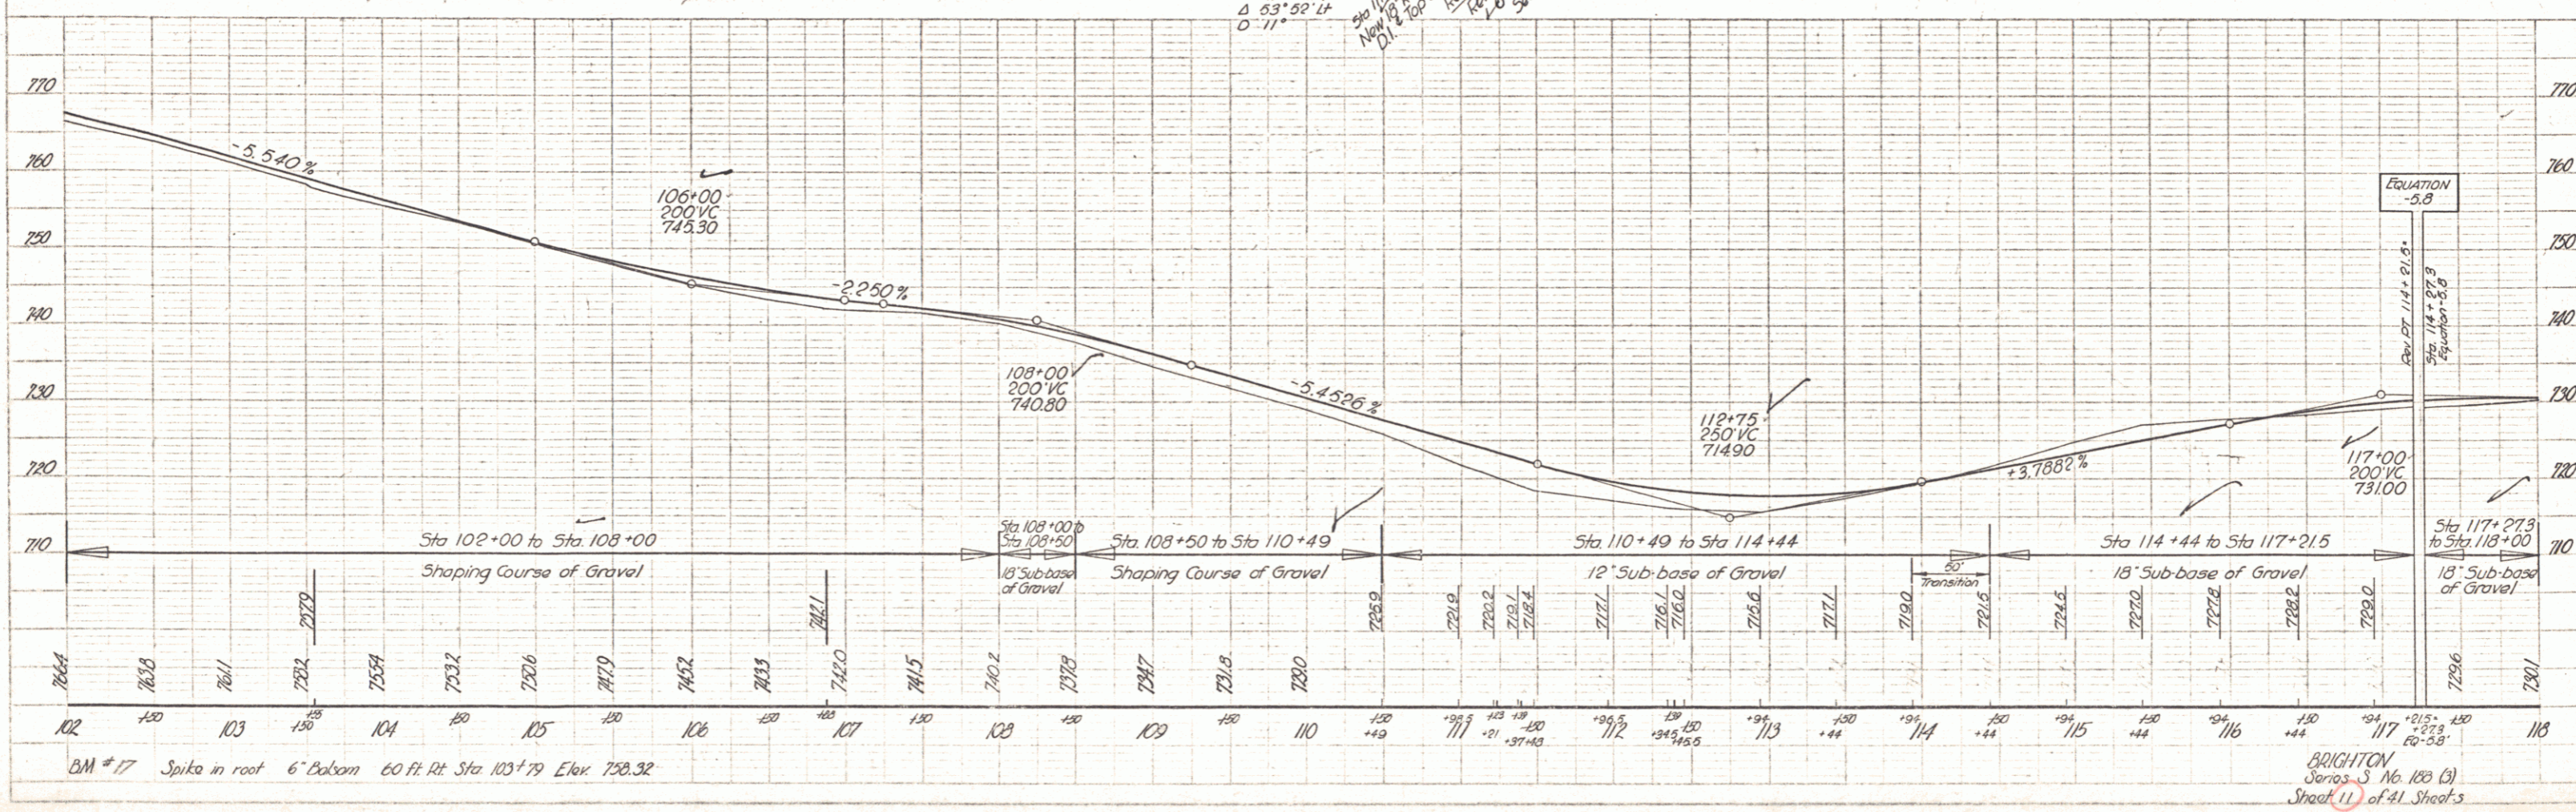

BRIGHTON
 Series 3 No. 103 (2)
 Sheet 11 of 41 Sheets