



PARCEL INSTRUMENT DATE GRANTOR GRANTEE RECORDED BRIGHTON REMARKS
 #5A & B W.D. 5-21-48 J.V. MAUDE D. WADE ST OF VT. BOOK 23 PAGE 301-302 DATE 5-27-48

REV CURVE
 Δ 52° 21' 11" L
 D 12'
 R 478.3
 T 234.7
 L 436.3
 E 54.6
 Bank 1/2 per foot

STA	STA	Pos
132+00	132+50	Lt.
132+00	133+50	Rt.
133+50	135+50	Lt.

PLAN
 DATE 5-27-48
 DRAWN BY G. Houghton
 CHECKED

PROF.
 DATE 5-27-48
 DRAWN BY G. Houghton
 CHECKED

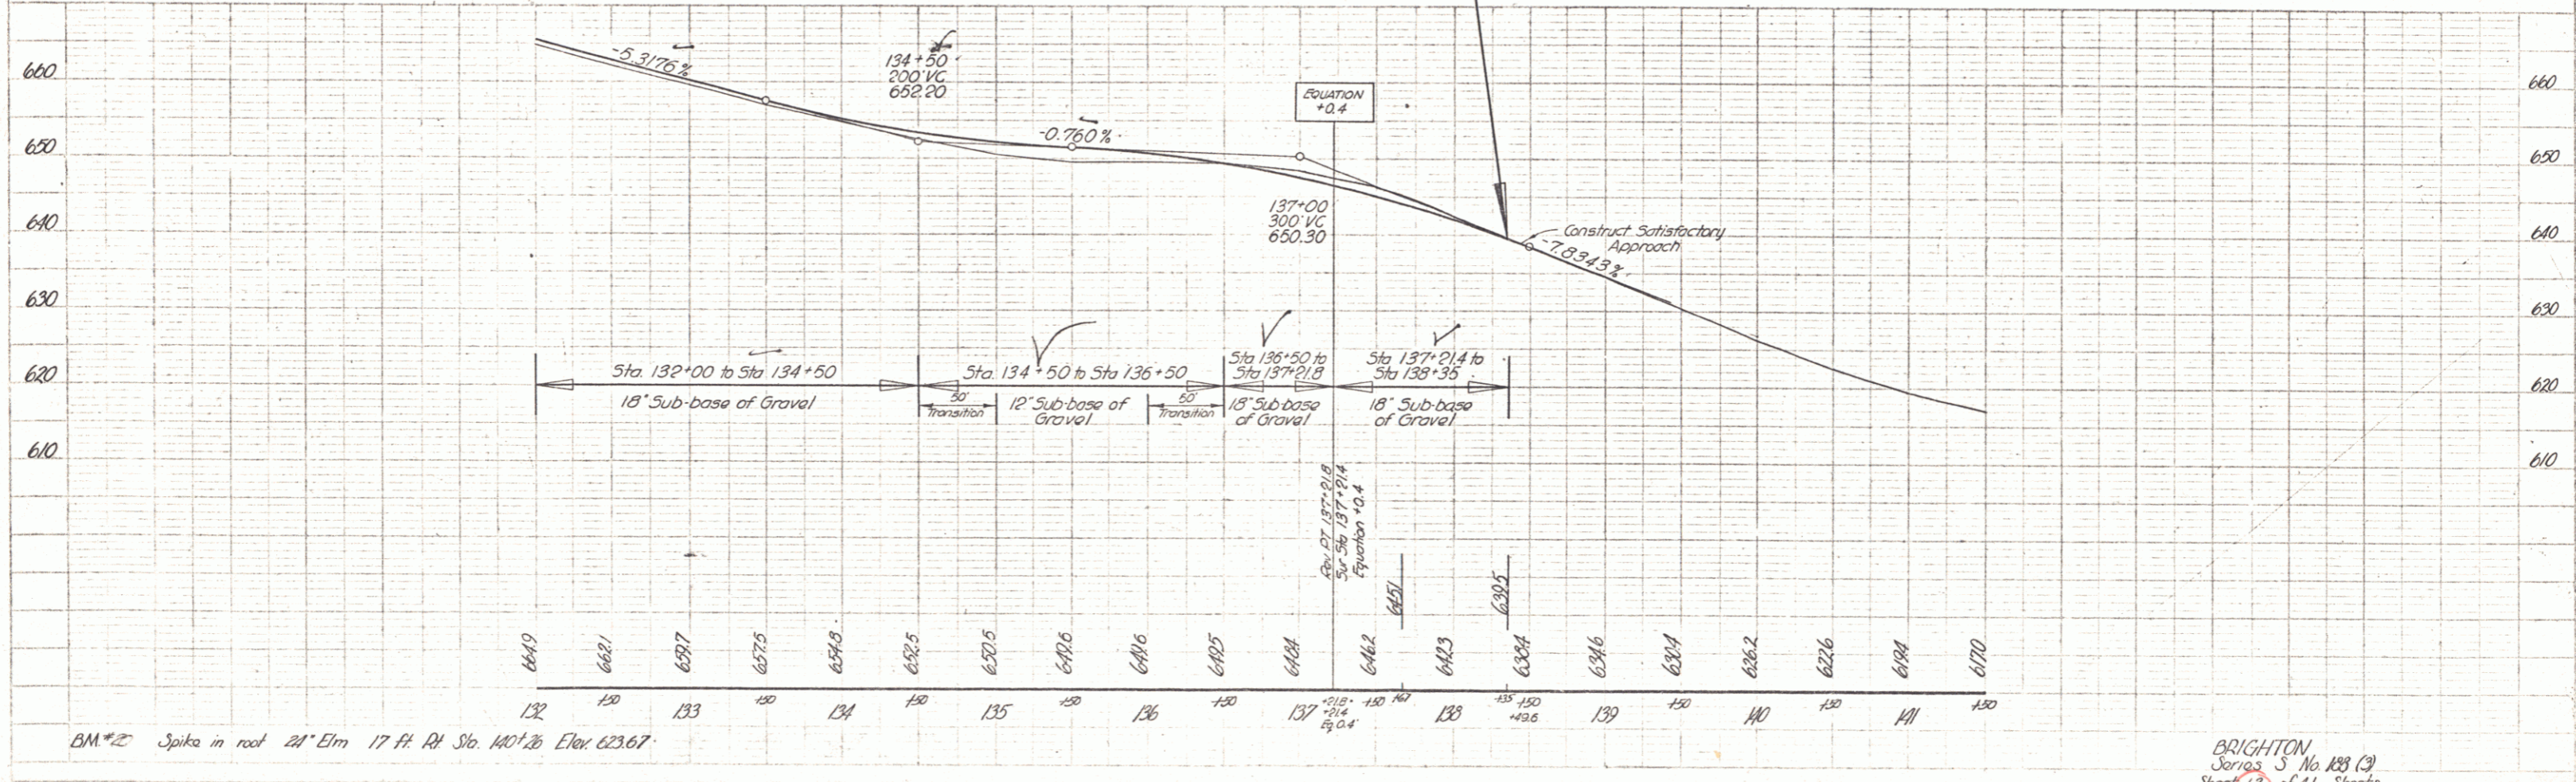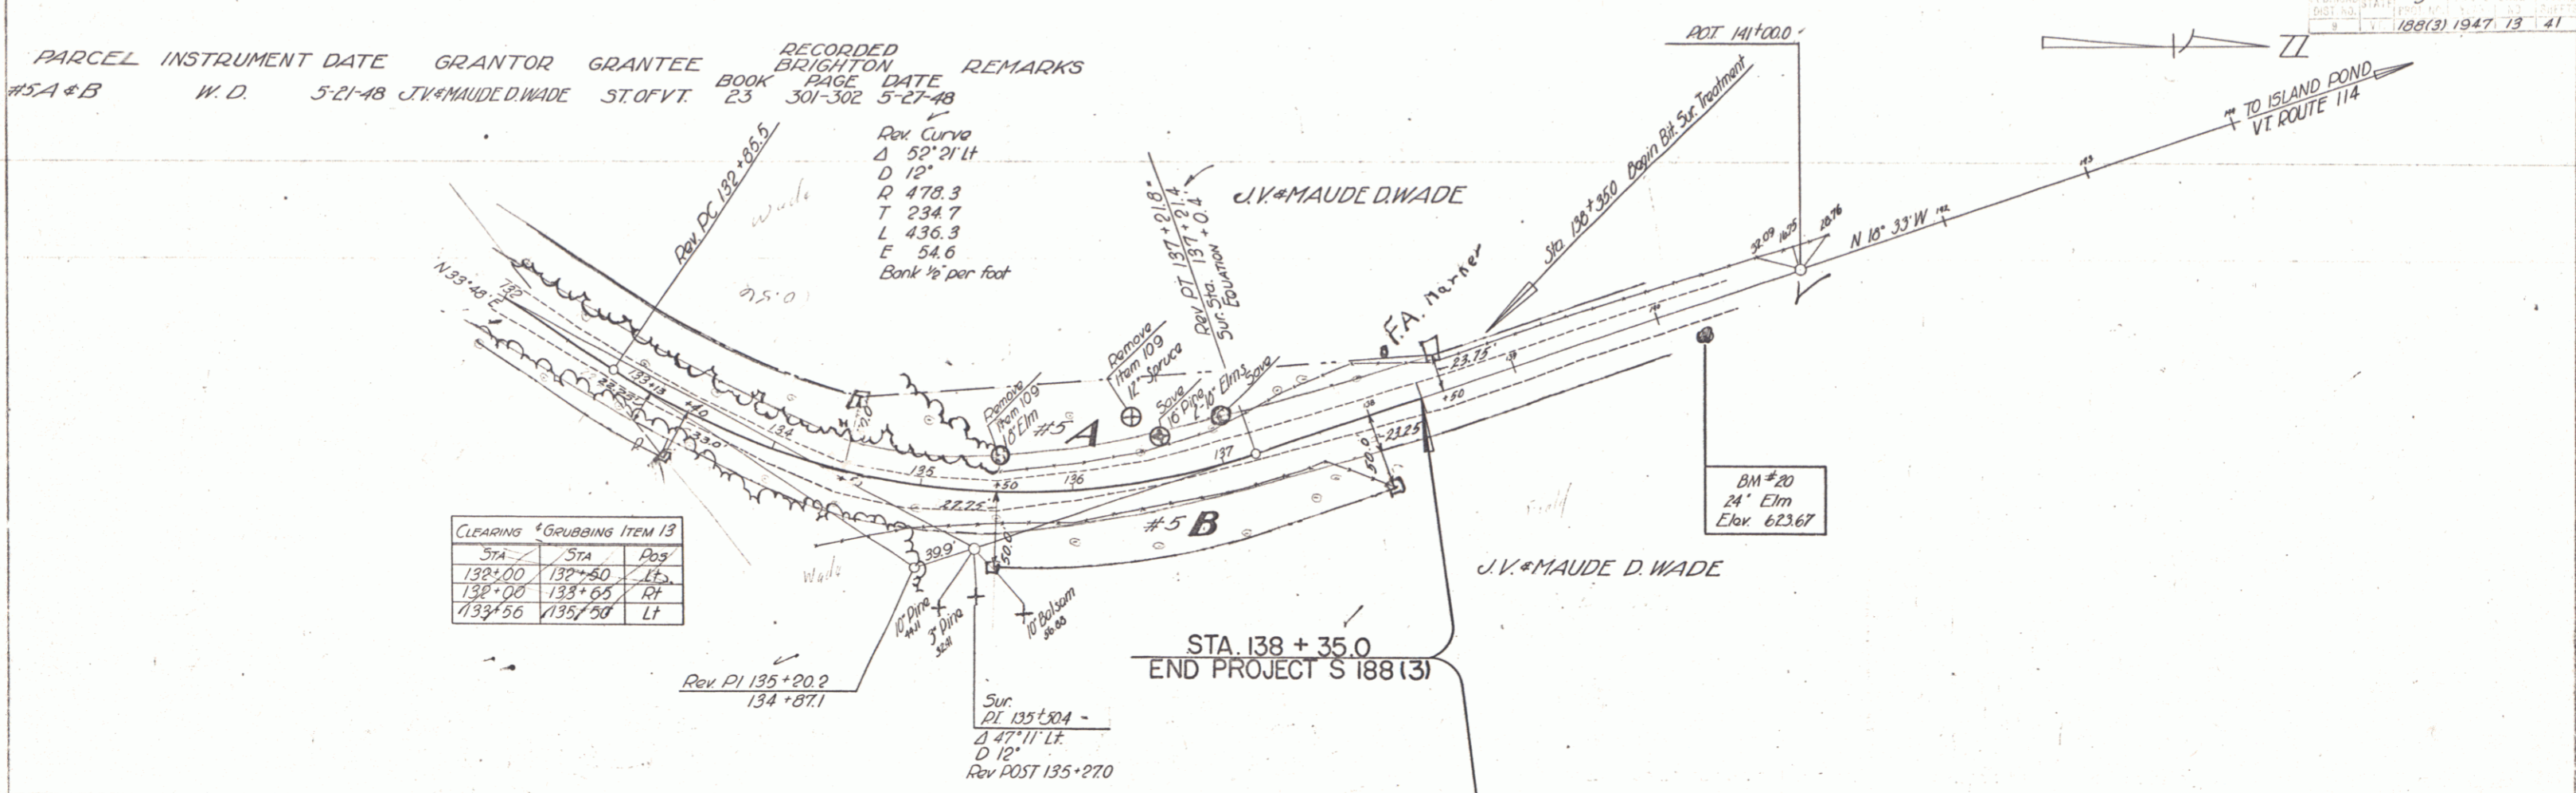

BM #2 Spike in roof 24' Elm 17 ft. Rt. Sta. 140+26 Elev. 623.67

BRIGHTON
 Series S No. 188 (3)
 Sheet 13 of 41 Sheets