
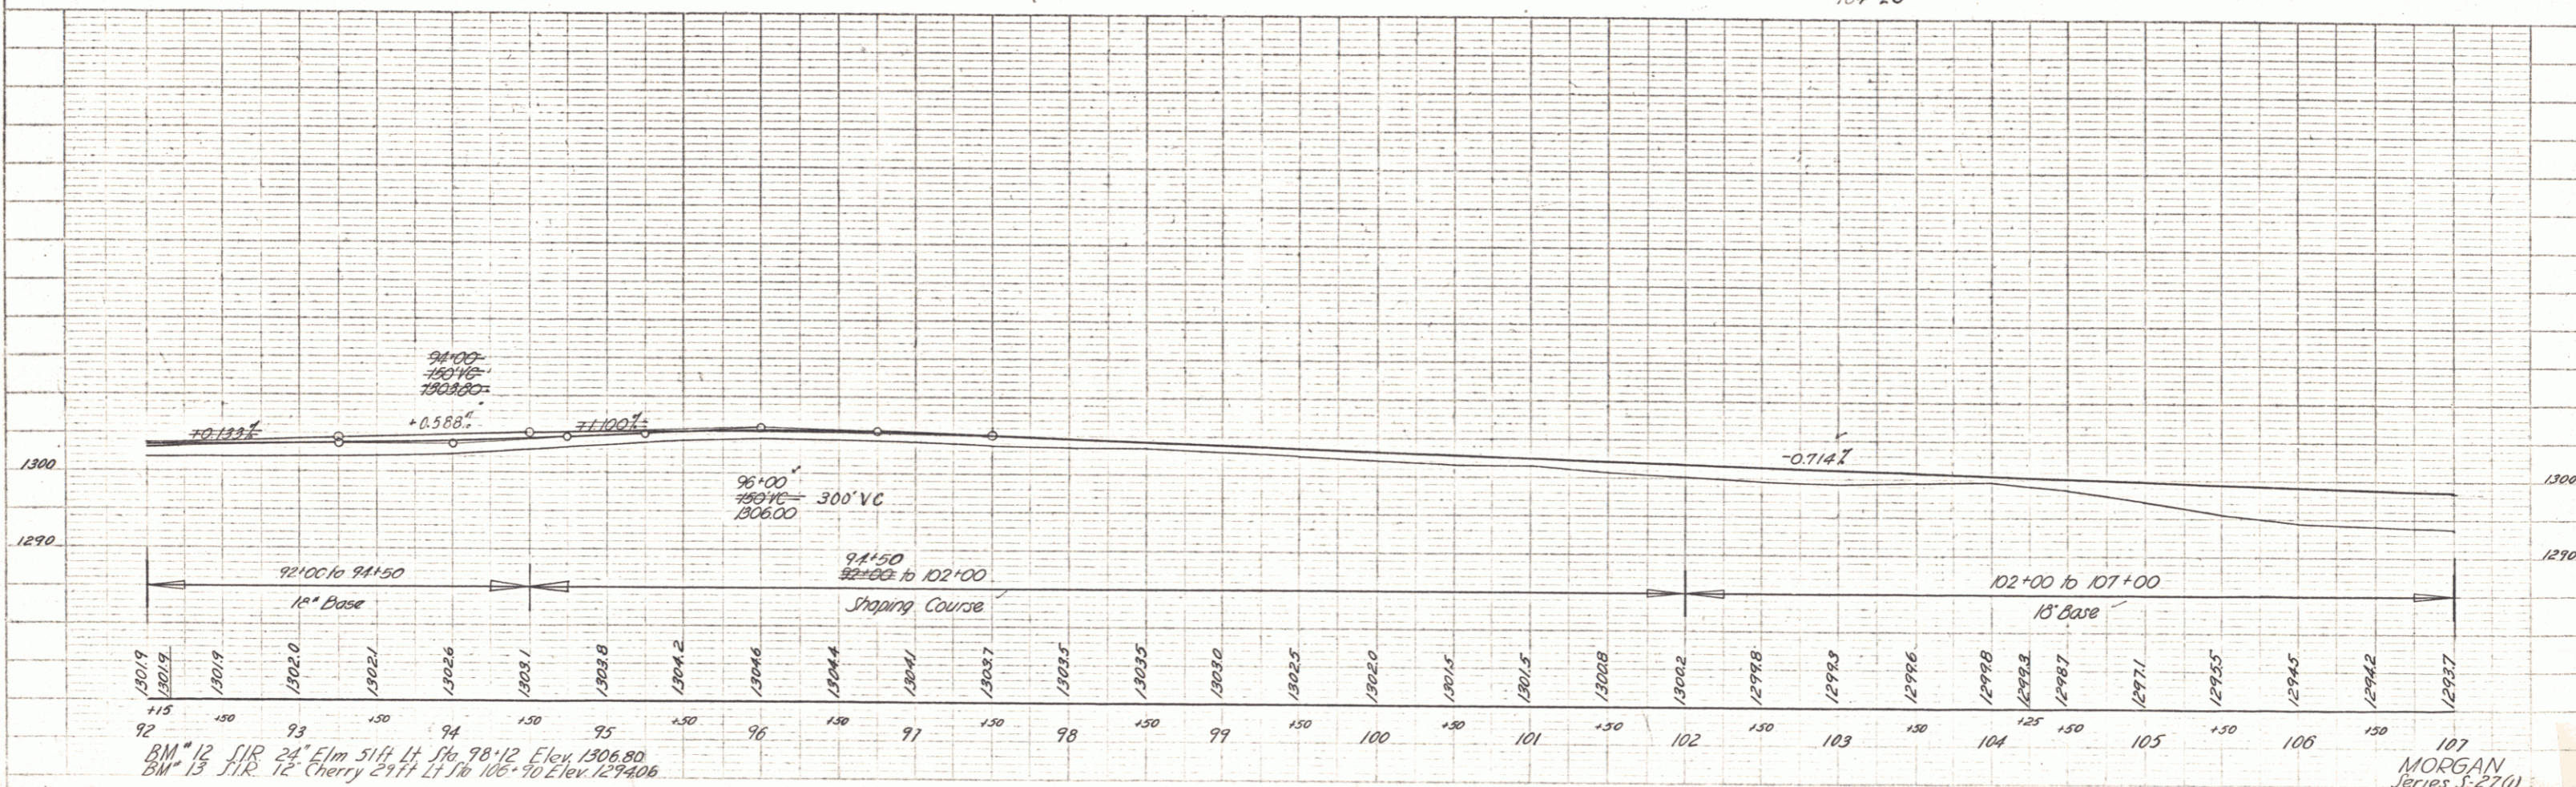


PLAN  
 DATE 11-28-49  
 DRAWN BY J. J. JONES  
 CHECKED BY N. L. STEVENS

11-28-49  
 1-49  
 A. J. JONES  
 A. J. JONES

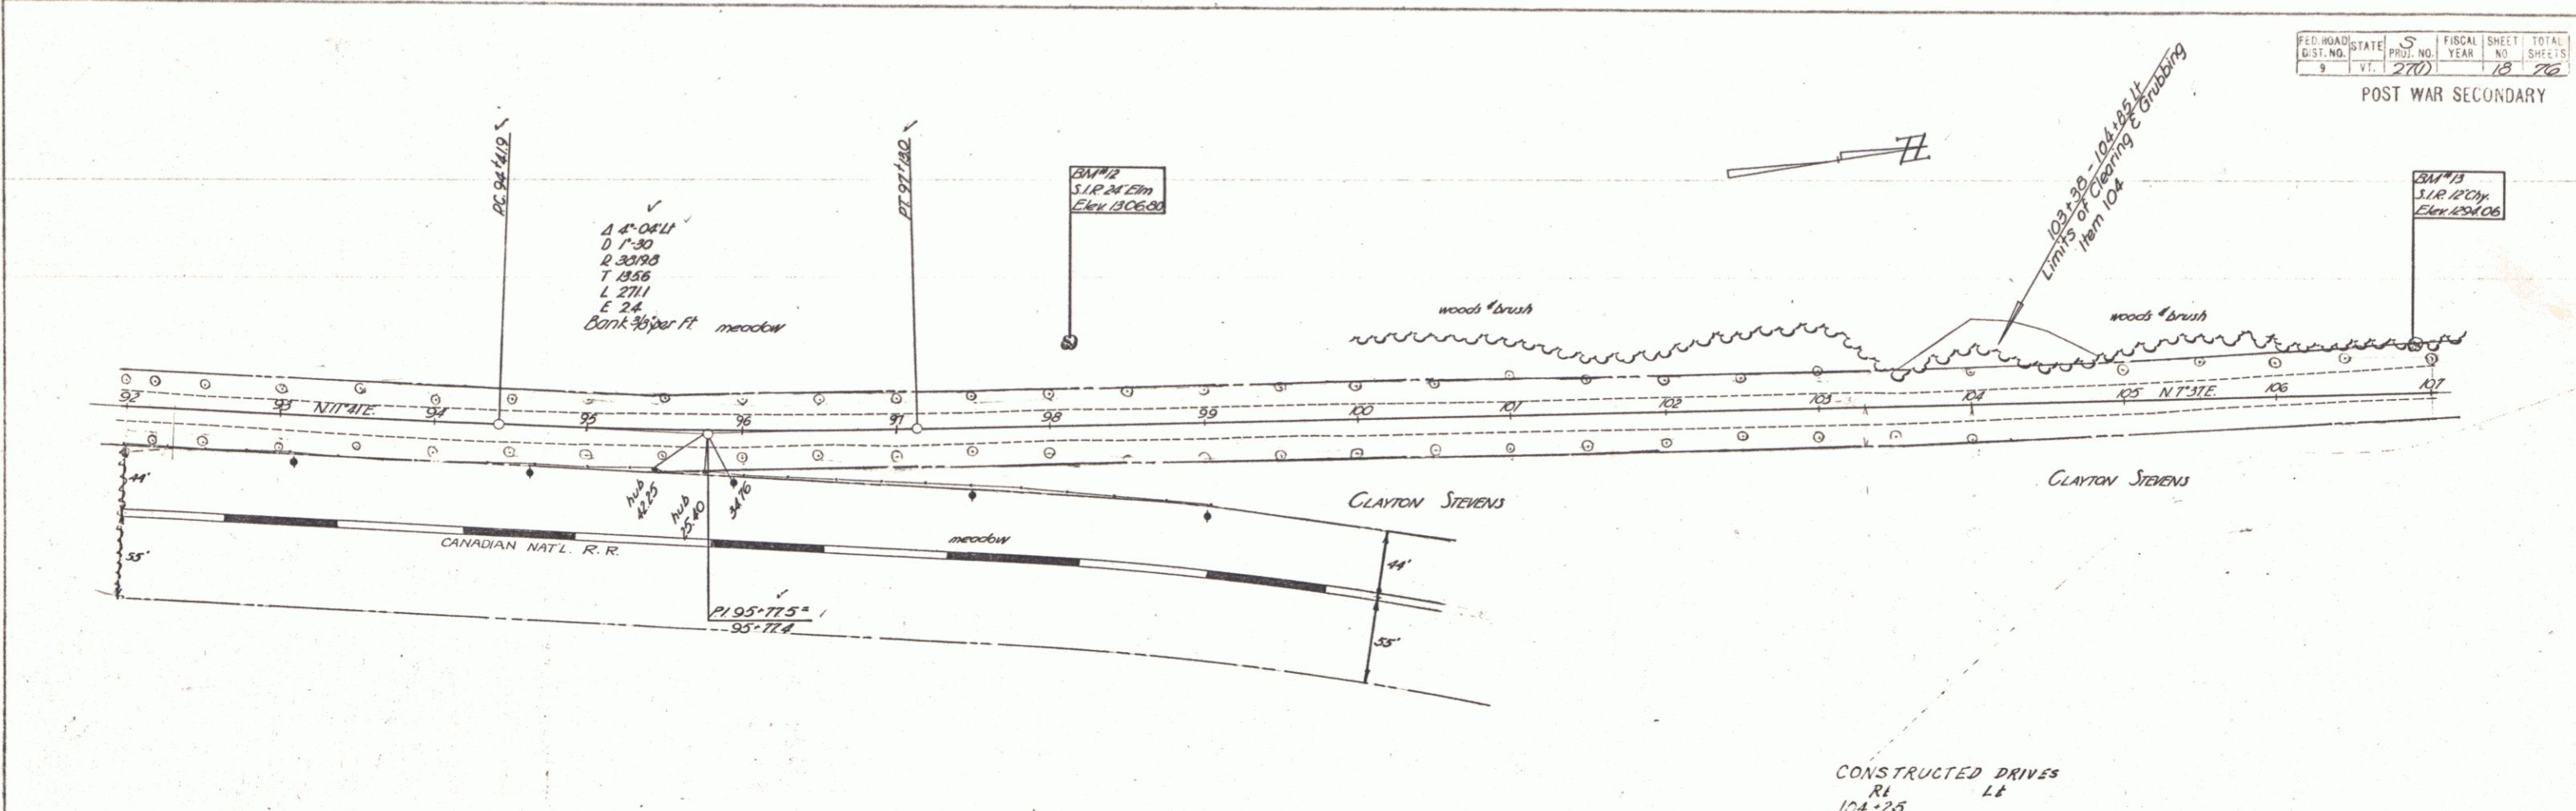

BM#12 S.I.R. 24 Elm 514 Lt. Sta. 98+12 Elev. 1306.80  
 BM#13 S.I.R. 12 Chery 297 Lt. Sta. 106+30 Elev. 1294.06

MORGAN  
 Series S-270  
 Sheet 13 of 26 sheets