

Wood Guide Posts


Sta	Sta	Sta	Lt	Rt
125+80	127+33	16		10
126+54				
133+72	134+24	16		13
133+04				1
137+74				1
142+40				1

PLAN

DATE	11-29
BY	W.L.L.
CHECKED	W.L.L.
SCALE	1" = 40'

PROFILE

DATE	11-29
BY	A.S.G.
CHECKED	A.S.G.
SCALE	1" = 10'

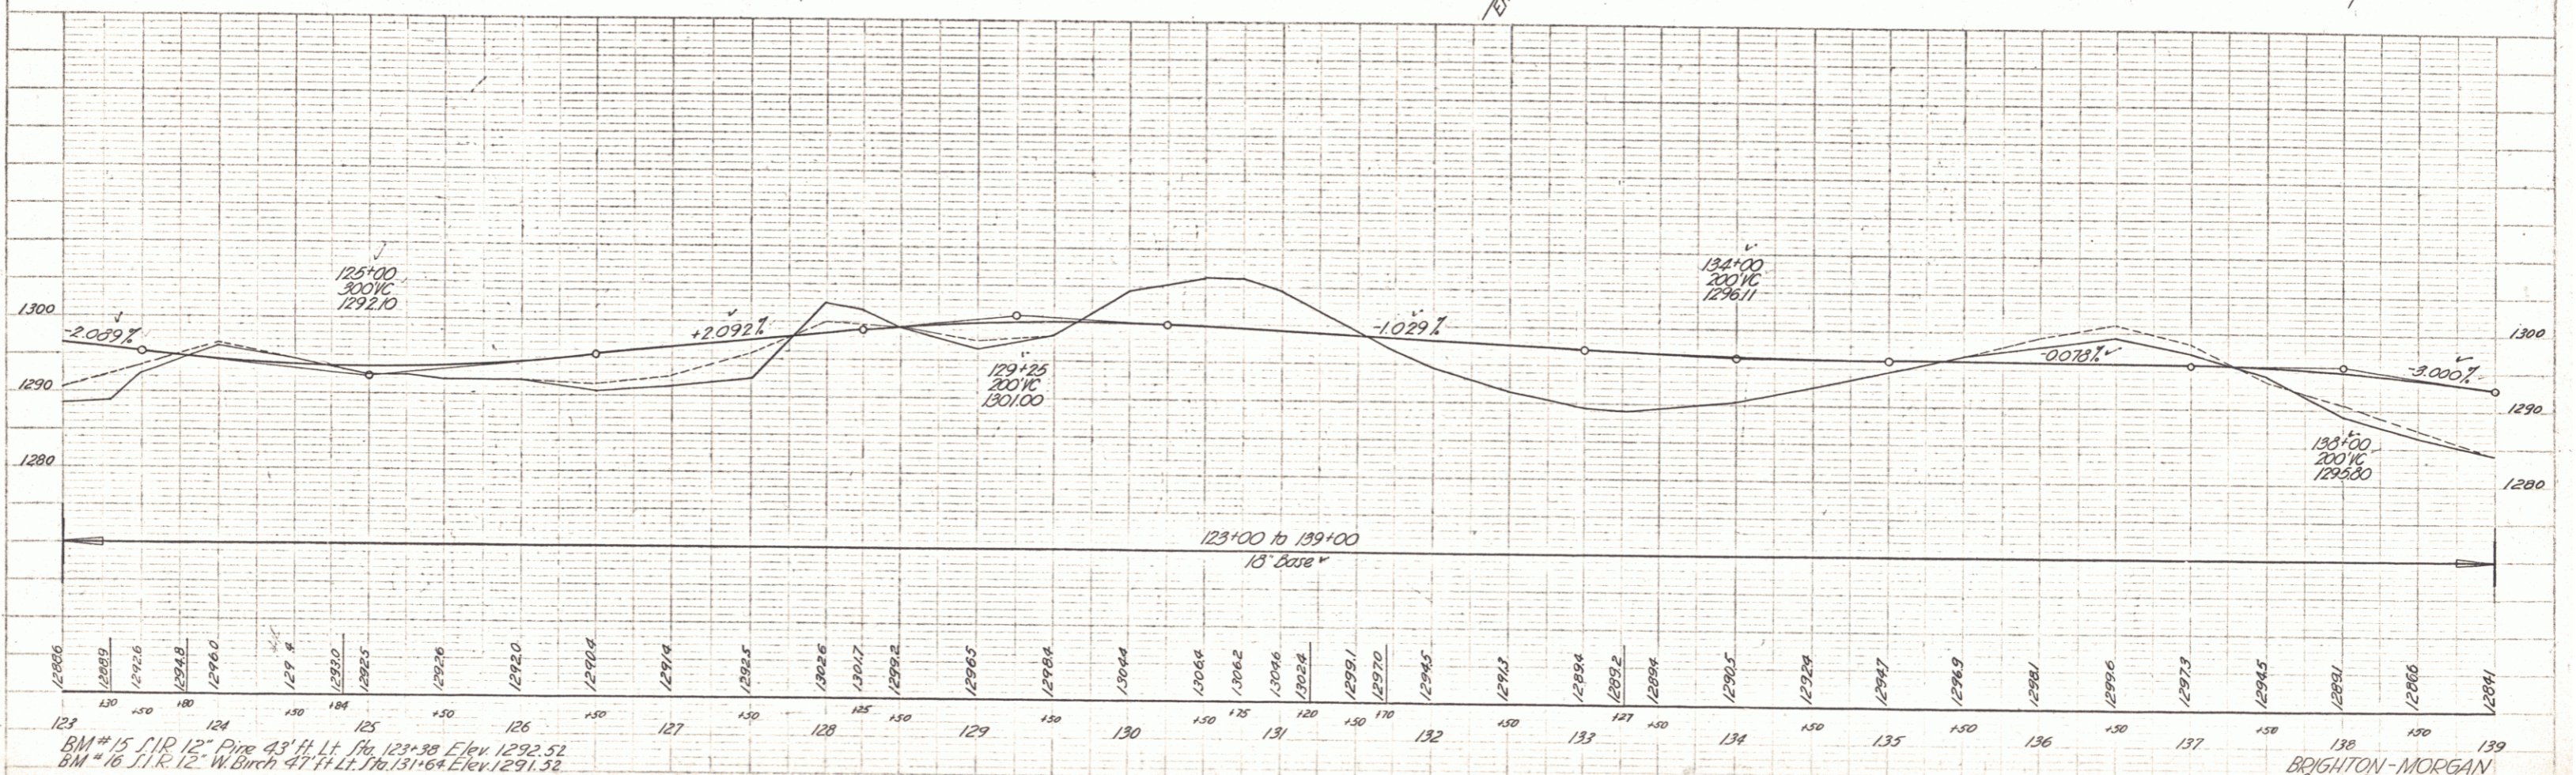

BM # 15 1 1/2" 12" Pine 43' H. Lt. 176 123+30 Elev. 1292.51  
 BM # 16 1 1/2" 12" W Birch 47' H. Lt. 176 131+64 Elev. 1291.32