



FED. ROAD DIST. NO.	STATE	PROJ. NO.	FISCAL YEAR	SHEET NO.	TOTAL SHEETS
9	VT.	270	26	76	

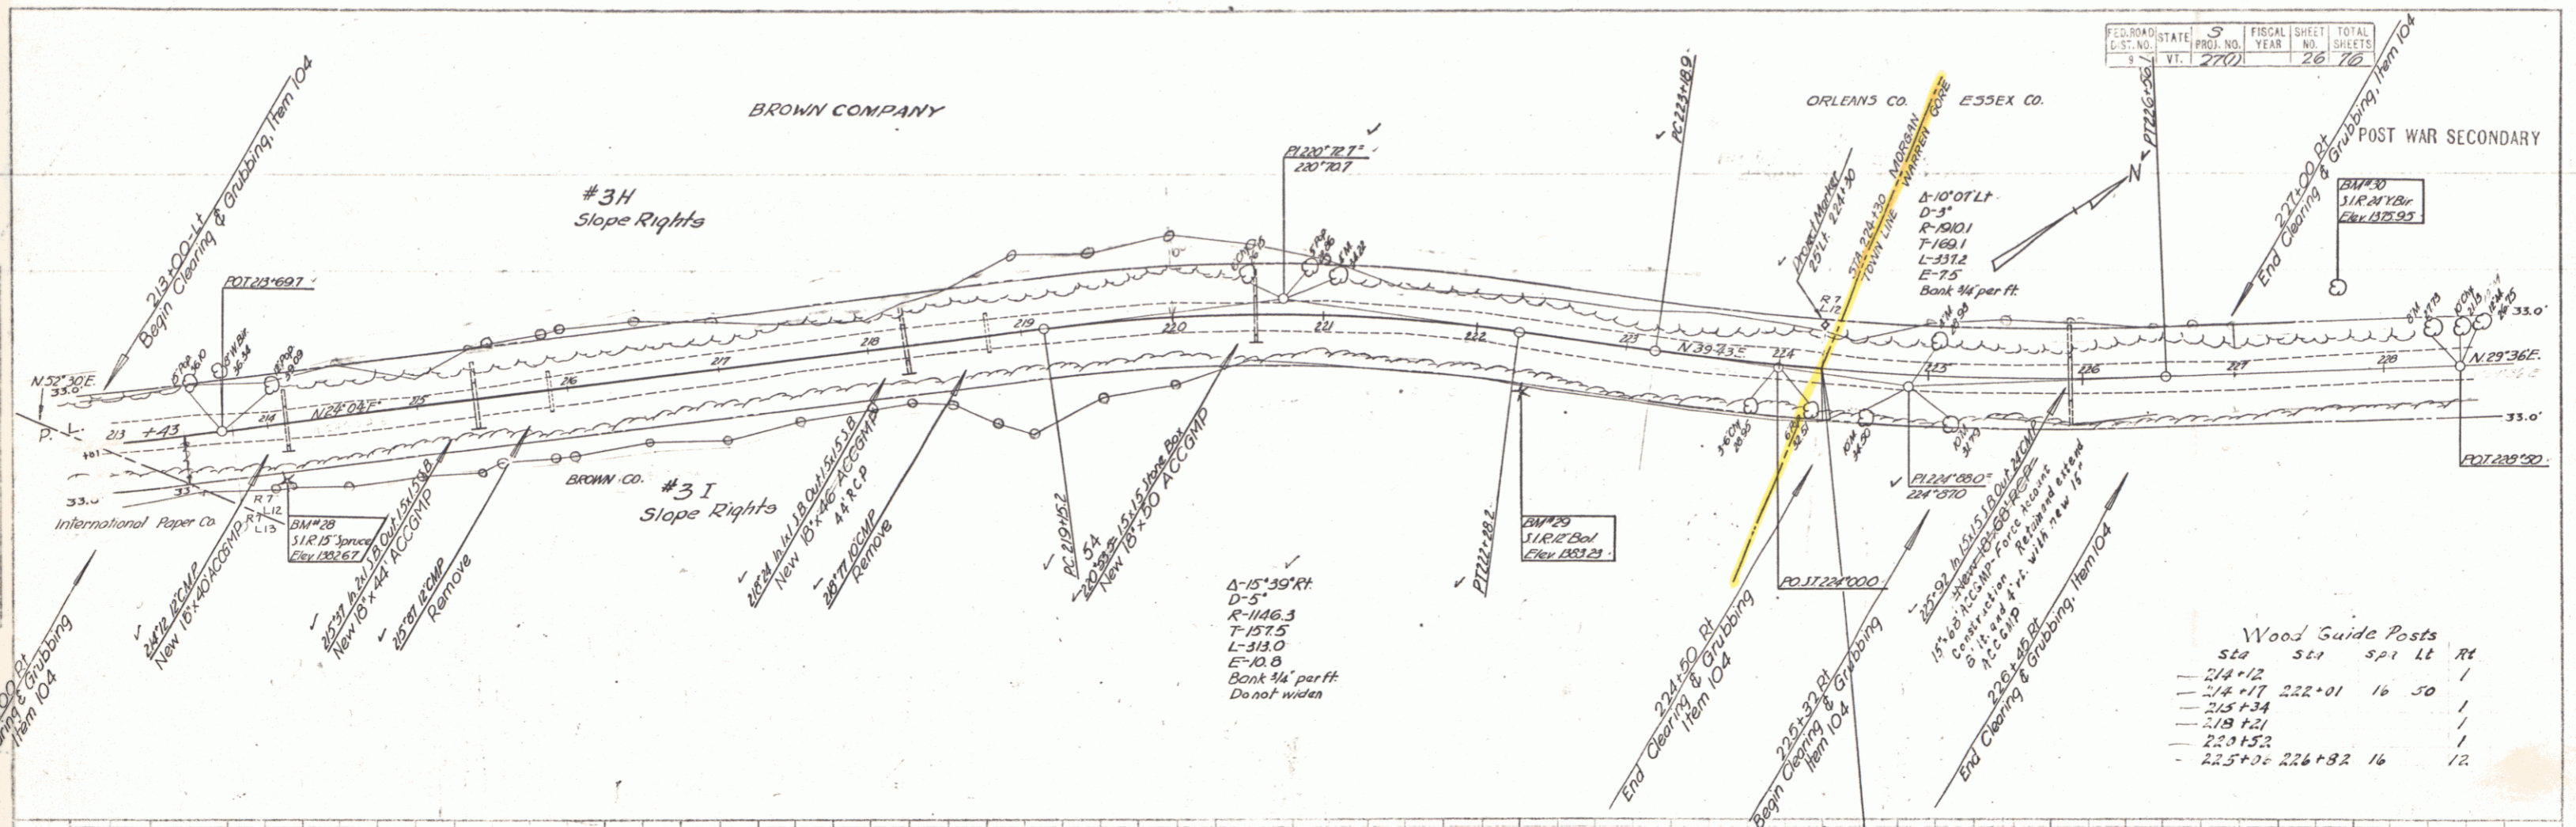

Wood Guide Posts

Sta	Stn	Sp	Lt	Rt
214+12				
214+17	222+01	16	50	
215+34				
218+21				
223+52	226+32	16	12	

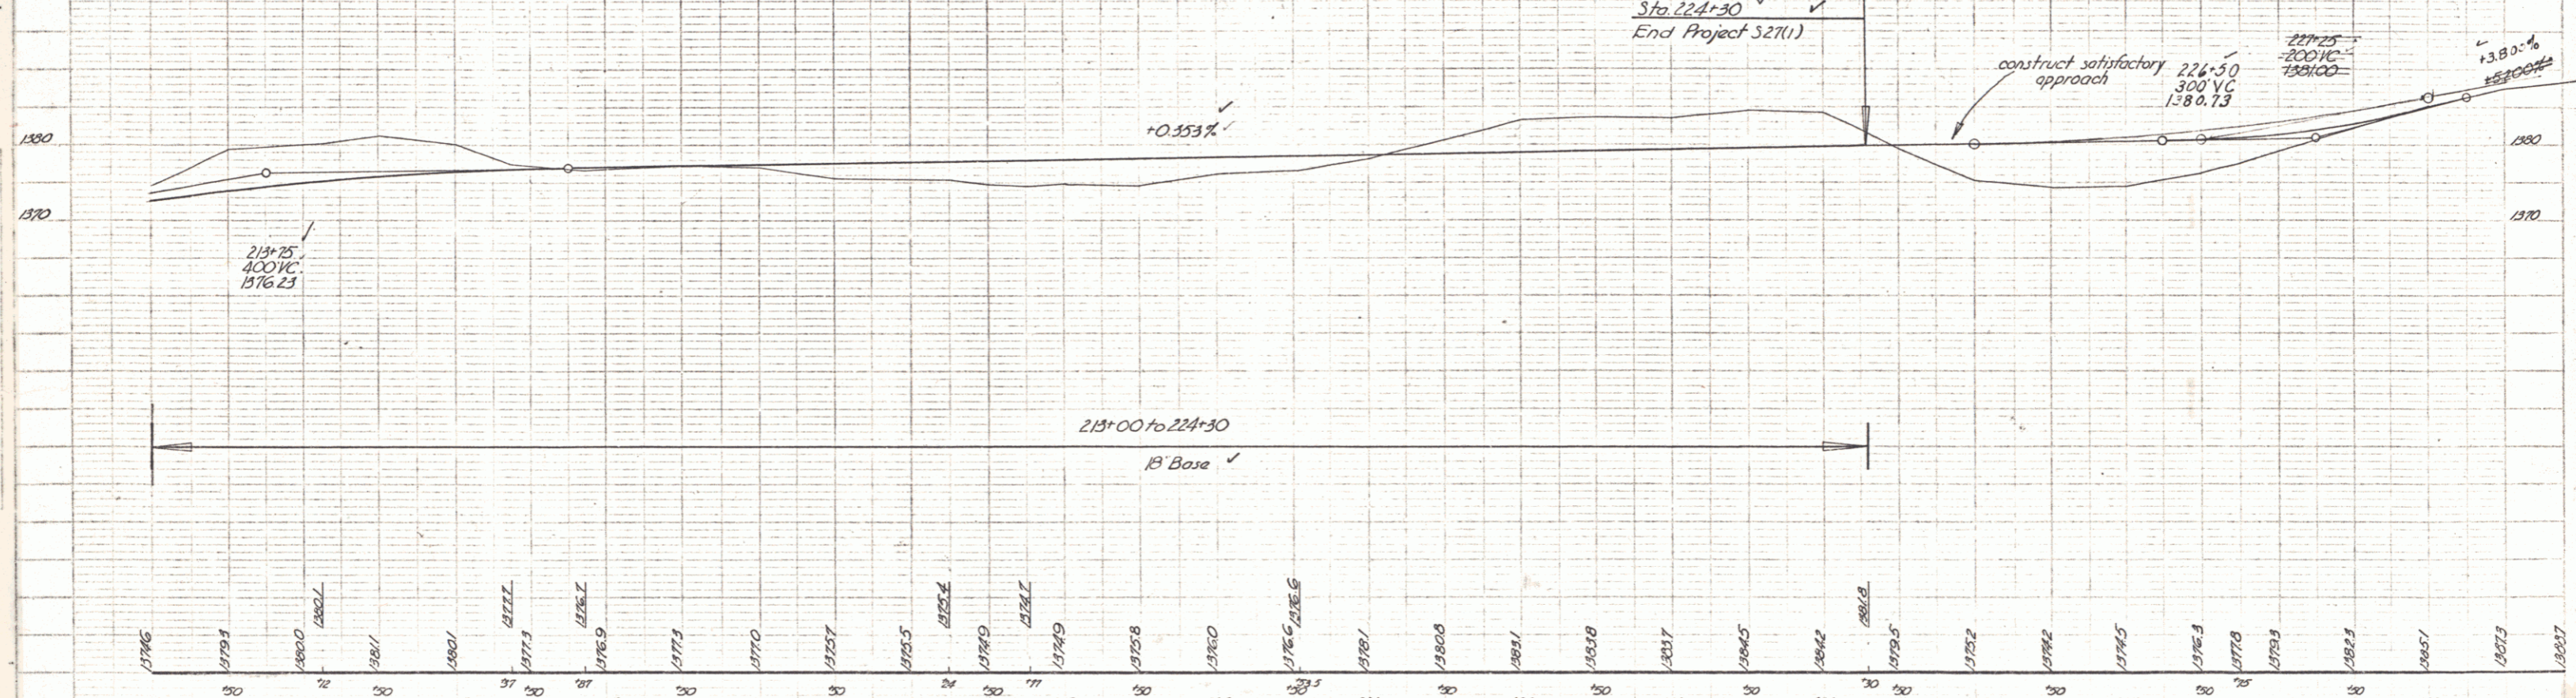

213 B.M. 29 S.R. 12' Bal. 37.5' Rt. Sta. 222+37 El. 1383.25  
 214 B.M. 28 S.R. 15' Spruce 37' Rt. Sta. 214+03 El. 1382.61  
 215 B.M. 30 24' Y.B. 49' Lt. Sta. 221+63 El. 1375.95

BRIGHTON MORGAN  
 Series S No. 270  
 Sheet 26 of 76