


Note
 Const Approach to Drives
 15+80 Lt. 18+80 Ft.
 15+85 Ft. 19+88 Lt. #RT
 17+30 Lt. 20+50 Lt.
 18+00 Lt. 22+00 Ft.
 18+80 Lt. 23+00 Ft.

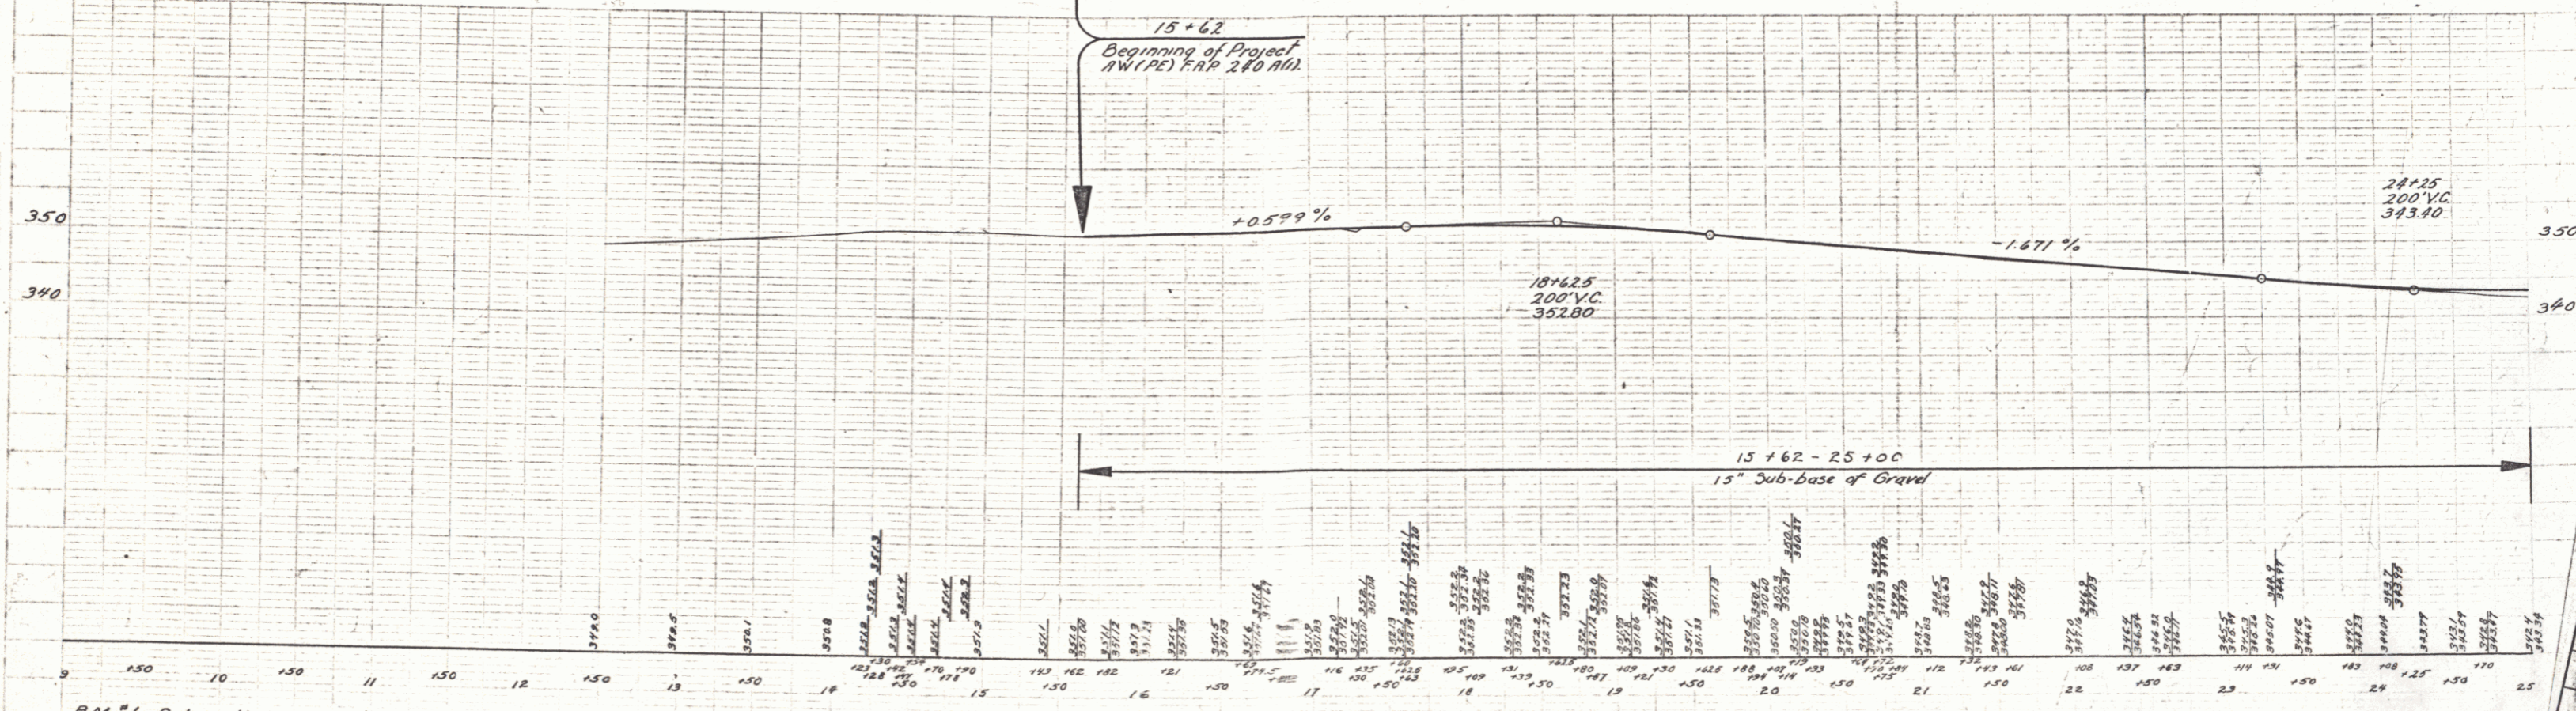

B.M. #1 Bolt on Hydrant 13.5' Lt. Sta. 14+42 Elev. 353.66
 B.M. #2 Bolt on Hydrant 15.5' Rt. Sta. 23+31 Elev. 347.66