
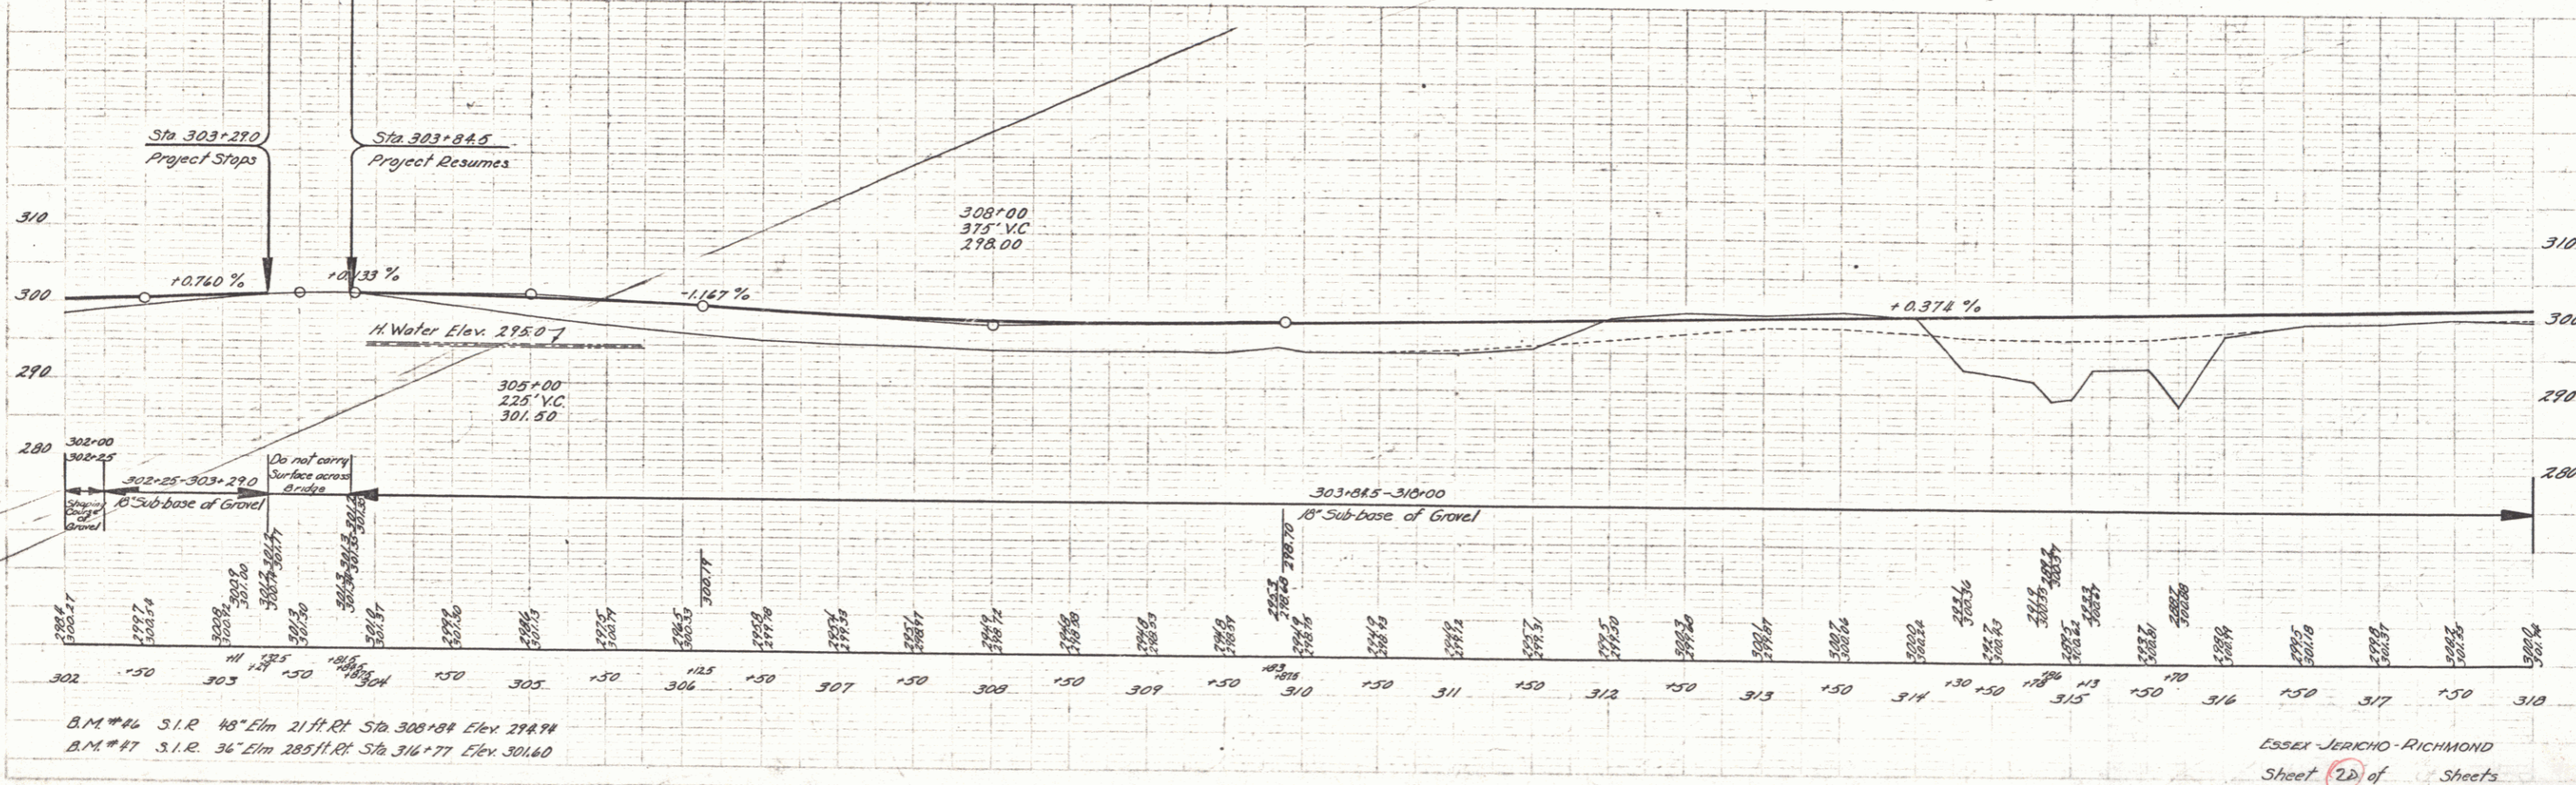


F.D. ROAD DIST. NO.	STATE	F.D. NO.	FISCAL YEAR	SHEET NO.	TOTAL SHEETS
9	VT.				

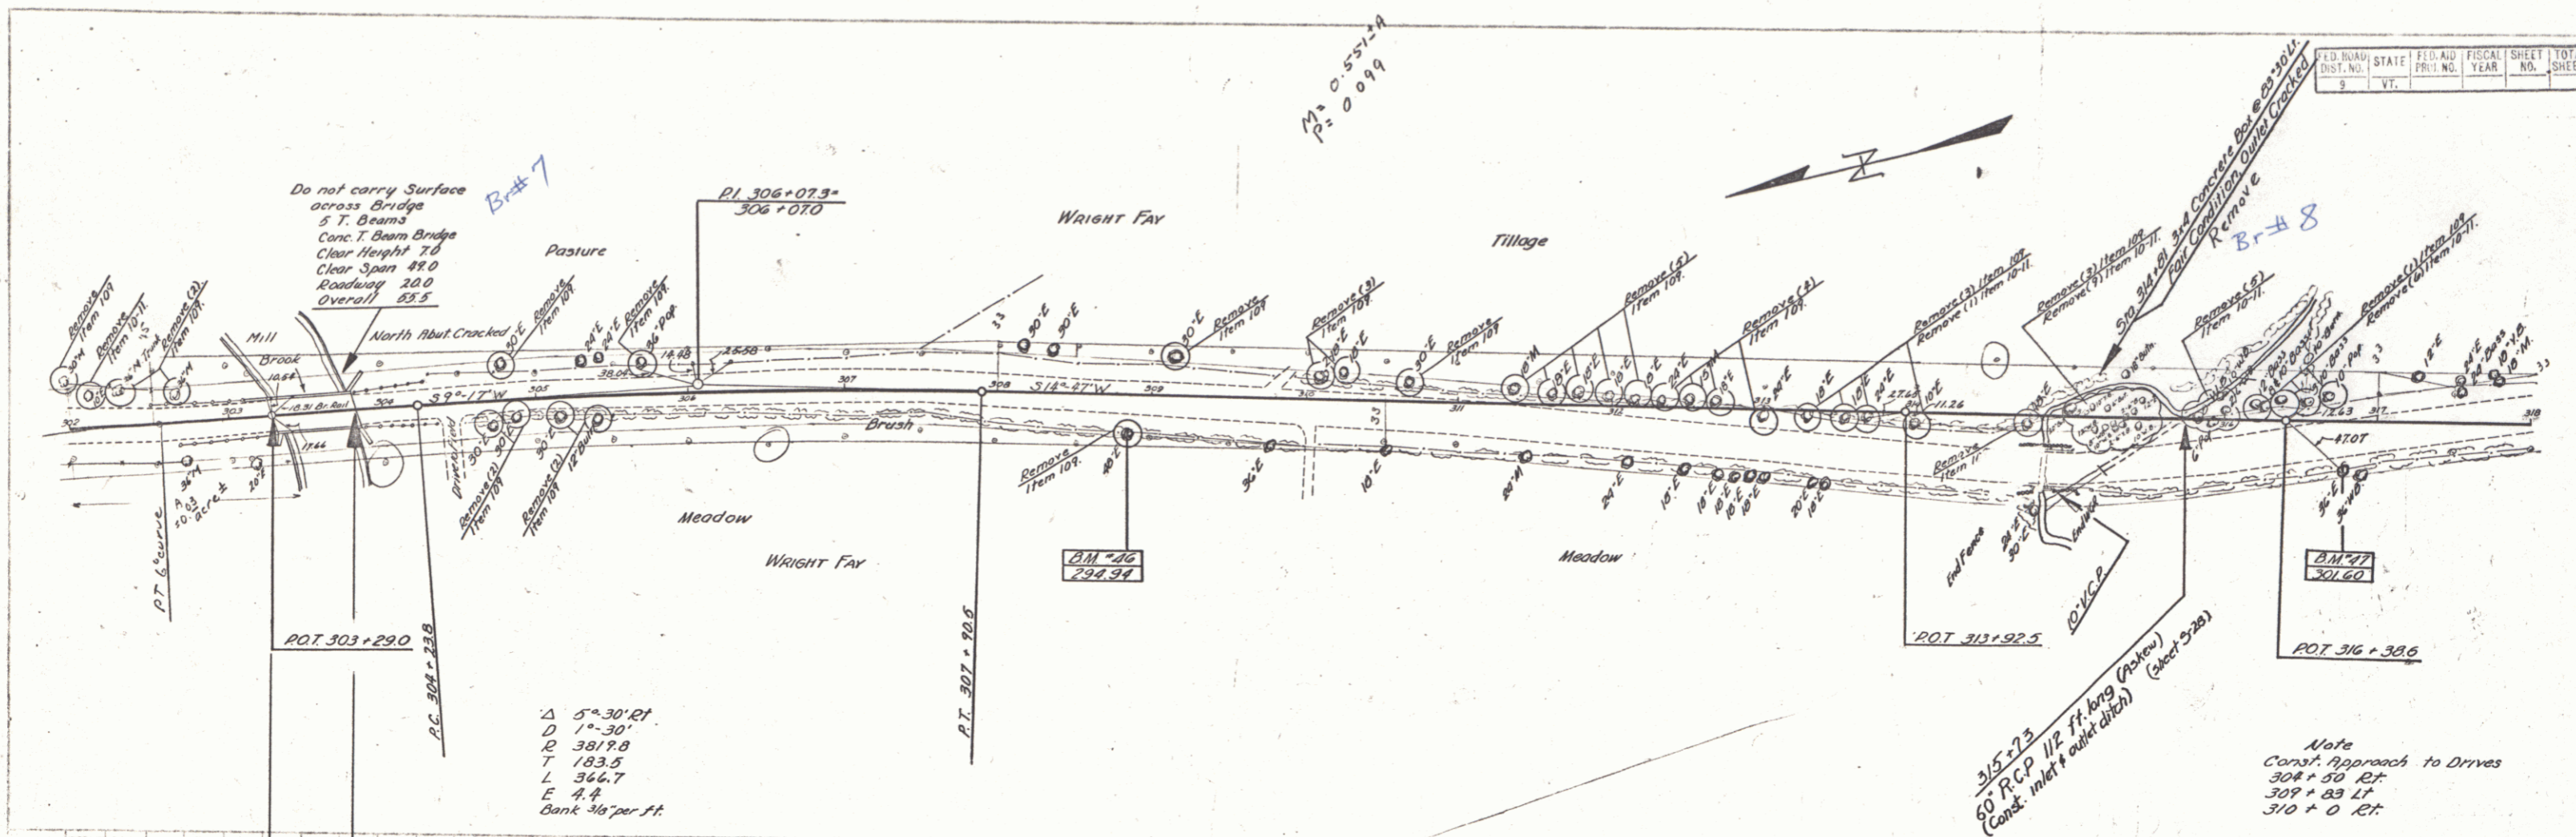

B.M. #46 S.I.R. 48" Elm 21 ft. Rt. Sta. 308+94 Elev. 294.94
 B.M. #47 S.I.R. 36" Elm 285 ft. Rt. Sta. 316+71 Elev. 304.60

Essex JERICHO-RICHMOND
 Sheet 20 of 20