
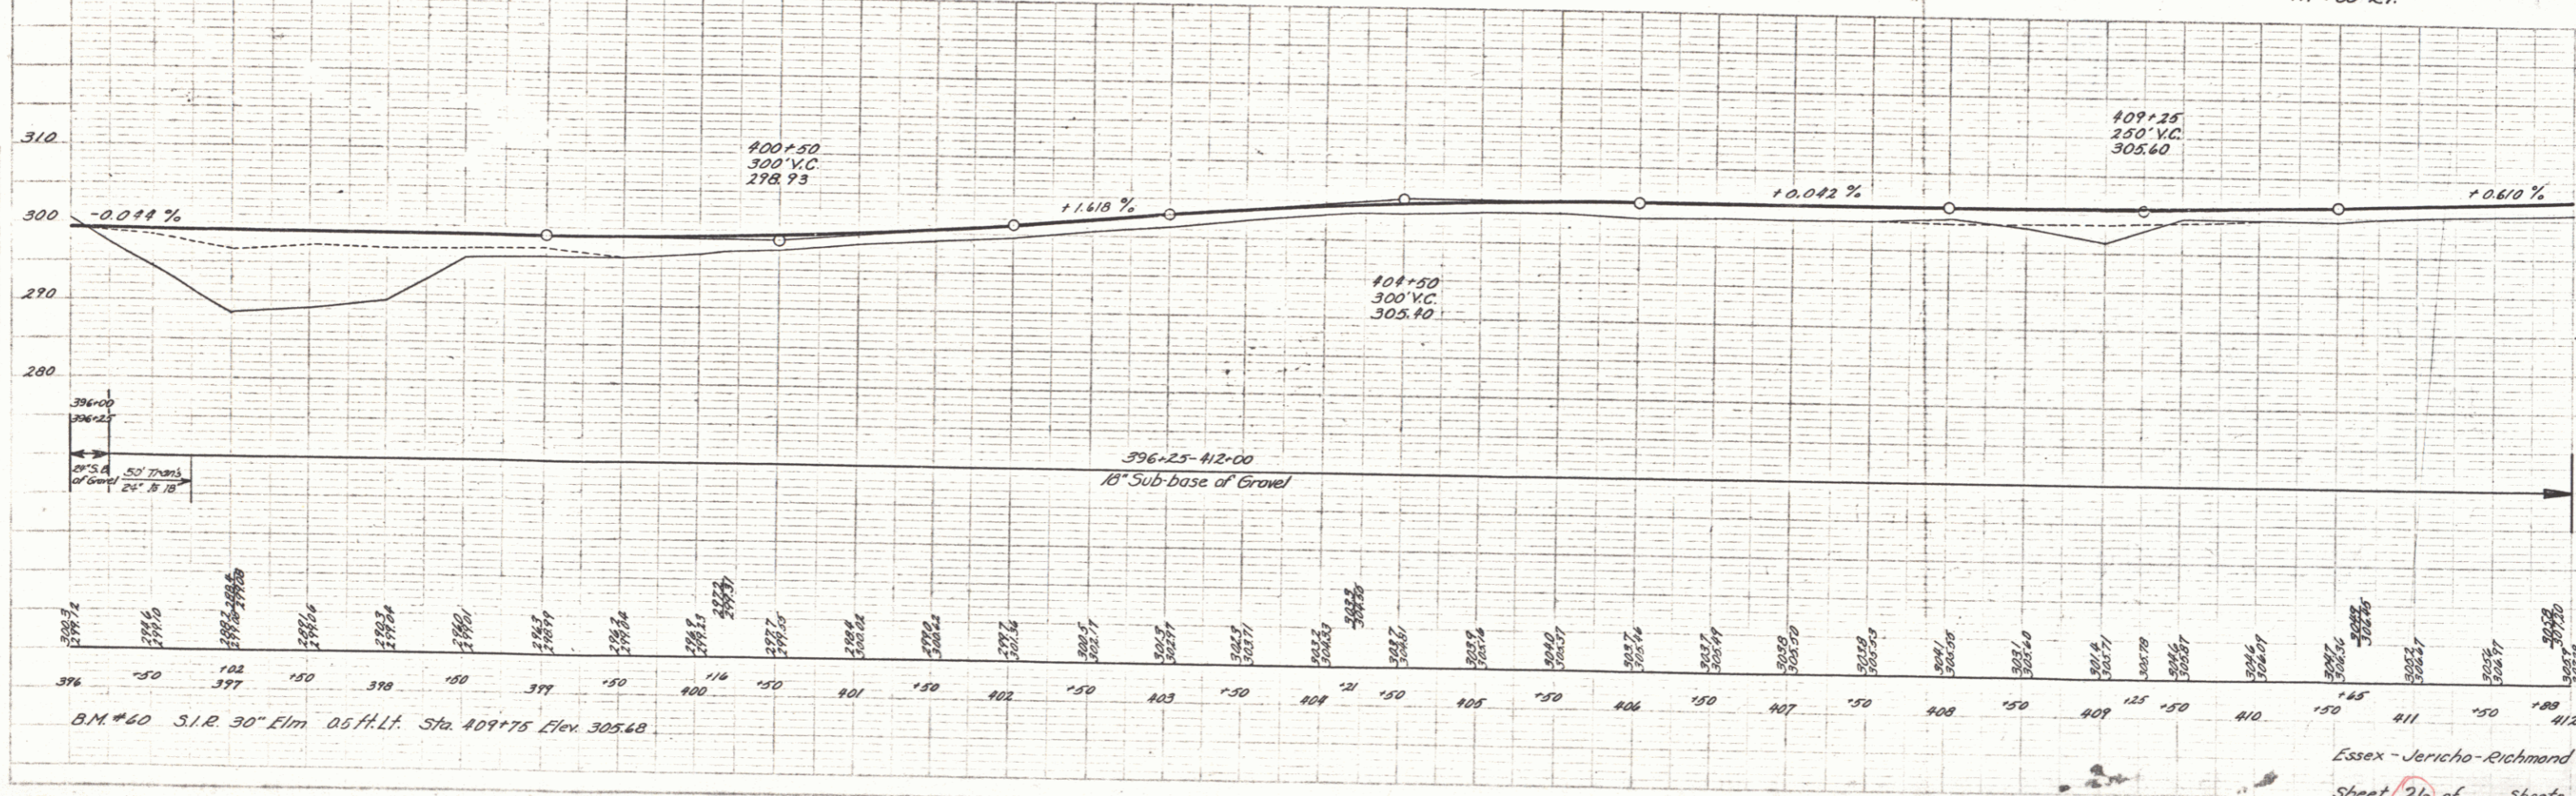


| FED. ROAD DIST. NO. | STATE | FED. AID TR. NO. | FISCAL YEAR | SHEET NO. | TOTAL SHEETS |
|---------------------|-------|------------------|-------------|-----------|--------------|
| 9 | VT. | | | | |

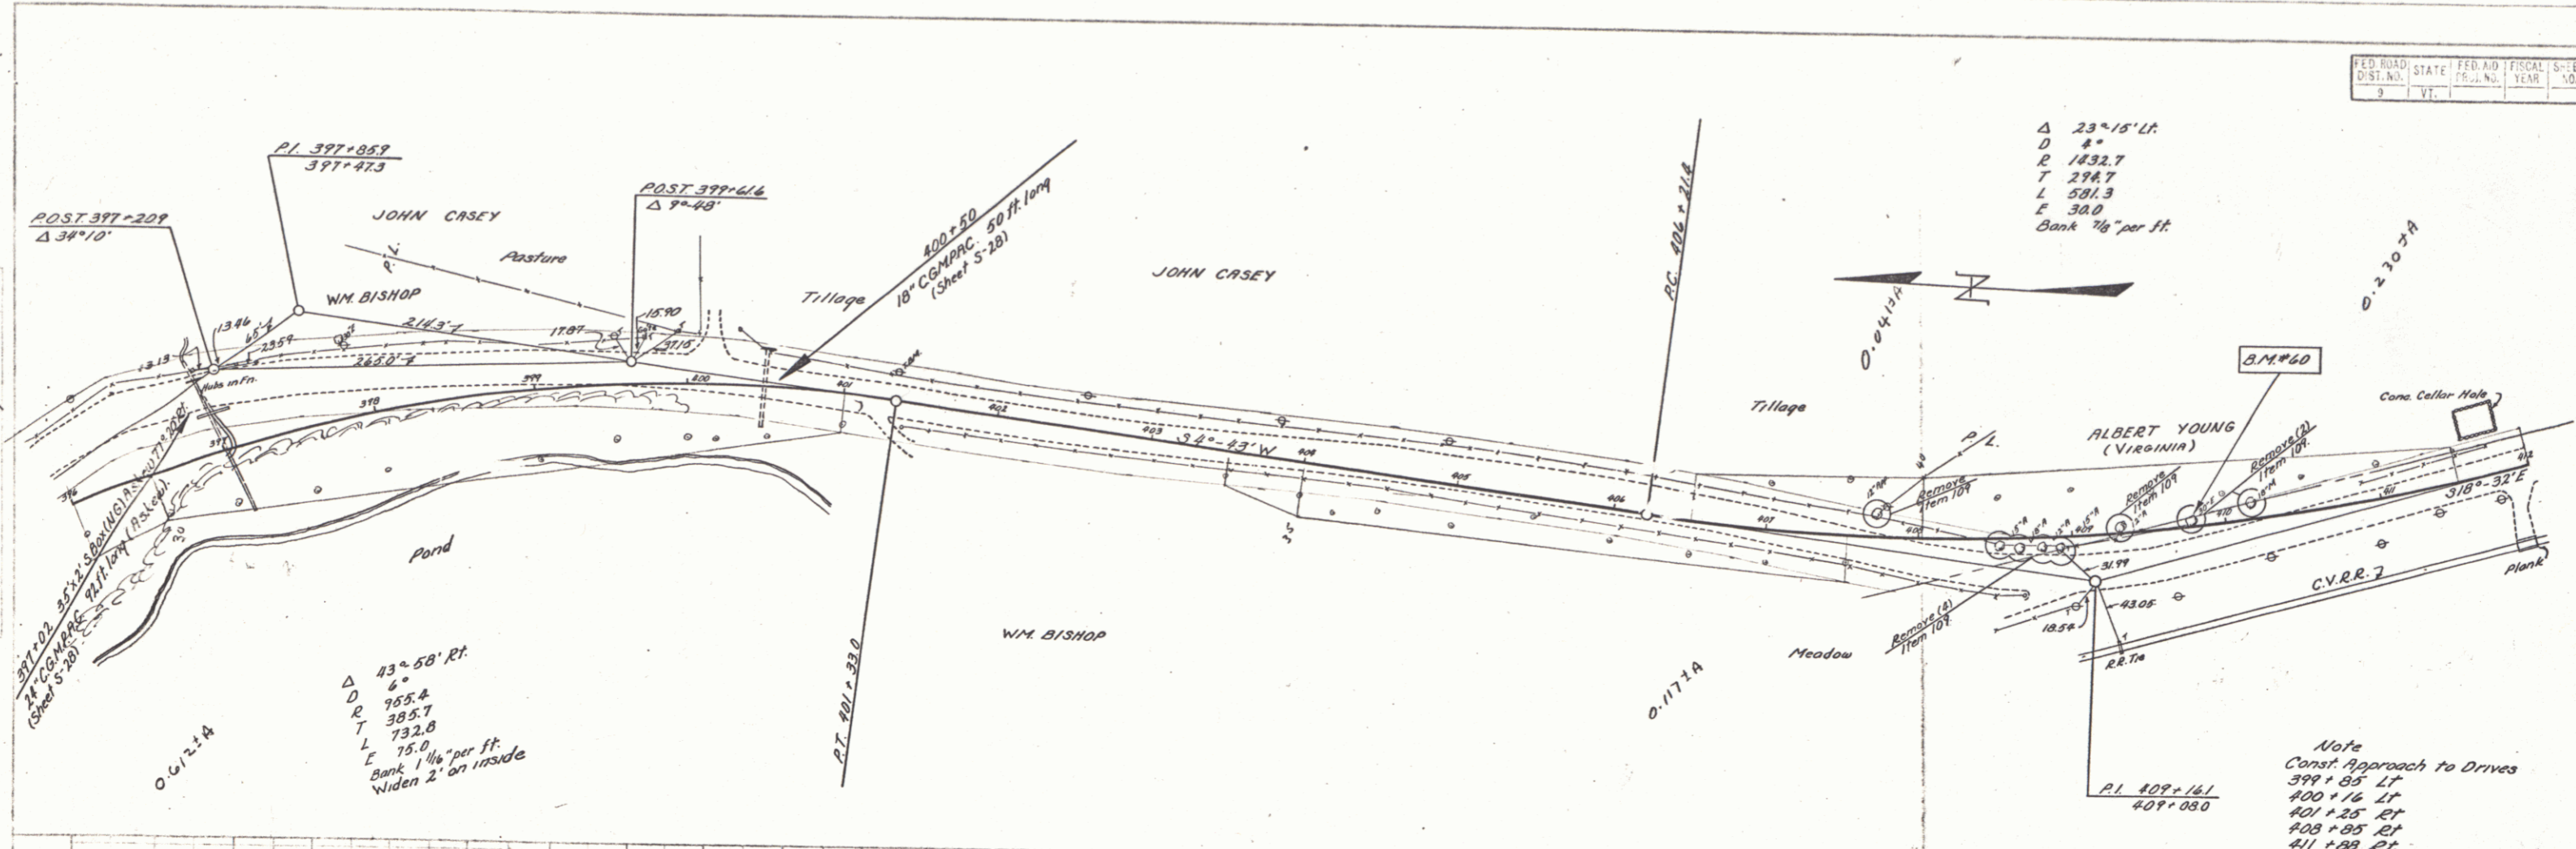

B.M. #60 S.I.R. 30" Elm 06 ft. Lt. Sta. 409+75 Elev. 305.68

Essex - Jericho - Richmond
Sheet 26 of Sheets