
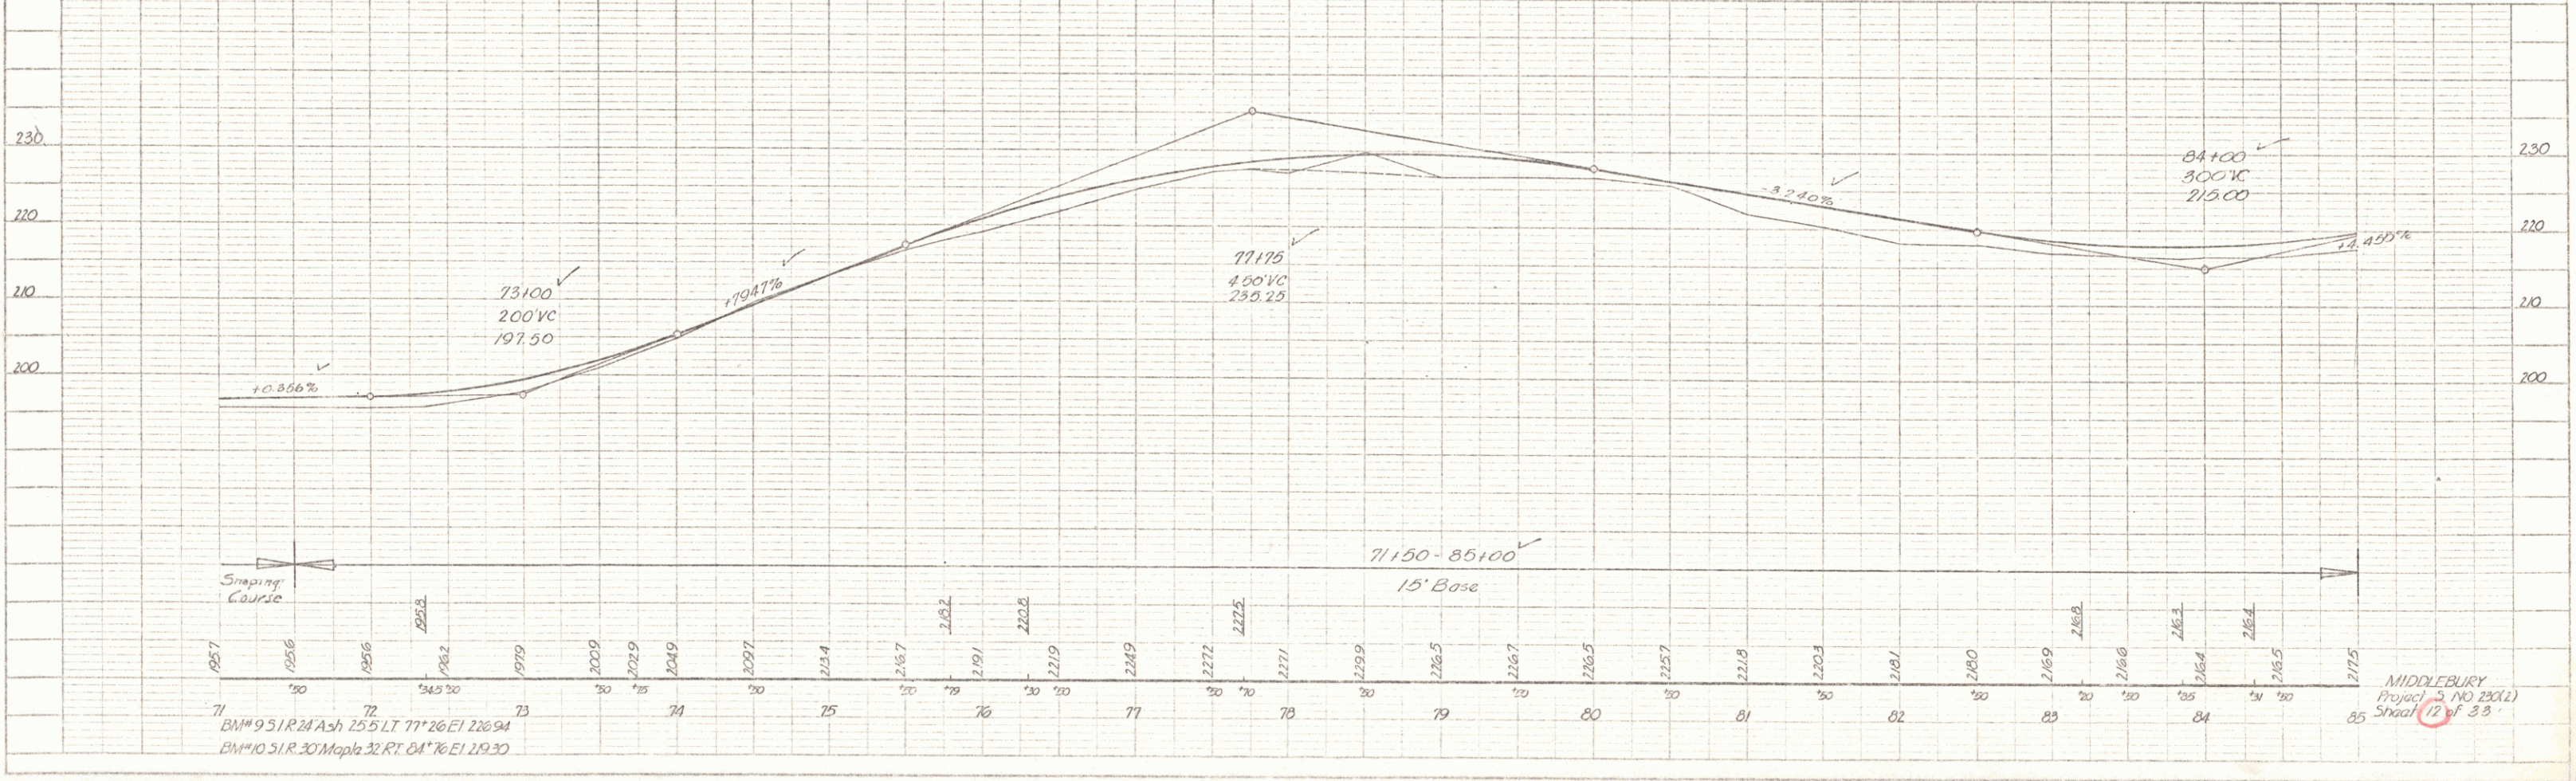


PLAN
 DATE: 6/20/18
 DRAWN BY: [Name]
 CHECKED BY: [Name]
 PROJECT: [Name]

PROFILE
 DATE: 6/20/18
 DRAWN BY: [Name]
 CHECKED BY: [Name]
 PROJECT: [Name]

CONSTRUCT DRIVES
 LI PI
 73+00 72+50'
 83+85 83+20'
 77+30 77+00

Wave Guide Posts	LT	RT
72+34.0	1	1
73+15	6	6
77+43	1	1
82+80	28	1
84+31		1
84+00 - 88+00	25	

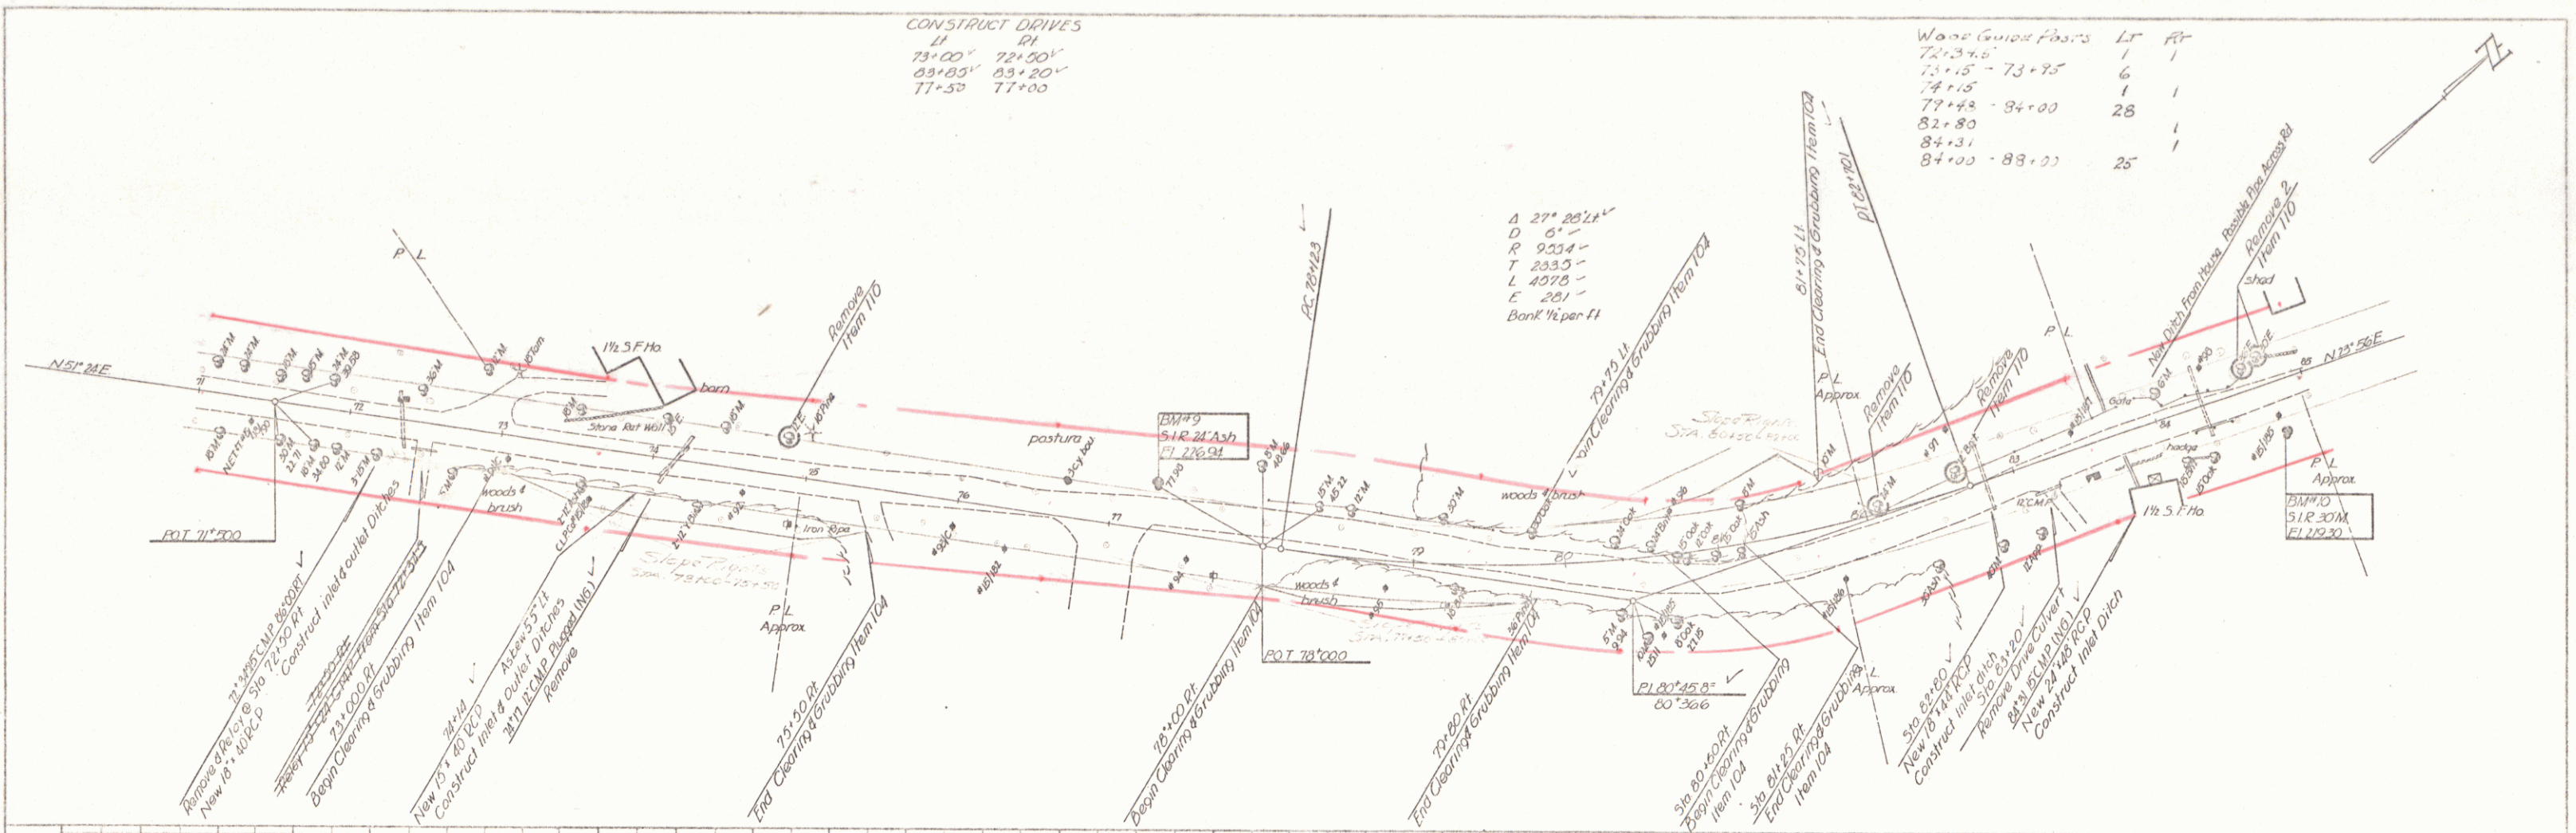

MIDDLEBURY
 Project 3 NO 250(2)
 Sheet 12 of 38