
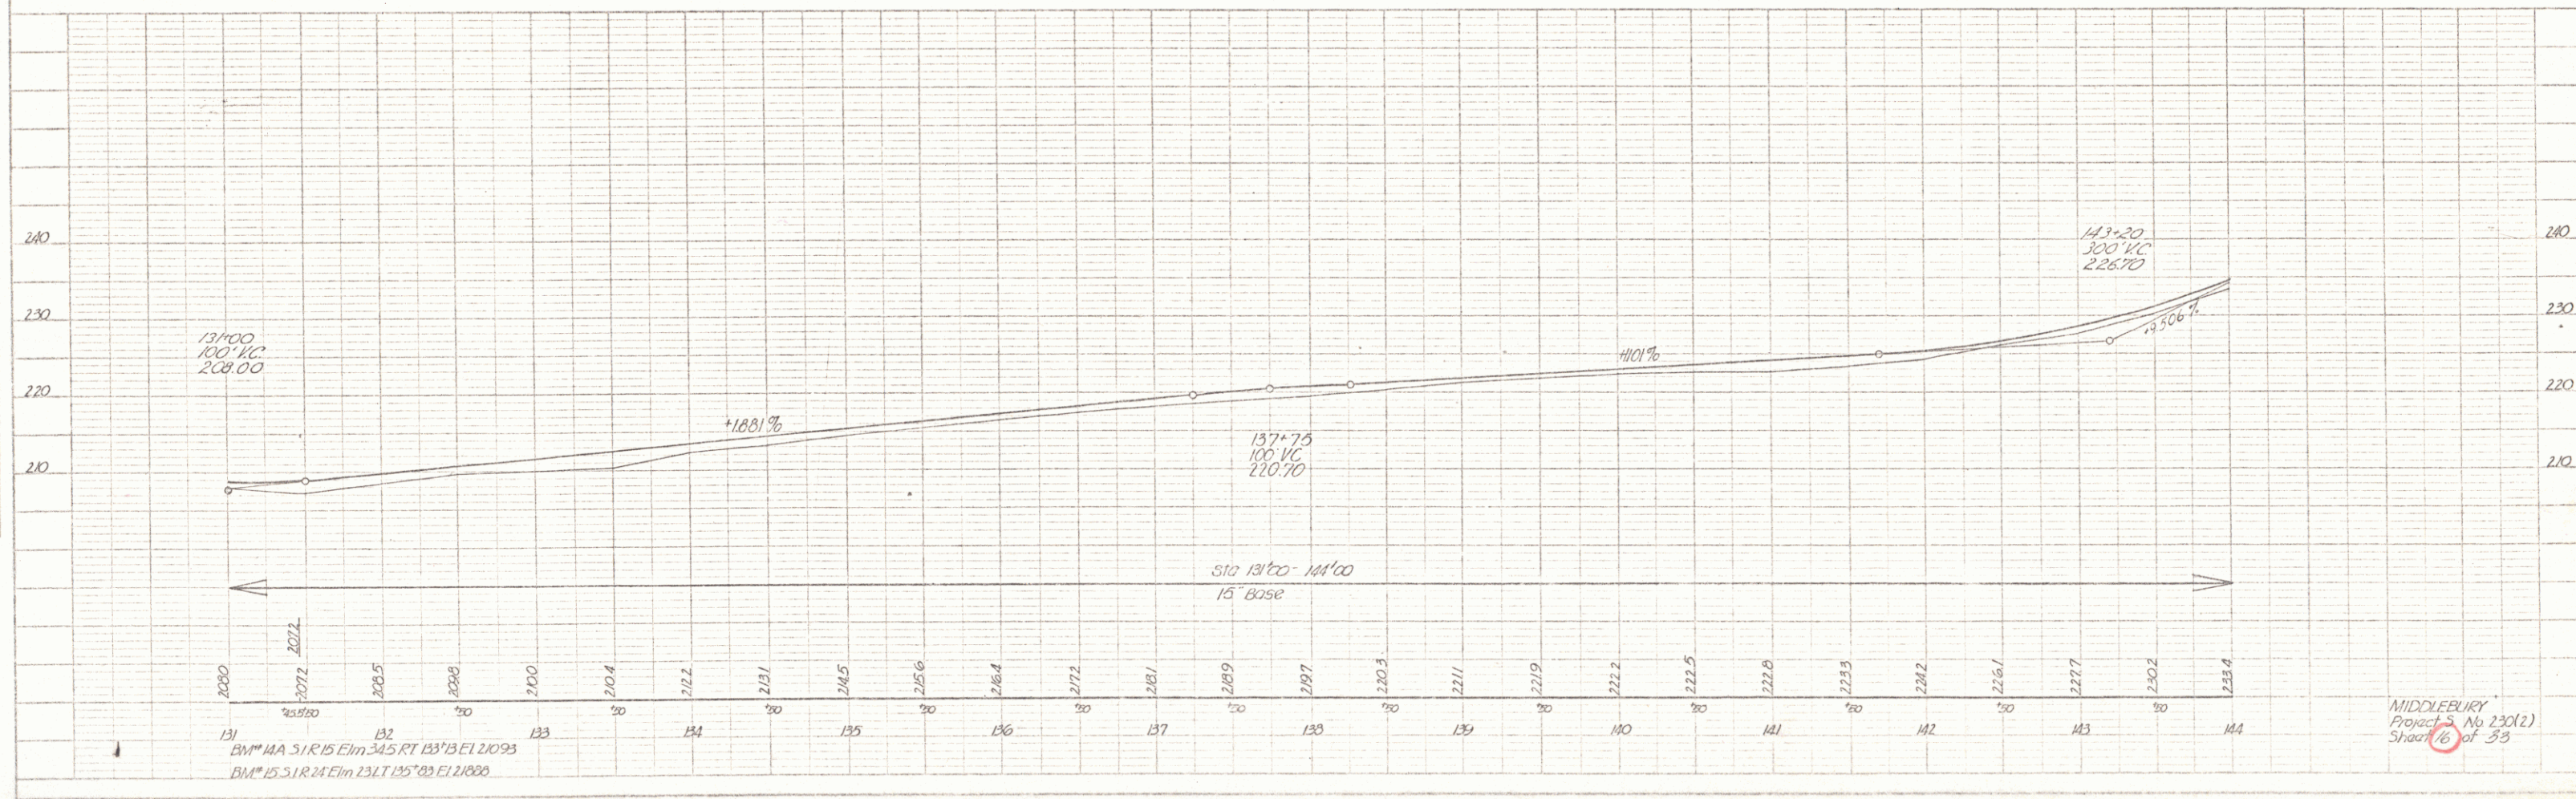


PLAN	DATE	BY
PROJECT		
SCALE		
TRACED BY		

PROFILE	DATE	BY
PROJECT		
SCALE		
TRACED BY		

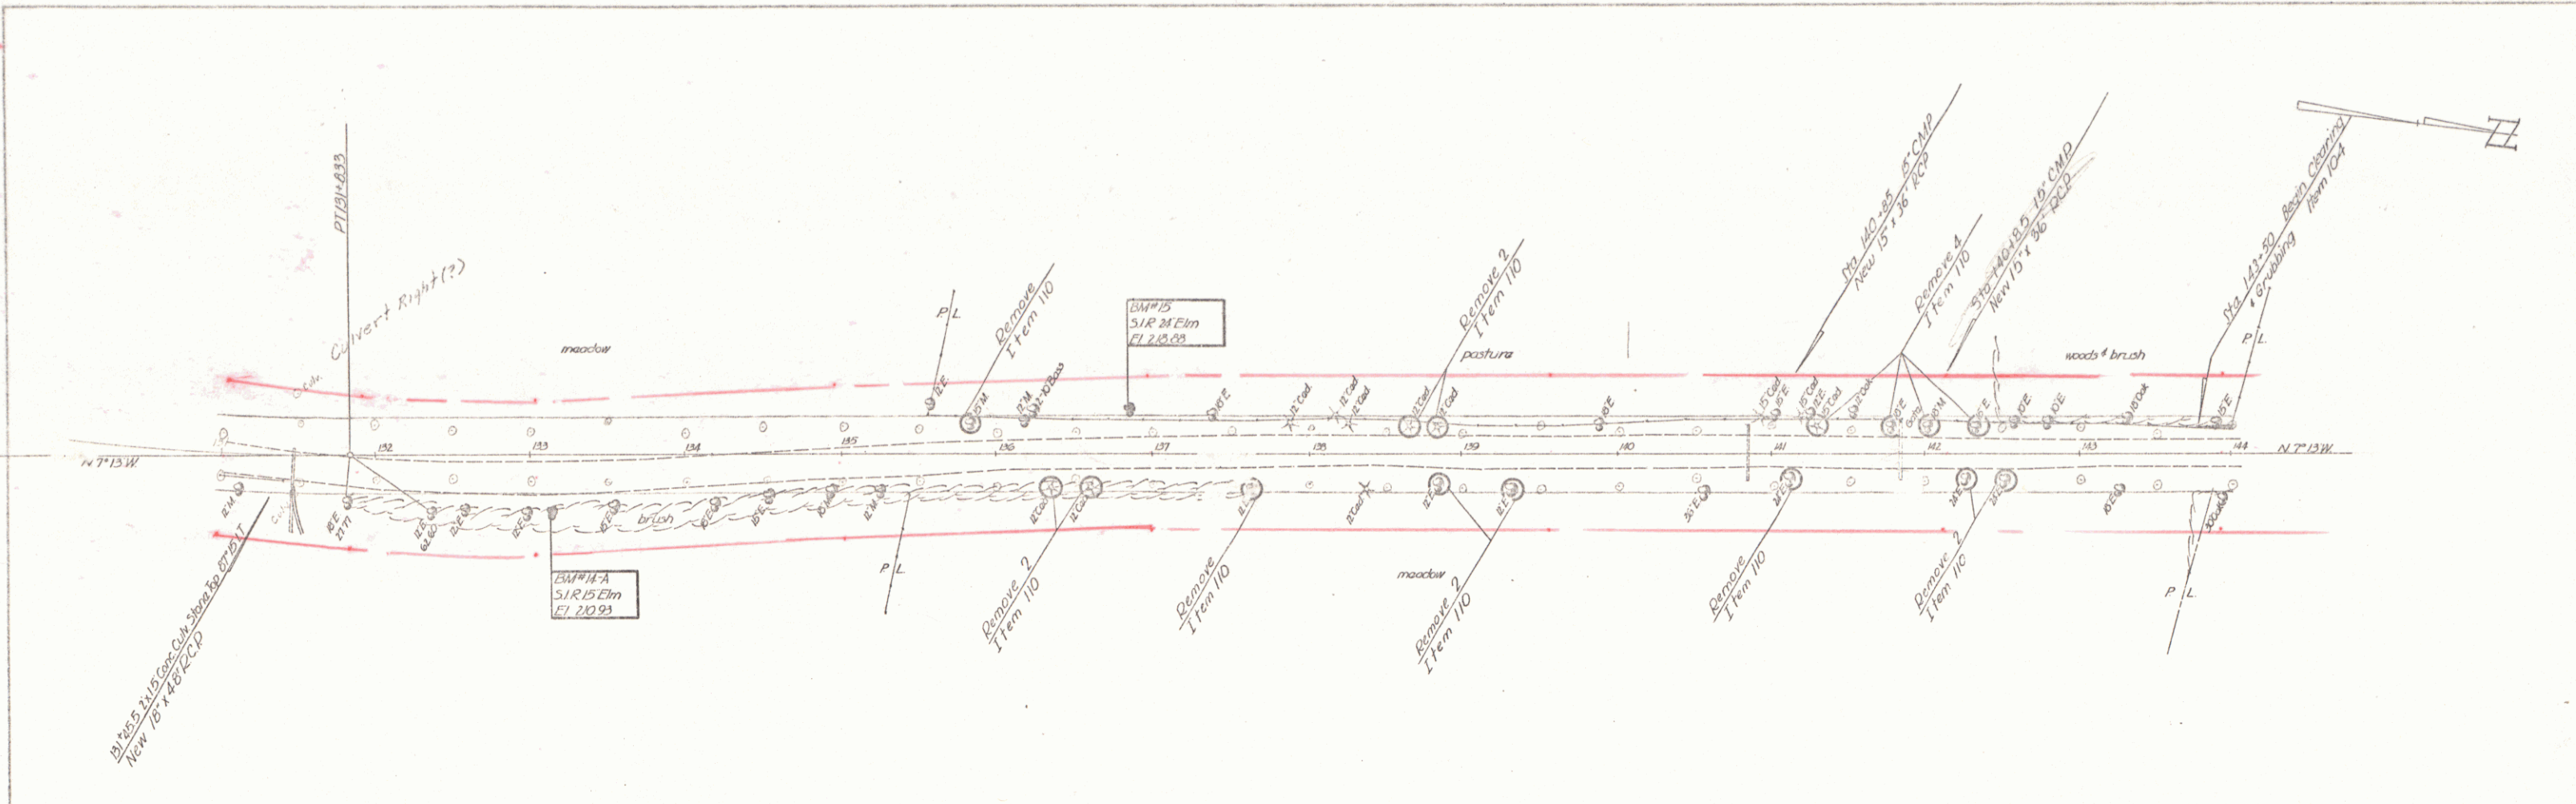

MIDDLEBURY
 Project No. 230(2)
 Sheet 16 of 33