

PLAN	DATE	BY
REVISIONS		
1	1/15/24	W. J. ...
2	2/15/24	W. J. ...
3	3/15/24	W. J. ...
4	4/15/24	W. J. ...
5	5/15/24	W. J. ...

PROFILE	DATE	BY
REVISIONS		
1	1/15/24	W. J. ...
2	2/15/24	W. J. ...
3	3/15/24	W. J. ...
4	4/15/24	W. J. ...
5	5/15/24	W. J. ...

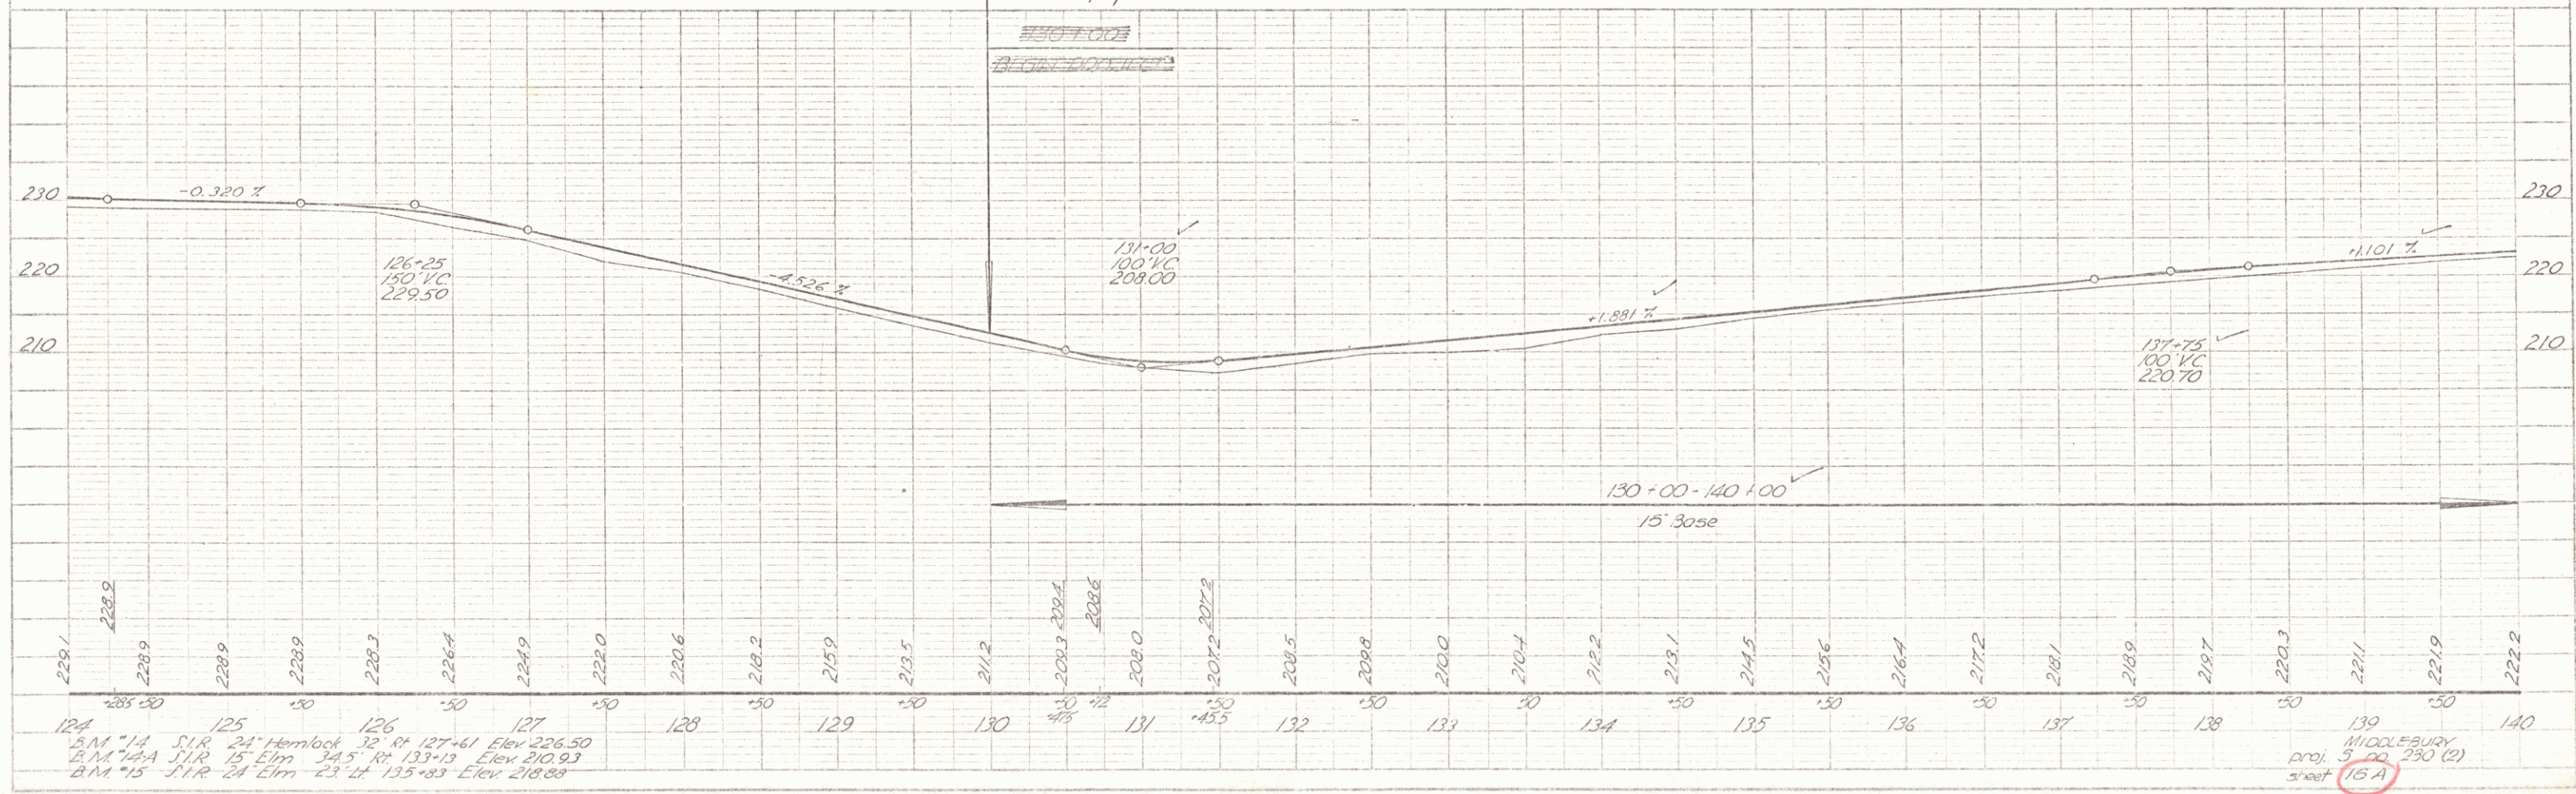
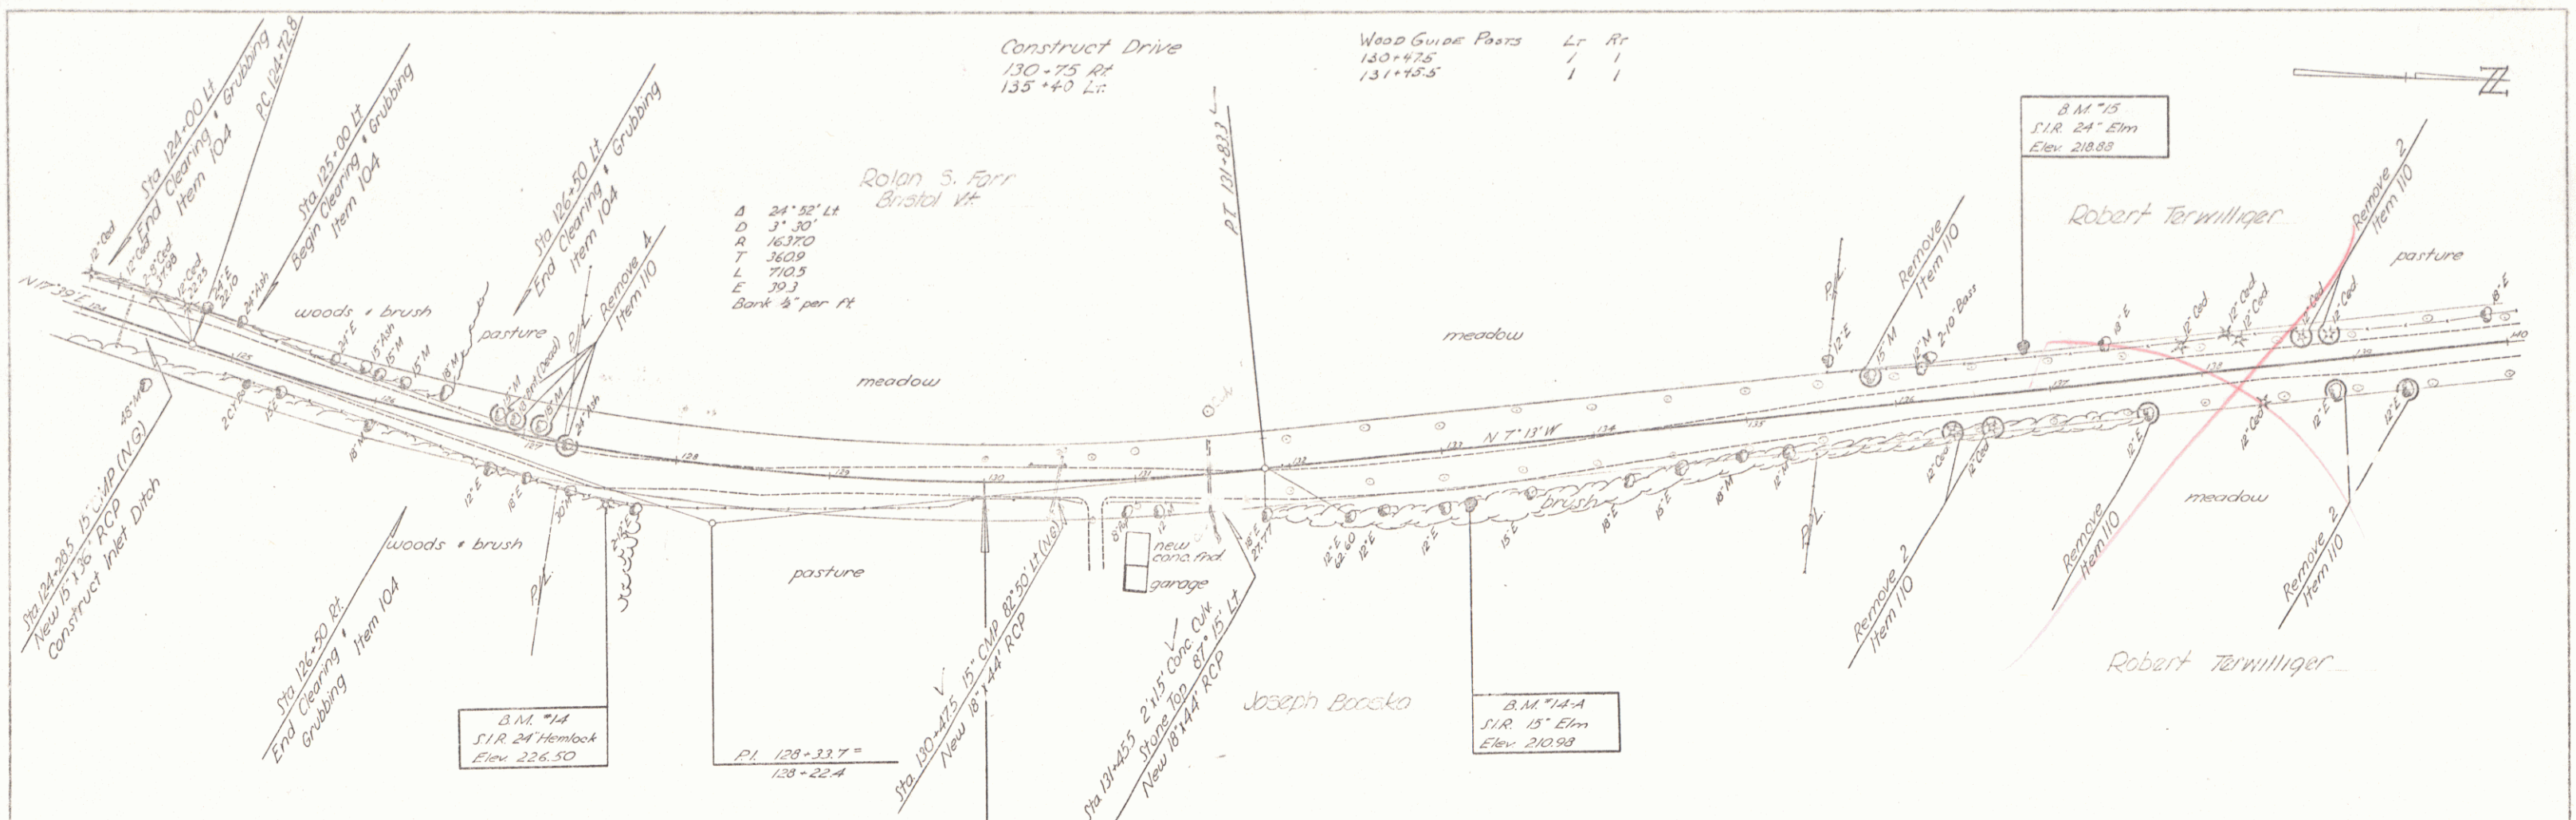


PLATE 1 - PLAN PROFILE & CROSS SECTIONS  
 DRAWN BY: W. J. ...  
 CHECKED BY: W. J. ...  
 DATE: 1/15/24