
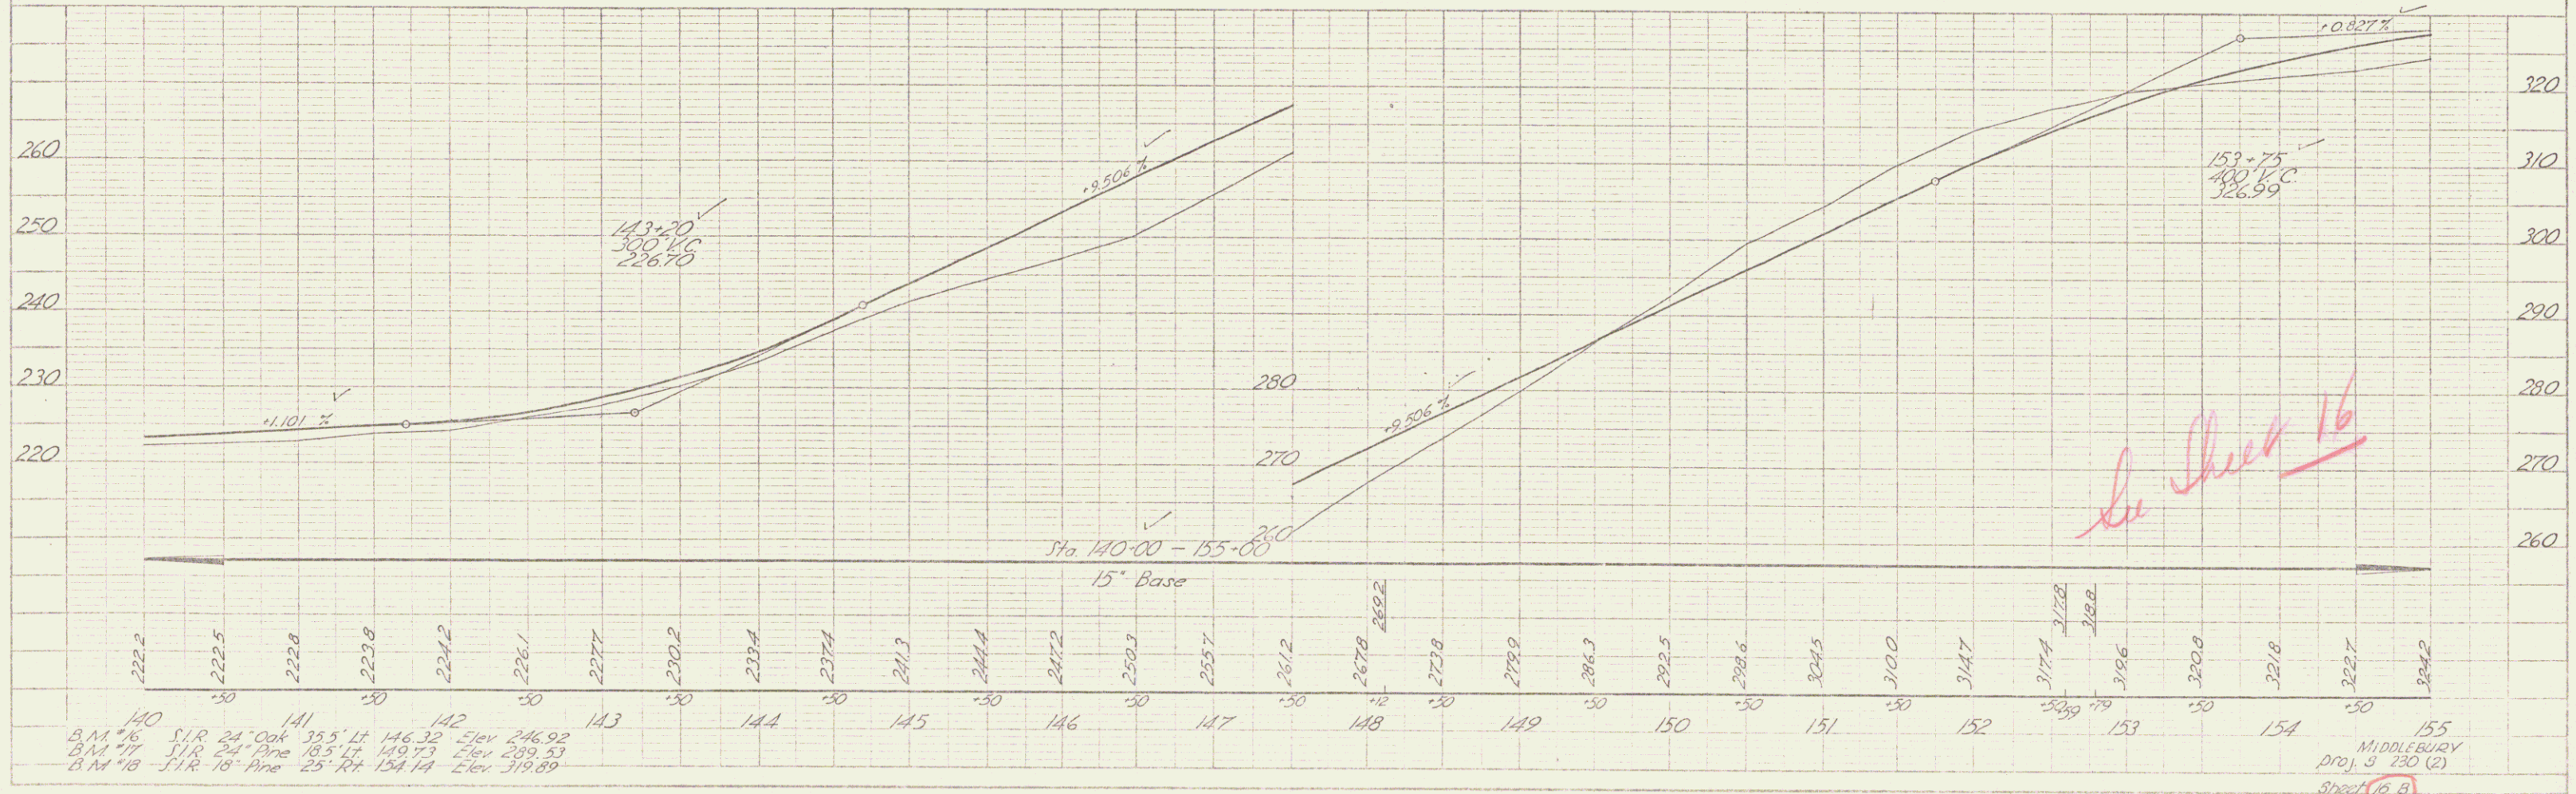


PLAN	DATE	BY
DESIGN	1/15	W.P.
CHECKED	1/15	H.M.
APPROVED	1/15	H.M.

PROJECT	DATE	BY
DESIGN	1/15	W.P.
CHECKED	1/15	H.M.
APPROVED	1/15	H.M.

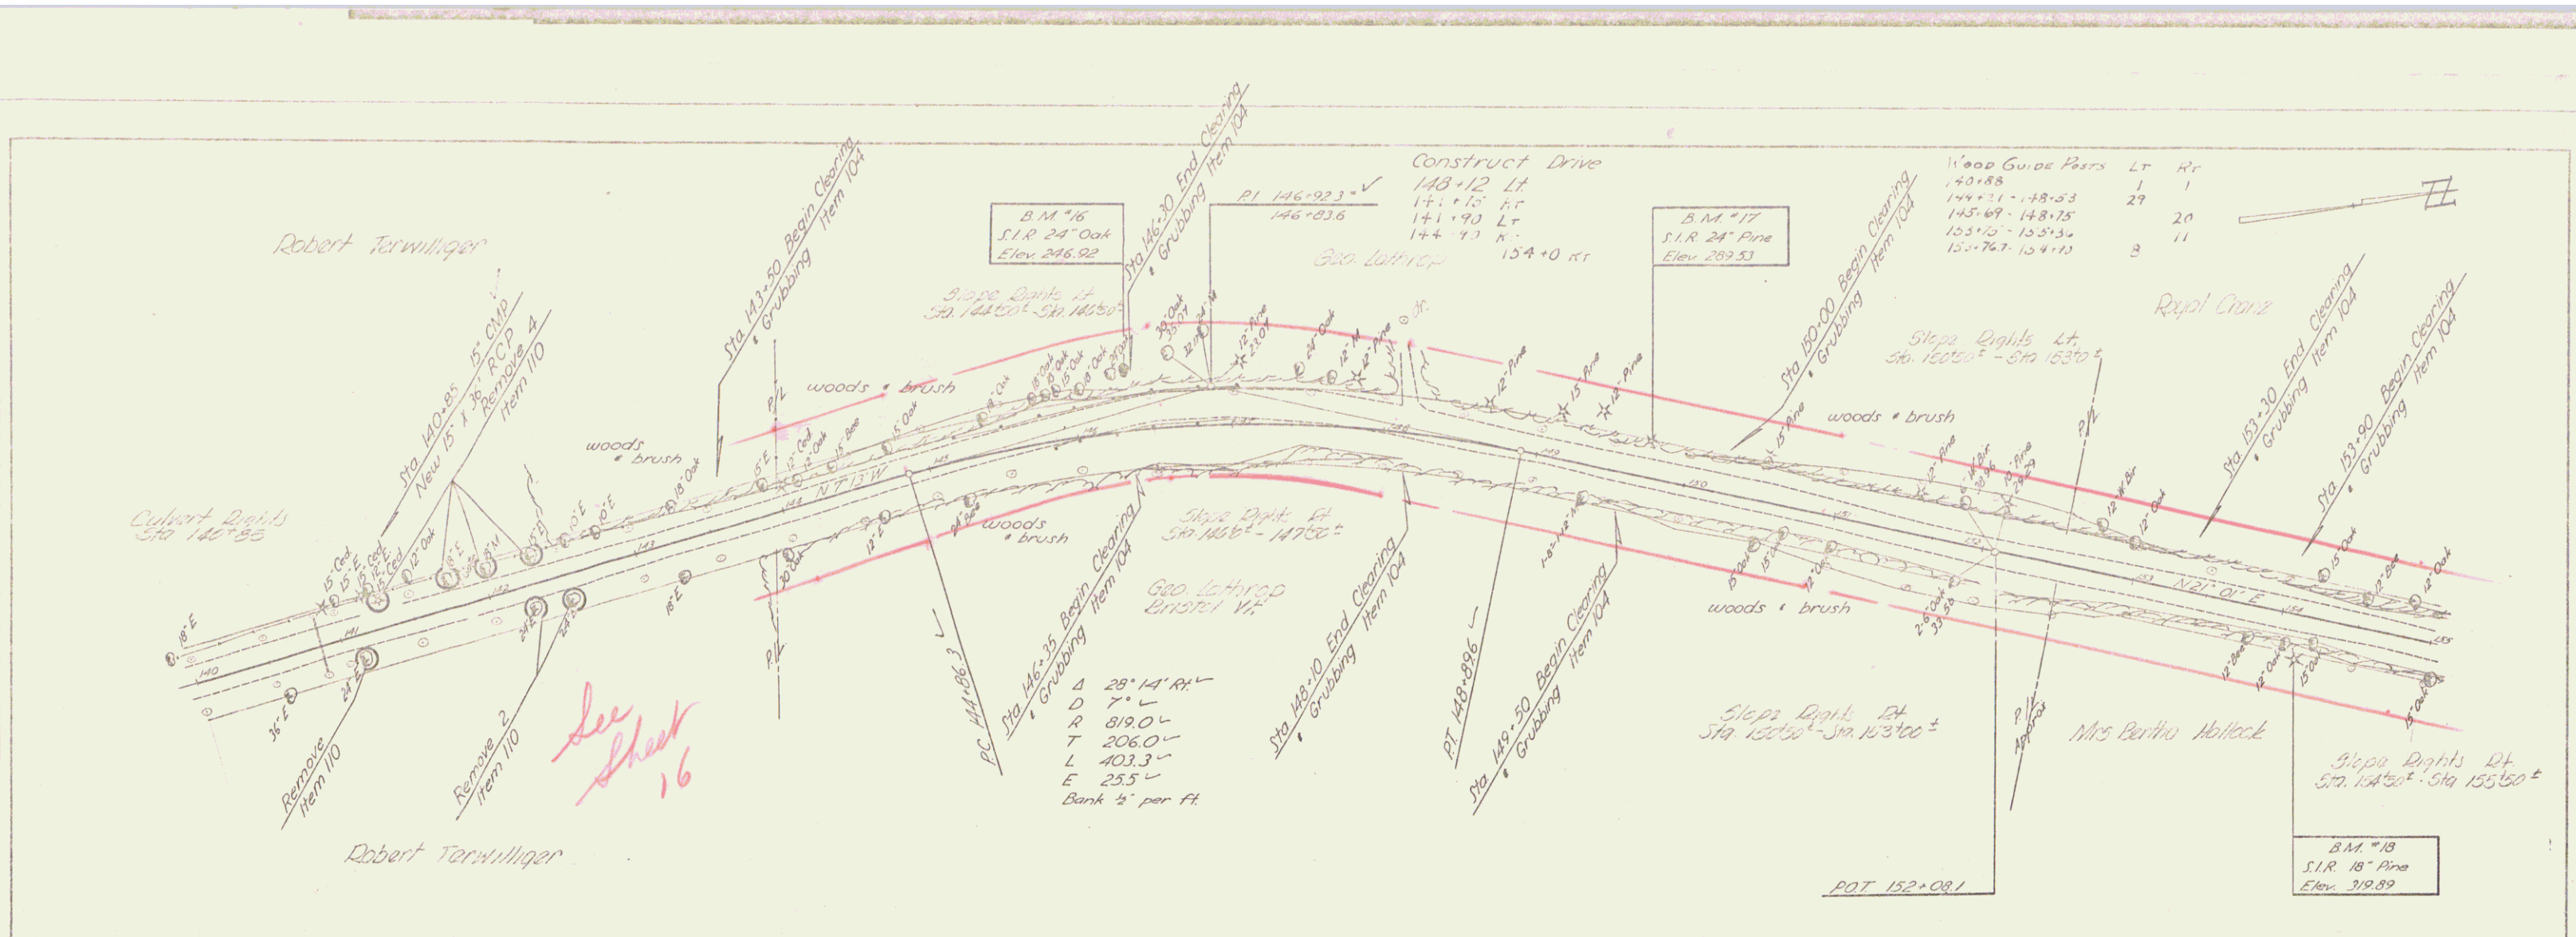

140	B.M. #6	S.I.R. 24" Oak	35.5 Lt	146.32	Elev. 246.92
141	B.M. #7	S.I.R. 24" Pine	18.5 Lt	149.73	Elev. 289.53
142	B.M. #8	S.I.R. 18" Pine	25' Rt	154.14	Elev. 319.89

MIDDLEBURY
proj. 9 250 (2)
Sheet 16 B