


- INDEX OF SHEETS
- SHEET NO.
- TITLE PAGE
  - TYPICAL CROSS-SECTION OF IMPROVEMENT (TACK COAT - TYPE X)
  - DRAINAGE AND ITEM QUANTITY SHEET
  - EARTHWORK SHEET
  - PLAN AND PROFILE SHEETS
  - A-61 (DRILLING & BLASTING OF SOLID ROCK SUBGRADE) 8-7-67R
  - B-1 (BANKING TABLES) 7-17-67R
  - B-5 (TYPICAL SLOPE GRADING) 3-10-65
  - B-10 (EMBANKMENT ON A SLOPE) 3-10-65
  - B-11 (UNDERDRAIN WITH SHATTERED ROCK SUBGRADE) 3-10-65
  - C-1 (TREATED TIMBER CURB) 3-10-65
  - D-2 (HEADWALLS, UNDERDRAIN) 7-25-67R
  - D-3 (TREATED GUTTERS) 7-19-67R
  - D-4 (FLUSHING BASINS) 8-1-66R
  - E-32 (ROAD CONSTRUCTION APPROACH SIGNS) 1-6-67
  - E-34 (ON-PROJECT CONSTRUCTION SIGNS) 5-3-67R
  - G-3 (THREE CABLE GUARD RAIL AND ANCHORS) 9-1-66R
  - G-4 (MARKER POSTS, GUIDE POSTS) 12-30-65R
  - J-1 (PROJECT MARKERS, BOUNDARY MARKERS) 3-10-65
  - SB-PP #2 (DETAILS OF ROUND PLATE PIPE AT STA. 33+50)
  - MACP-5-62 (METAL PLATE ARCH CATTLE PASS AT STA. 33+50)
  - INTERPOLATED CROSS-SECTIONS FOR CATTLE PASS
  - MAIN LINE CROSS-SECTIONS
  - CHANNEL LINE CROSS-SECTIONS AT M.L. STA. 33+77.0
  - FINAL EARTHWORK SHEET

STATE OF VERMONT  
DEPARTMENT OF HIGHWAYS  
**PROPOSED IMPROVEMENT**  
BETTERMENT PROJECT

**TOWN OF BRISTOL**  
COUNTY OF ADDISON  
EAST MIDDLEBURY - BRISTOL ROAD  
**VERMONT ROUTE # 116**

BEGINNING AT A POINT 0.672 MILE NORTHERLY OF THE MIDDLEBURY-BRISTOL TOWN LINE AND EXTENDING NORTHEASTERLY 0.379 MILE.  
LENGTH OF PROJECT = 2000.0 FEET = 0.379 MILE.

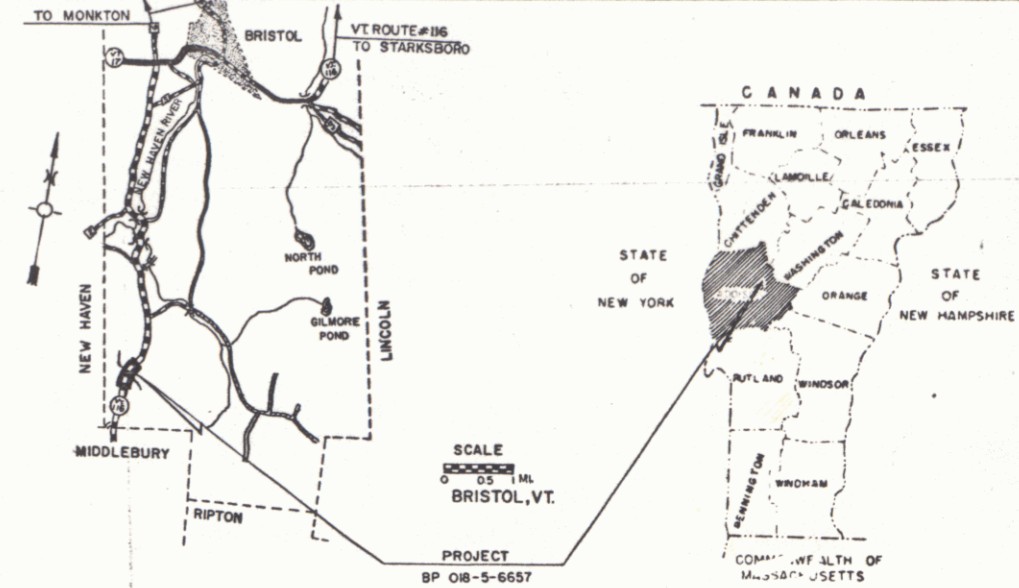


RECORD PLANS	
PROJECT NAME & NUMBER	TYPE / AREA
BRISTOL BP 018-5-6657	TACK CT.V 5867 SY.
MATERIALS	
SUB-BASE - GRAVEL - FARR PIT - BRISTOL, VT.	
TAR - KOPPERS CO. INC. - PORTLAND, ME.	
ASPHALT - MOBIL OIL CORP. - E. PROVIDENCE, R.I.	
PEA STONE & STONE GRITS - J.P. CARRARA & SONS INC. - E. MIDDLEBURY, VT.	
CONCRETE CLASS B - J.P. CARRARA & SONS INC. - E. MIDDLEBURY, VT.	
REINFORCING STEEL - V.T. STRUCTURAL STEEL - BURLINGTON, VT.	
METAL PIPE CULVERTS - N.E. METAL CULVERT CO. - WHITE RIVER JCT. VT.	
GUARD RAIL ITEMS - S.T. CRISWOLD & CO. - ESSEX JCT. VT.	
CONTRACTOR - ROGERS BROTHERS - BRATTLEBORO, VT.	CONTRACT DATED - JAN. 17, 1968
RESIDENT ENGINEER - E.M. JIPSON JR.	STARTED - APR. 8, 1968
INSPECTORS - R. FULLER, A. ELWOOD	COMPLETED - OCT. 15, 1968
RECORD PLANS - R. FULLER, B. BEARD	ACCEPTED - SEPT. 5, 1968

BENCH MARK DATA BASED ON ASSUMED ELEVATIONS

1967 ADT = 730  
1987 ADT = 1180  
1988 DHV = 200  
D = 60%  
T = 7%  
V = 50MPH

*Project: BP 018-5-6657  
- Plan: 00R490*

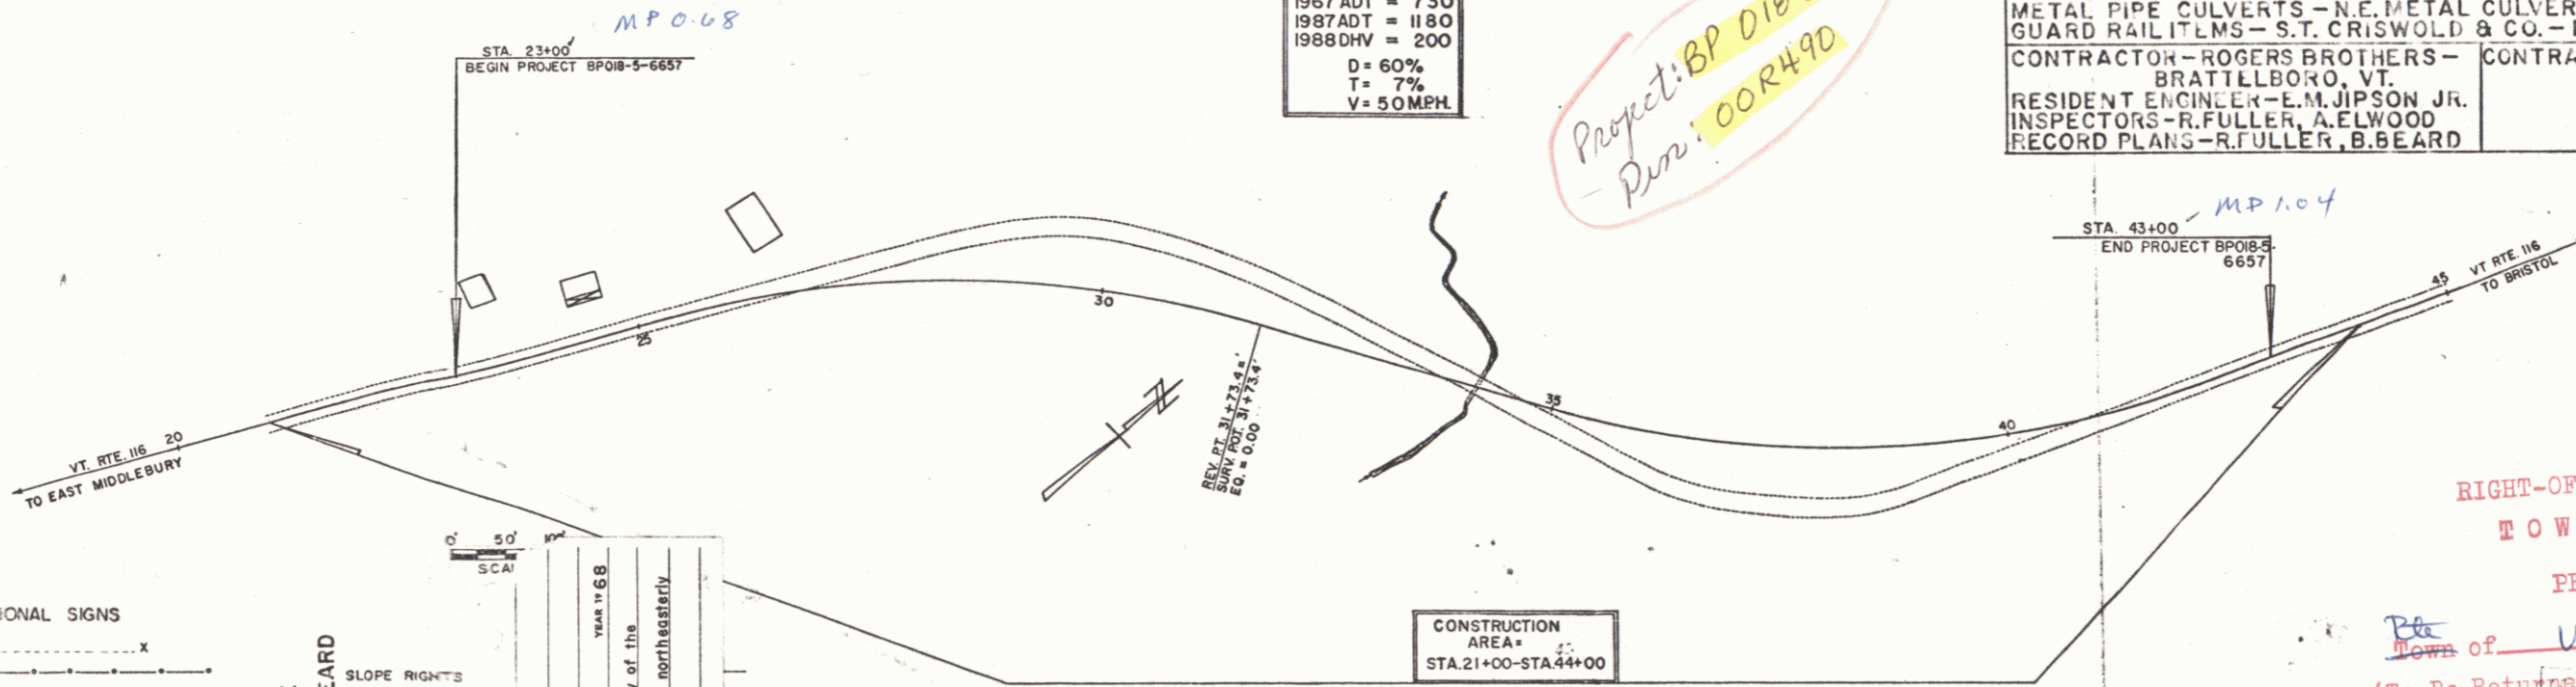

CONVENTIONAL SIGNS

- POINT OF ACCESS
- LIMITS OF ACCESS
- COUNTY LINE
- TOWN LINE
- FENCE LINE
- STONE WALL
- UNFENCED PROPERTY
- GUARD RAIL
- TRAVELED WAY
- RAILROAD
- RETAINING WALL
- CENTER LINE
- SURVEY LINE
- CULVERT
- DROP INLET
- TROLLEY
- POWER
- TELEPHONE POLE
- TREES
- HEDGE
- P.A. CONSTRUCTION IDENTIFICATION SIGNS

BRISTOL BP 018-5-6657  
CONTRACTOR - ROGERS BROTHERS, BRATTLEBORO, VT.  
COMPLETED OCT. 15, 1968  
BY R. FULLER & B. BEARD

PROJECT BRISTOL  
NUMBER BP 018-5-6657  
TYPE TACK COAT - TYPE X

CONTRACTOR ROGERS BROTHERS  
BRATTLEBORO, VT.  
YEAR 1968

Location: Beginning at a point 0.672 mile northerly of the Middlebury-Bristol Town Line and extending northeasterly 0.379 mile.

CONSTRUCTION AREA  
STA. 21+00 - STA. 44+00

RIGHT-OF-WAY DIVISION  
TOWN FILE  
PERPETUAL  
Plan of VT 116  
(To Be Returned To R.O.W. Division)

THESE PLANS ARE SUBJECT TO SUCH REVISIONS AS MAY BE REQUIRED BY THE COMMISSIONER OF HIGHWAYS.  
CONSTRUCTION IS TO BE CARRIED ON IN ACCORDANCE WITH THESE PLANS AND THE STANDARD SPECIFICATIONS FOR HIGHWAY AND BRIDGE CONSTRUCTION DATED APRIL, 1964, AS APPROVED BY THE BUREAU OF PUBLIC ROADS ON OCTOBER 12, 1964, INCLUDING ALL SUBSEQUENT APPROVED REVISIONS AND SUCH REVISED SPECIFICATIONS AND SPECIAL PROVISIONS AS ARE INCORPORATED IN THESE PLANS.

APPROVED SECONDARY ENGINEER DATE 5/19/67	APPROVED DISTRICT ENGINEER DATE 5-23-67	APPROVED CONSTRUCTION ENGINEER DATE 5/19/67	APPROVED RDW DIRECTOR DATE 5/31/67	APPROVED HIGHWAY ENGINEER DATE 5/31/67	APPROVED DATE 5/31/67	APPROVED DATE 5/31/67
--	---	---	--	--	--------------------------	--------------------------

PROJECT BP NO. 018-5-6657  
SHEET 1 OF 33 SHEETS