


PARCEL	KIND OF INSTRUMENT	DATE OF INSTRUMENT	GRANTOR	GRANTEE	RECORDED BOOK PAGE	RECORDED DATE	REMARKS
A & B C&K 7	WD	11-1-35	ON & D. ESTES	STPH	29 490	11-1-35	C&K Sta. 59+50
A	Cond	11-20-42	ON & D. ESTES	STPH	31 183 64	11-21-42	
A	W.D.O.E.	11-23-42	CLARENCE & NORMA JIMMO	STPH	31 183	12-3-42	

PLN. NO.	STAT.	YEAR	SHEET	TOTAL SHEETS
171(1)	1947	4	23	

PLAN
 DATE REVISION
 1947
 1948
 1949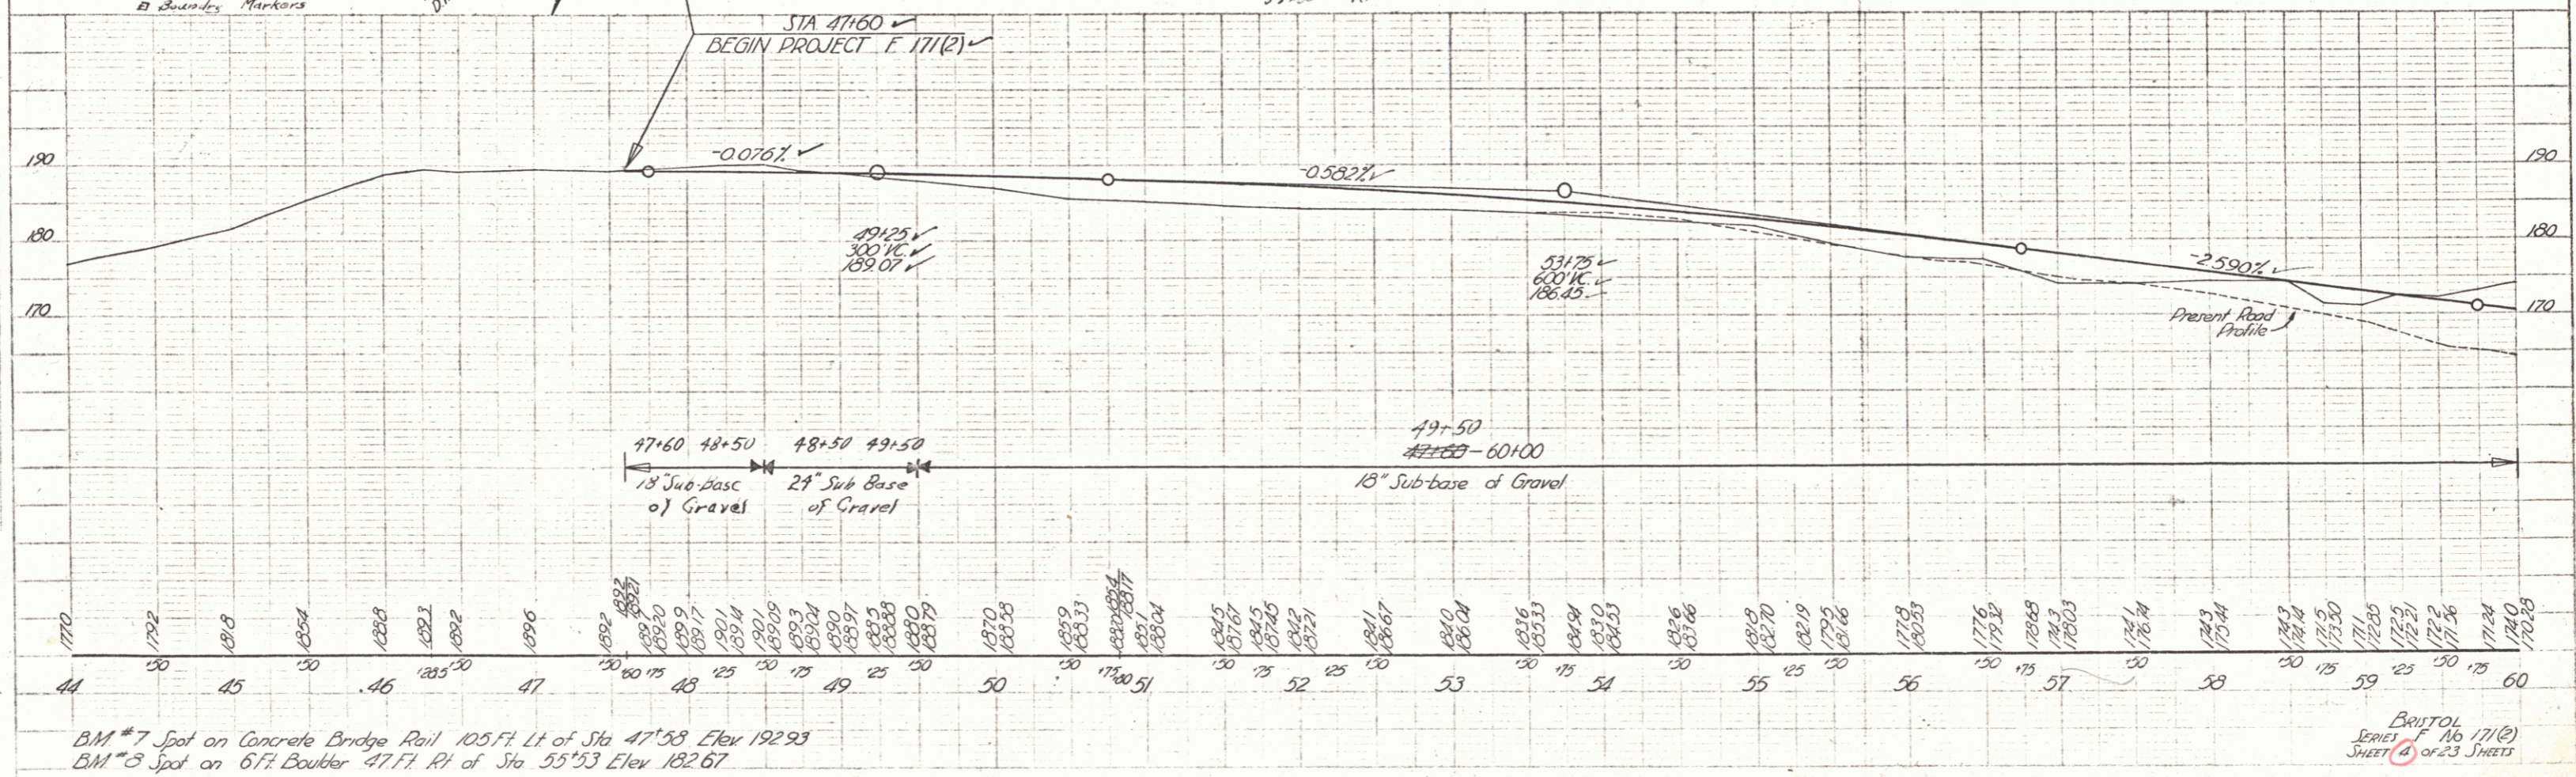
NOTE - Sta. 59+50
 Any changes the property owner may make or desire to make in connection with the water pipe shall be made at his expense. Any damage to the water pipe on account of the contractor's operations shall be repaired at the contractor's expense.

B.M. #7 Spot on Concrete Bridge Rail 105.74 Lt. of Sta. 47+53 Elev. 192.93
 B.M. #3 Spot on 6" Ft. Boulter 47.71 Rt. of Sta. 55+53 Elev. 182.67

BRITOL
 SERIES F 16 171(2)
 SHEET 4 OF 23 SHEETS