



PARCEL	KIND OF INSTRUMENT	DATE OF INSTRUMENT	GRANTOR	GRANTEE	RECORDED BRISTOL	REMARKS
B & C	W. D.	11-1-35	O.M. & B. ESTES	ST. OF VT.	29	1930 11-1-35
D & C	COND.	11-20-42	O.M. & B. ESTES	ST. OF VT.	31	1936 11-21-42
A	COND.	11-20-42	RALPH & JESSIE SWEET	ST. OF VT.	31	1936 11-21-42

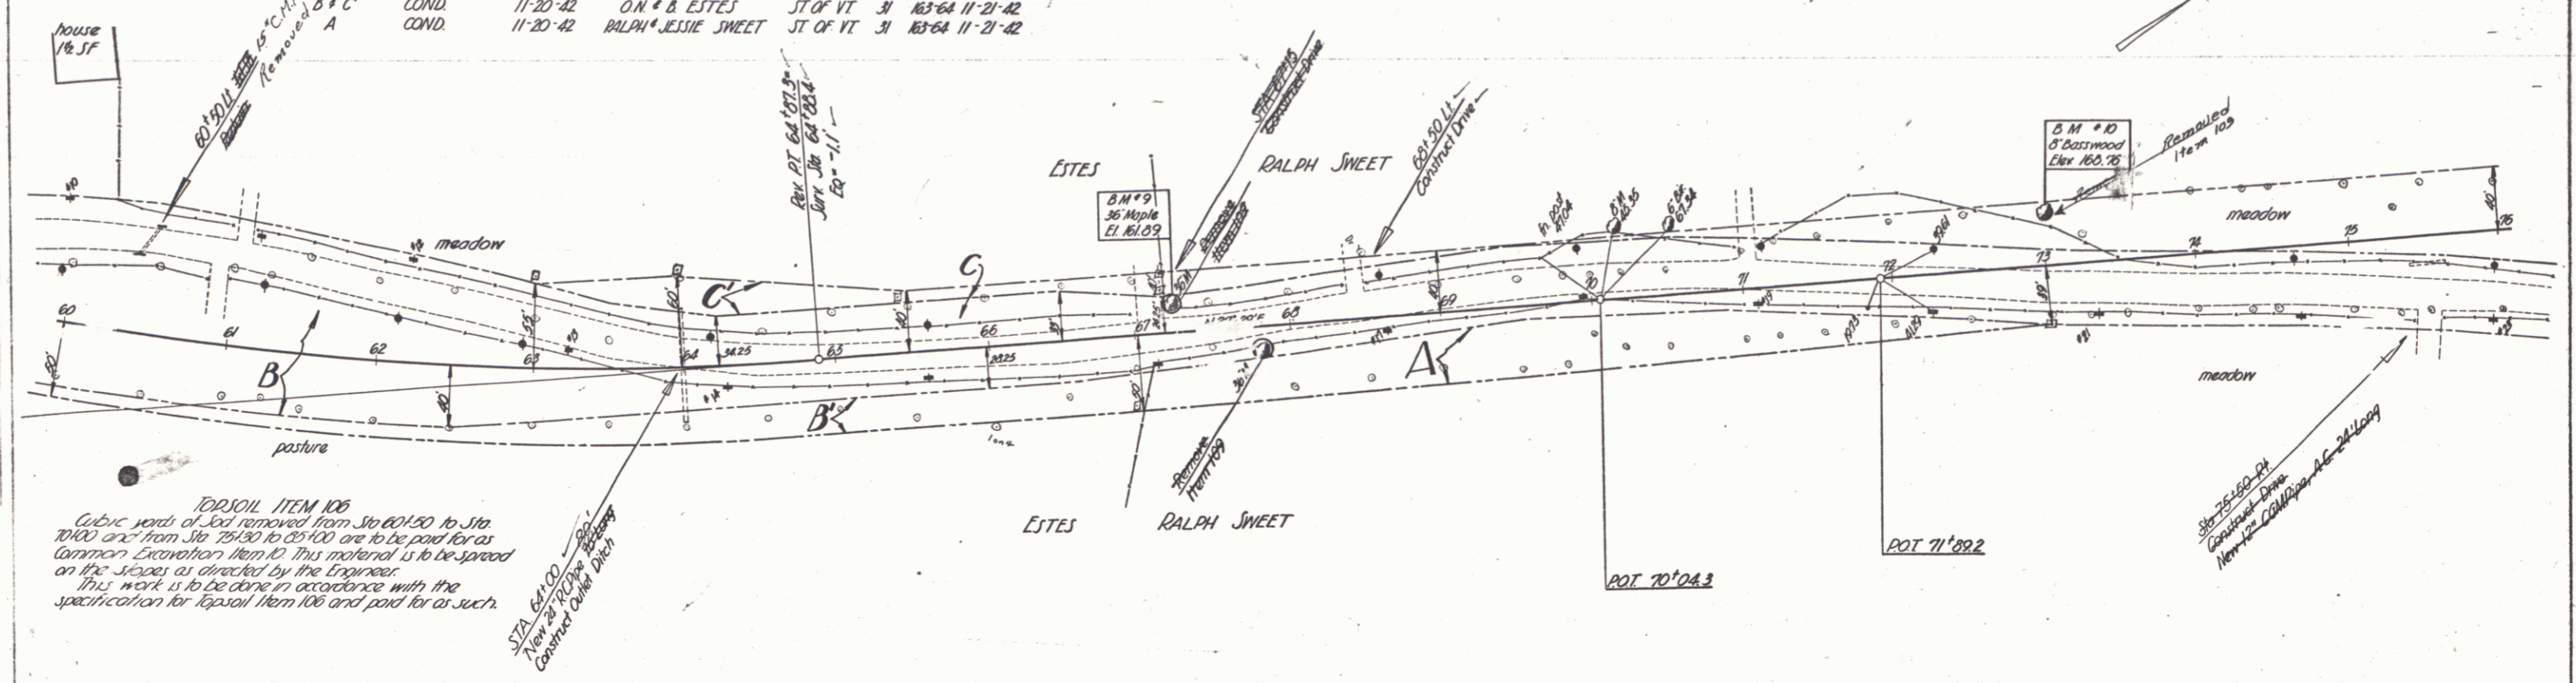

TOPSOIL ITEM 106
 Cubic yards of soil removed from Sta 60+50 to Sta 70+00 are to be paid for as Common Excavation Item 10. This material is to be spread on the slopes as directed by the Engineer. This work is to be done in accordance with the specification for Topsoil Item 106 and paid for as such.

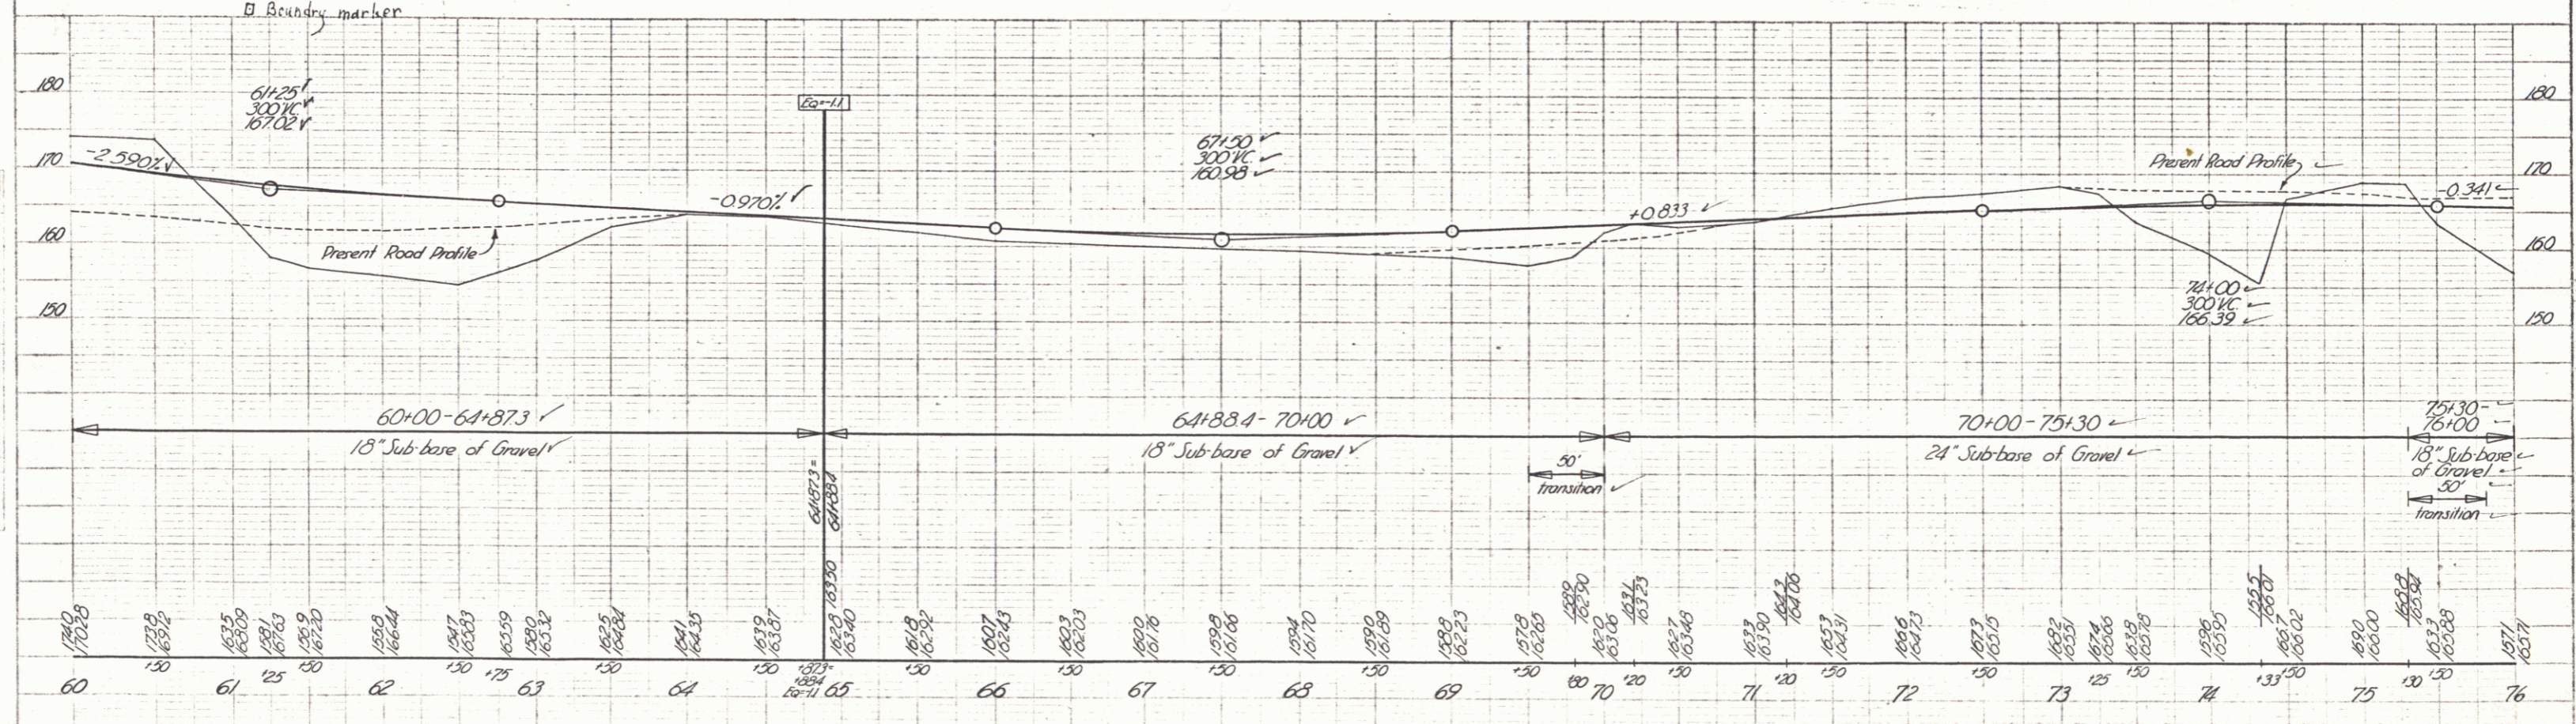

BM #9 Spike in Root of 36" Maple 14 Ft. Lt. of Sta 67+25 Elev 161.89
 BM #10 Spike in Root of 8" Basswood 29 Ft. Lt. of Sta 73+00 Elev 168.76

BRISTOL
 SERIES F No. 171(2)
 SHEET 5 OF 23 SHEETS