


PLAN
 17102 1047 6 23

NOTE: Between Sta 74+00 to Sta 85+00 for grading on the left of and removal or grading of existing old road surface and base see cross-section sheets 21 to 23

PARCEL	INSTRUMENT	DATE	GRANTOR	GRANTEE	RECORDED	REMARKS
D	Cond	11-20-42	Ralph & Jessie Sweet & of W		Doc. 16364	11-21-42

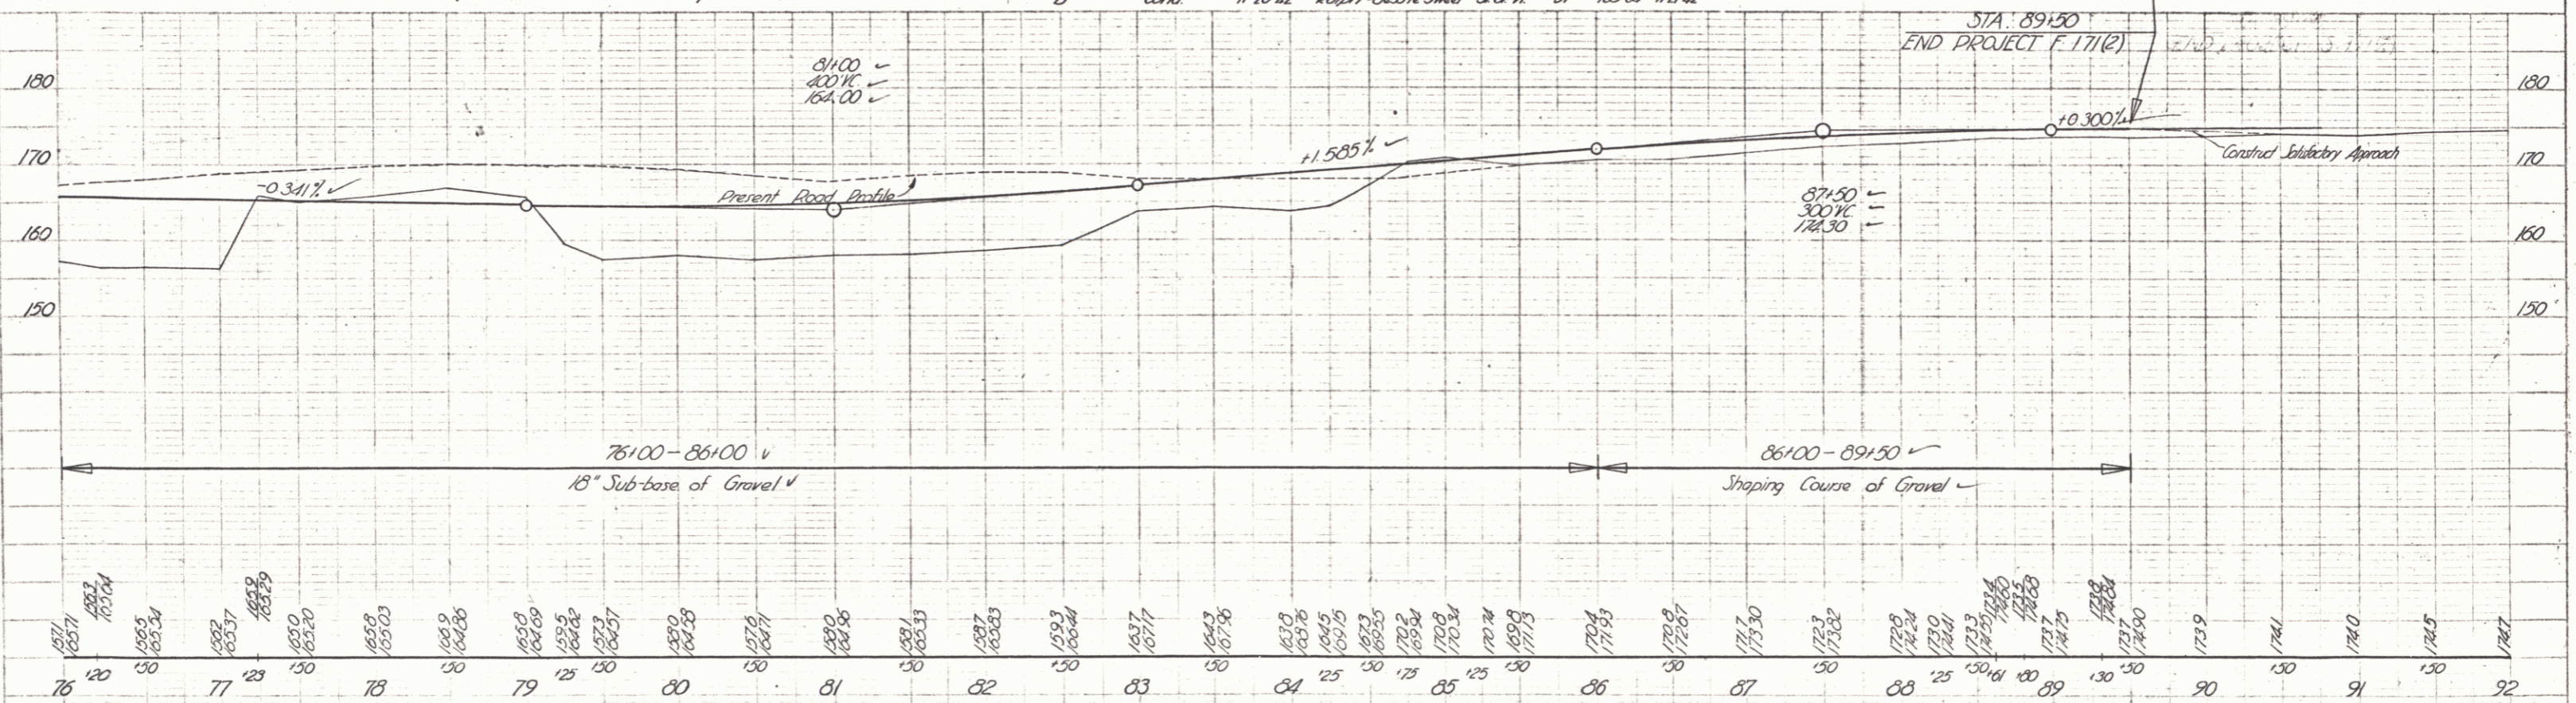

BM # 11 Spike in Root of 24" Elm 180 FT RI of Sta 80+43 Elev. 169.72
 BM # 12 Spike in Root of 12" Apple COFF Lt of Sta 87+14 Elev. 164.96
 BM # 13 Spike in Root of 24" Stump 25 FT RI of Sta 88+63 Elev. 174.79

BRUTAL
 SERIAL F No 17102
 SHEET 6 OF 23 SHEETS