



PLAN
 STATIONS 54
 DATE BOOK FOR LAND CHG. 11/10/54
 170 5/2

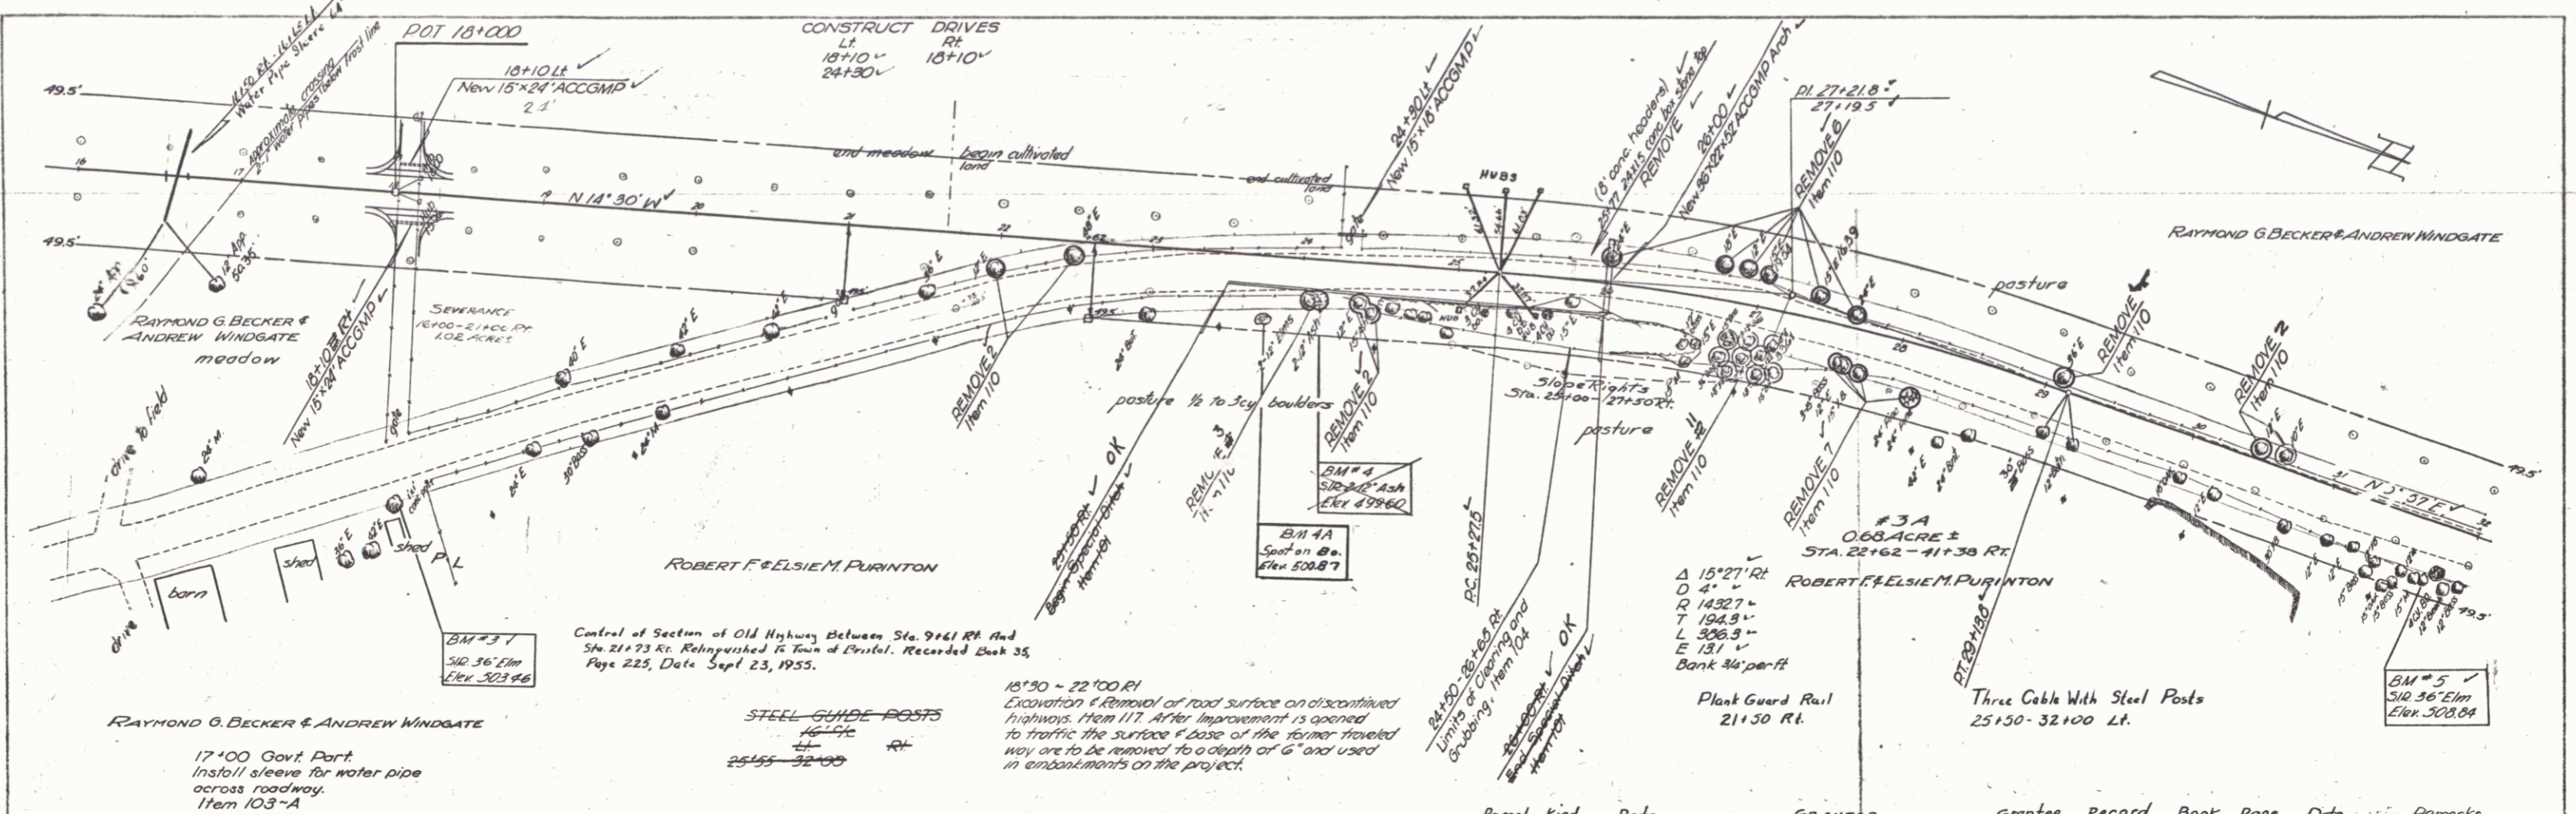

PLAN
 STATIONS 54
 PALMER
 2-52

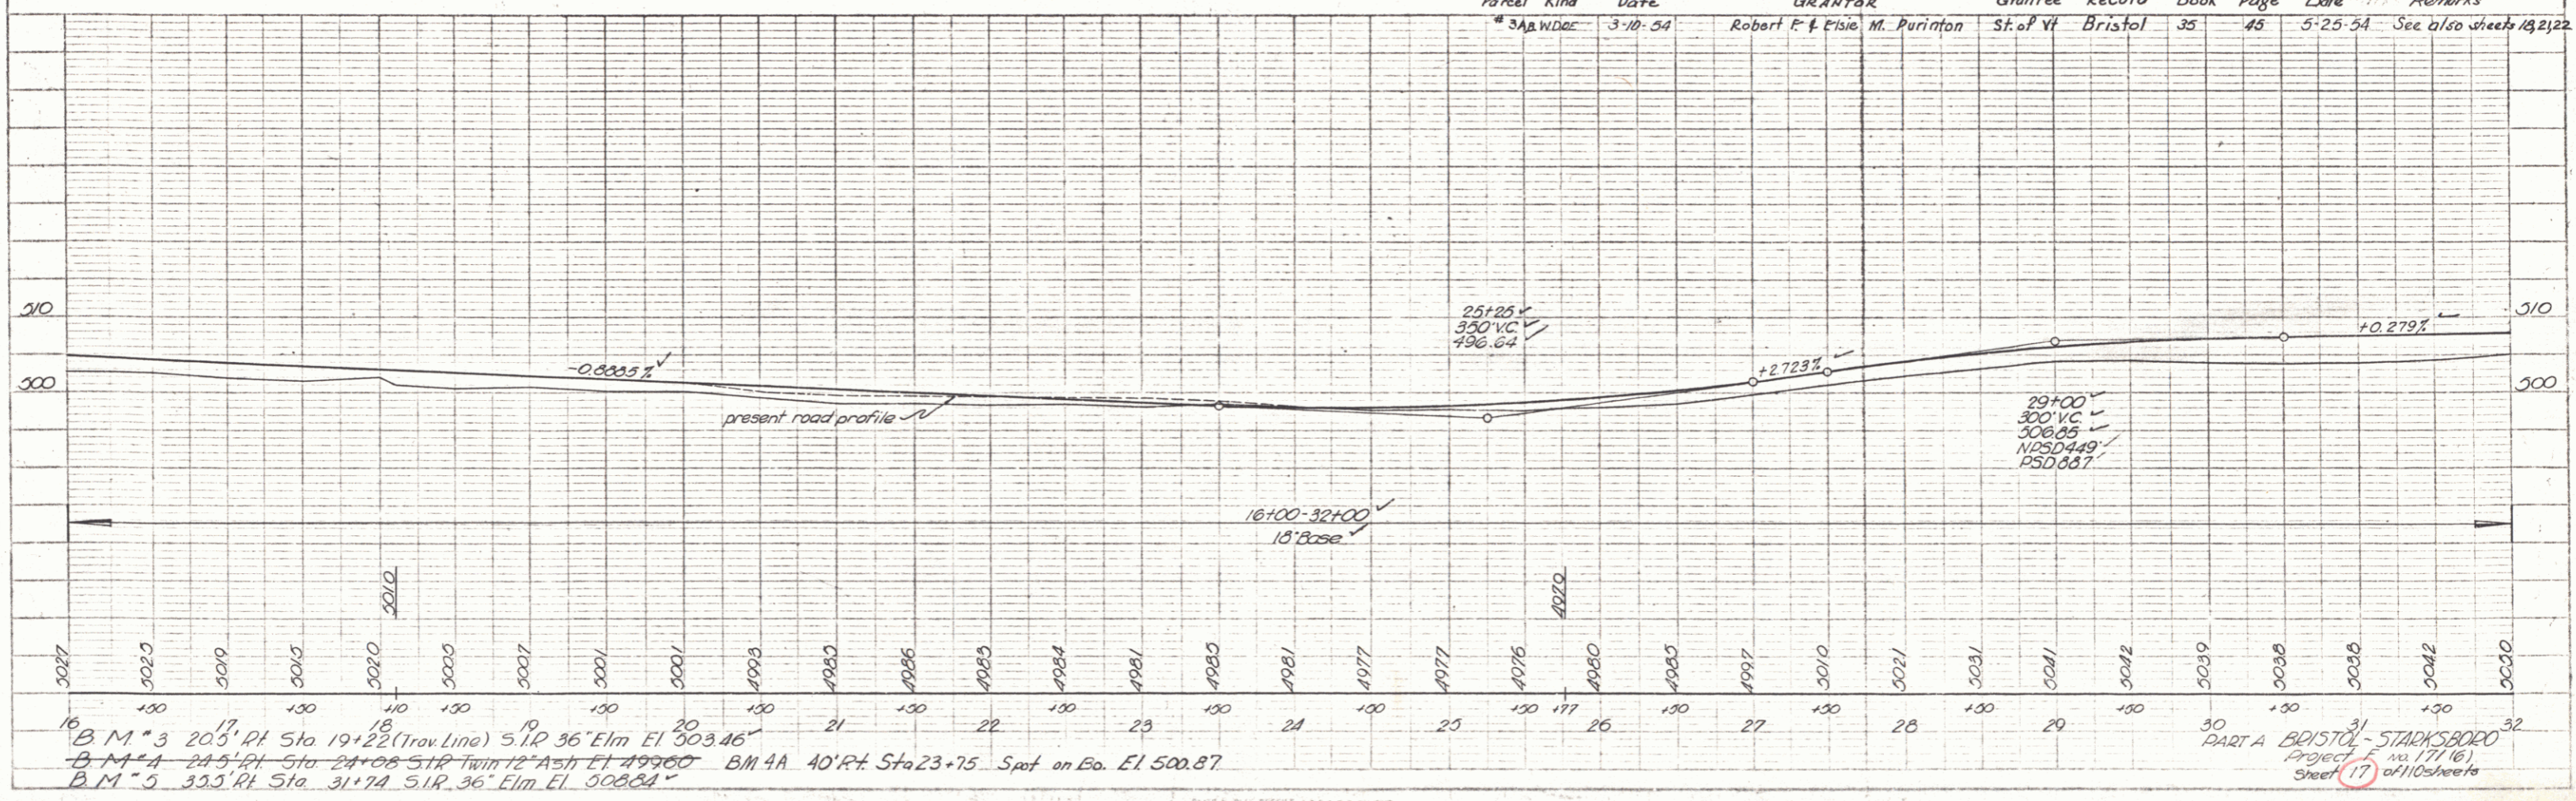

Parcel Kind	Date	GRANTOR	Grantee	Record Book	Page	Date	Remarks
# 3A R.W.D.R.	3-10-54	Robert F. & Elsie M. Purinton	St. of Vt	Bristol	35 45	5-25-54	See also sheets 18, 21, 22

16 B.M. #3 203' R.H. Sta. 19+22 (Trav. Line) S.I.R. 36' Elm El. 503.46
 17 B.M. #4 24.5' R.H. Sta. 24+08 S.I.R. 12' Ash El. 499.60
 20 B.M. #4 40' R.H. Sta. 23+75 Spot on Co. El. 500.87
 21
 22
 23
 24
 25
 26
 27
 28
 29
 30
 31
 32

PART A BRISTOL - STARKSBORO
 Project No. 177 (6)
 Sheet 17 of 110 sheets