
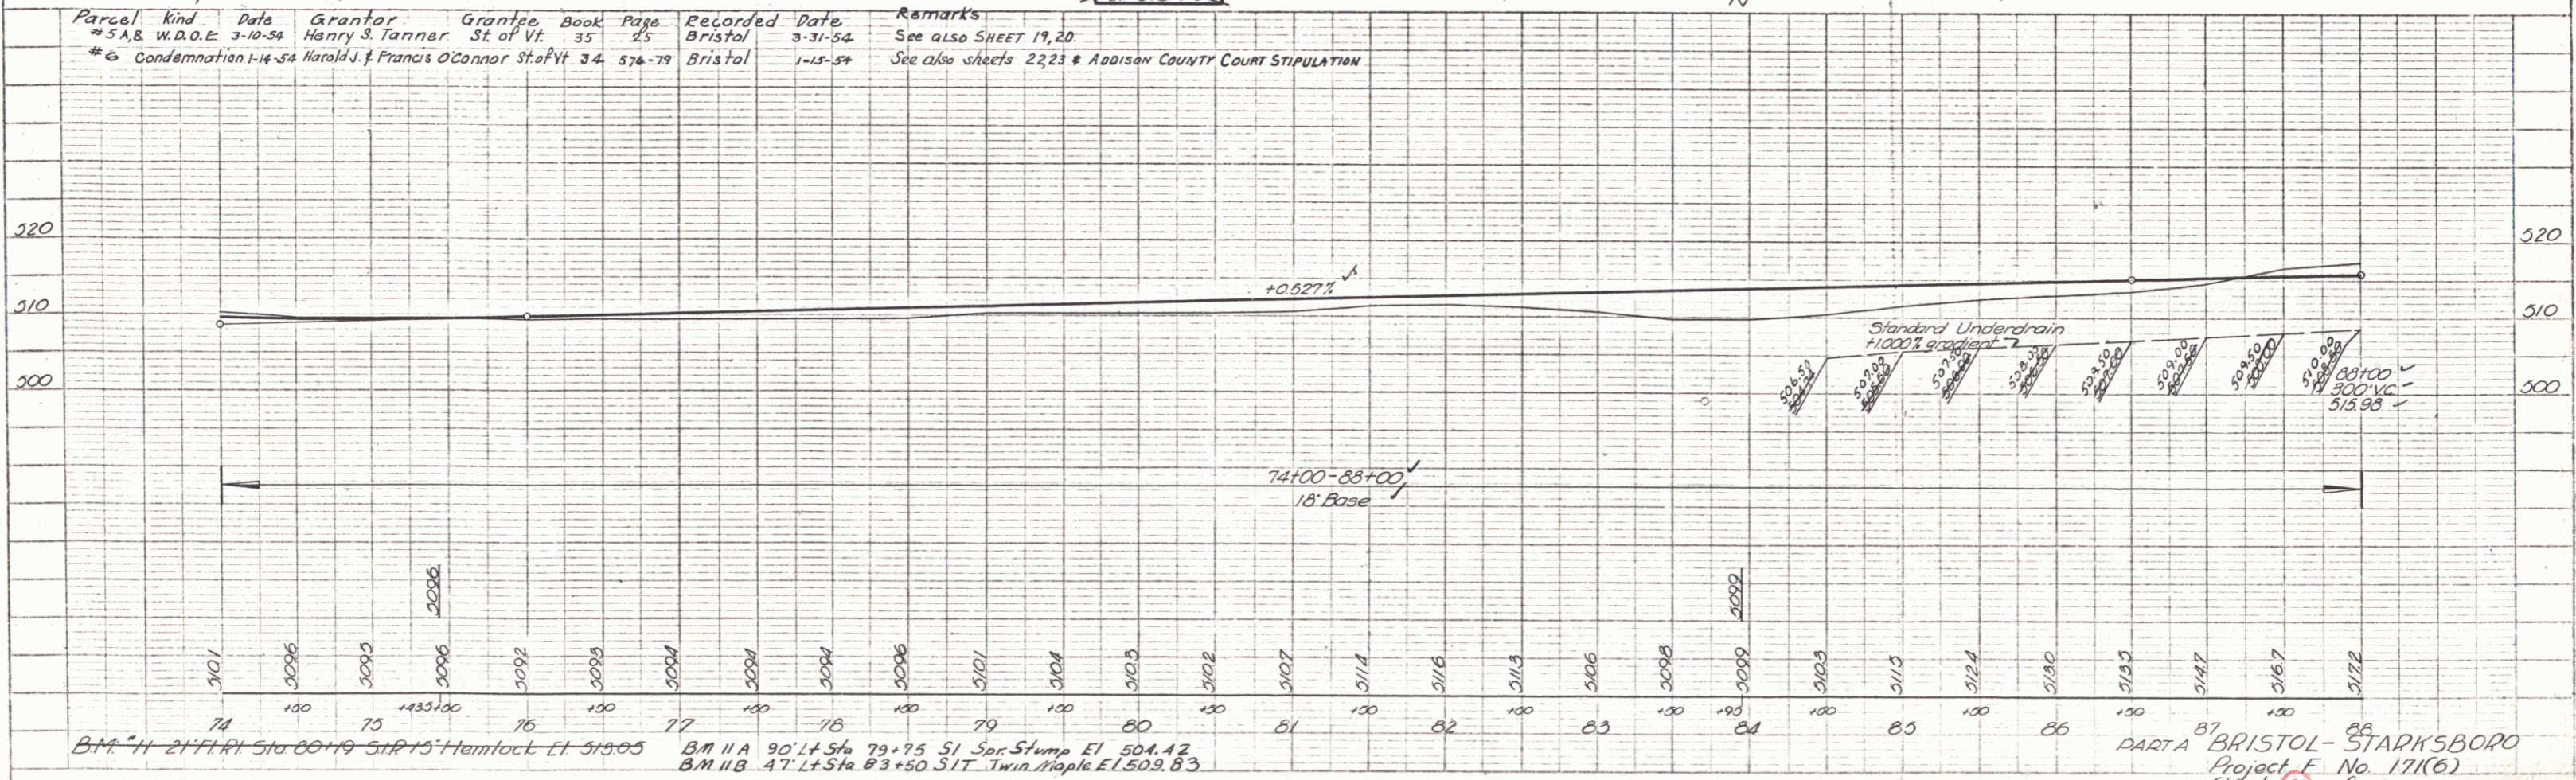


PLAN  
 DATE 2-27  
 DRAWN BY R. POLMER  
 CHECKED BY R. POLMER  
 SCALE 1" = 40'

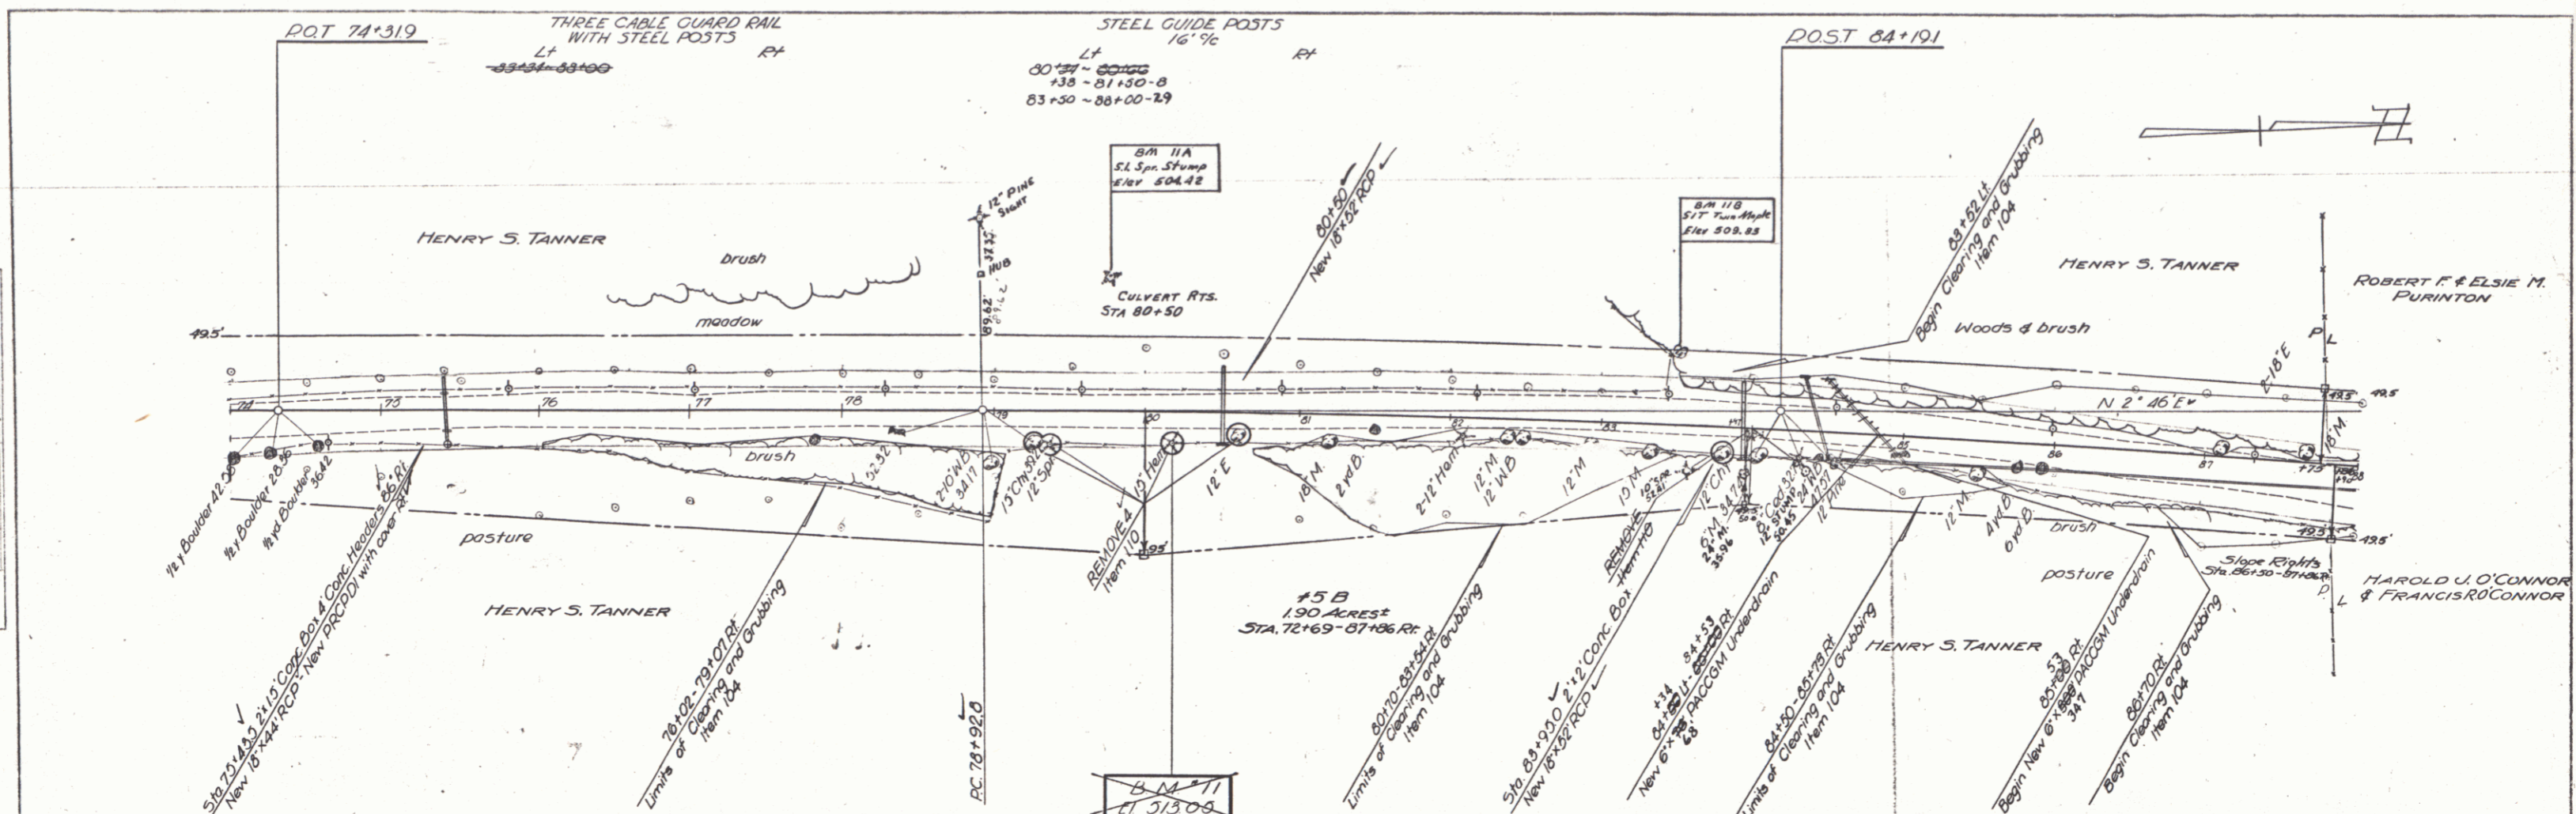

PROFILE  
 DATE 2-27  
 DRAWN BY R. POLMER  
 CHECKED BY R. POLMER  
 SCALE 1" = 40'

B.M. #11 21' Ht. Sta. 51+00+19 S.T. 15' Hemlock El. 513.05  
 B.M. #1A 90' Lt. Sta. 79+75 S.T. 51' Sor. Stump El. 504.42  
 B.M. #1B 47' Lt. Sta. 83+50 S.T. 11' Twin Maple El. 503.83

DARTA BRISTOL-STARKSBORO  
 Project F No. 17(K6)  
 Sheet 21 of 110

PLOT 1 - PLAN PROFILE 1:40 & 1:20  
 MARCH 1, 1954  
 H. S. POLMER