



PLAN  
 2-58  
 Palmer  
 2-58

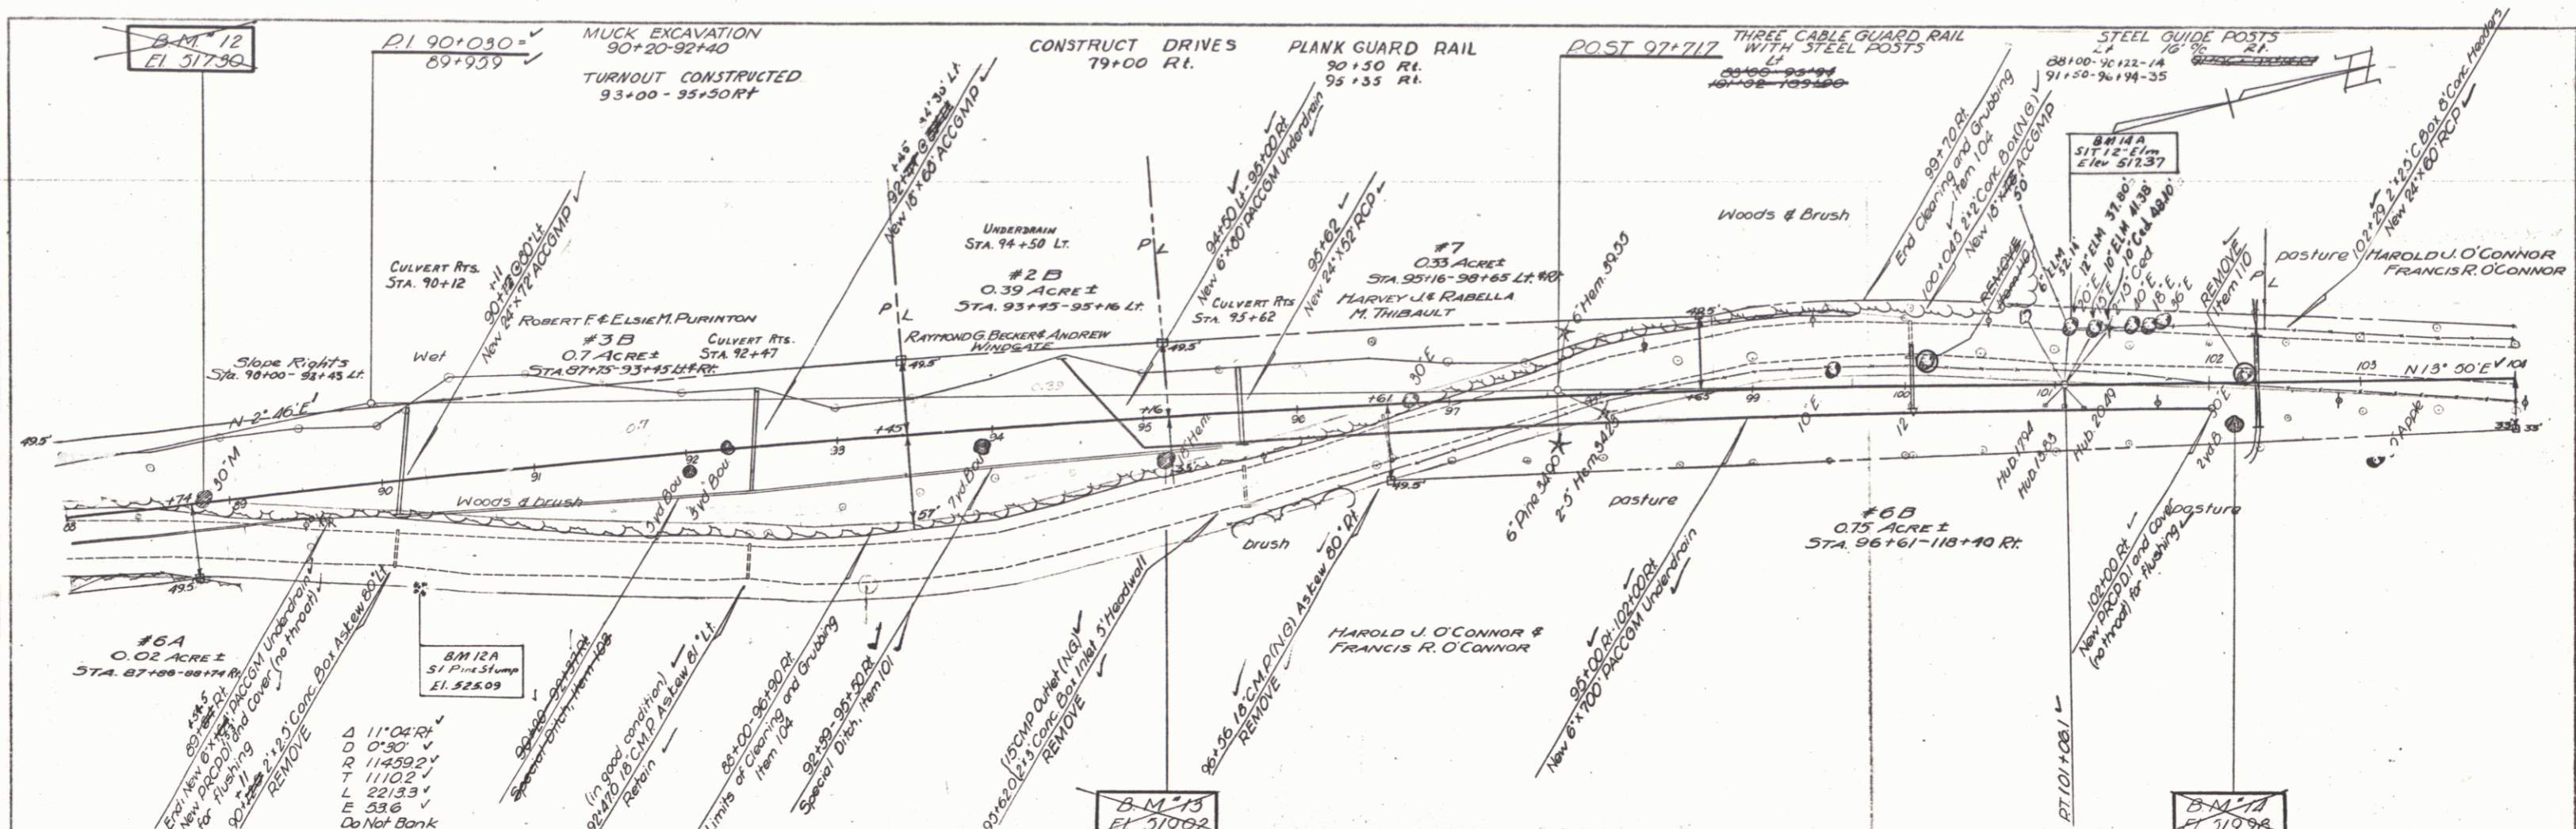

2-58  
 Palmer  
 2-58

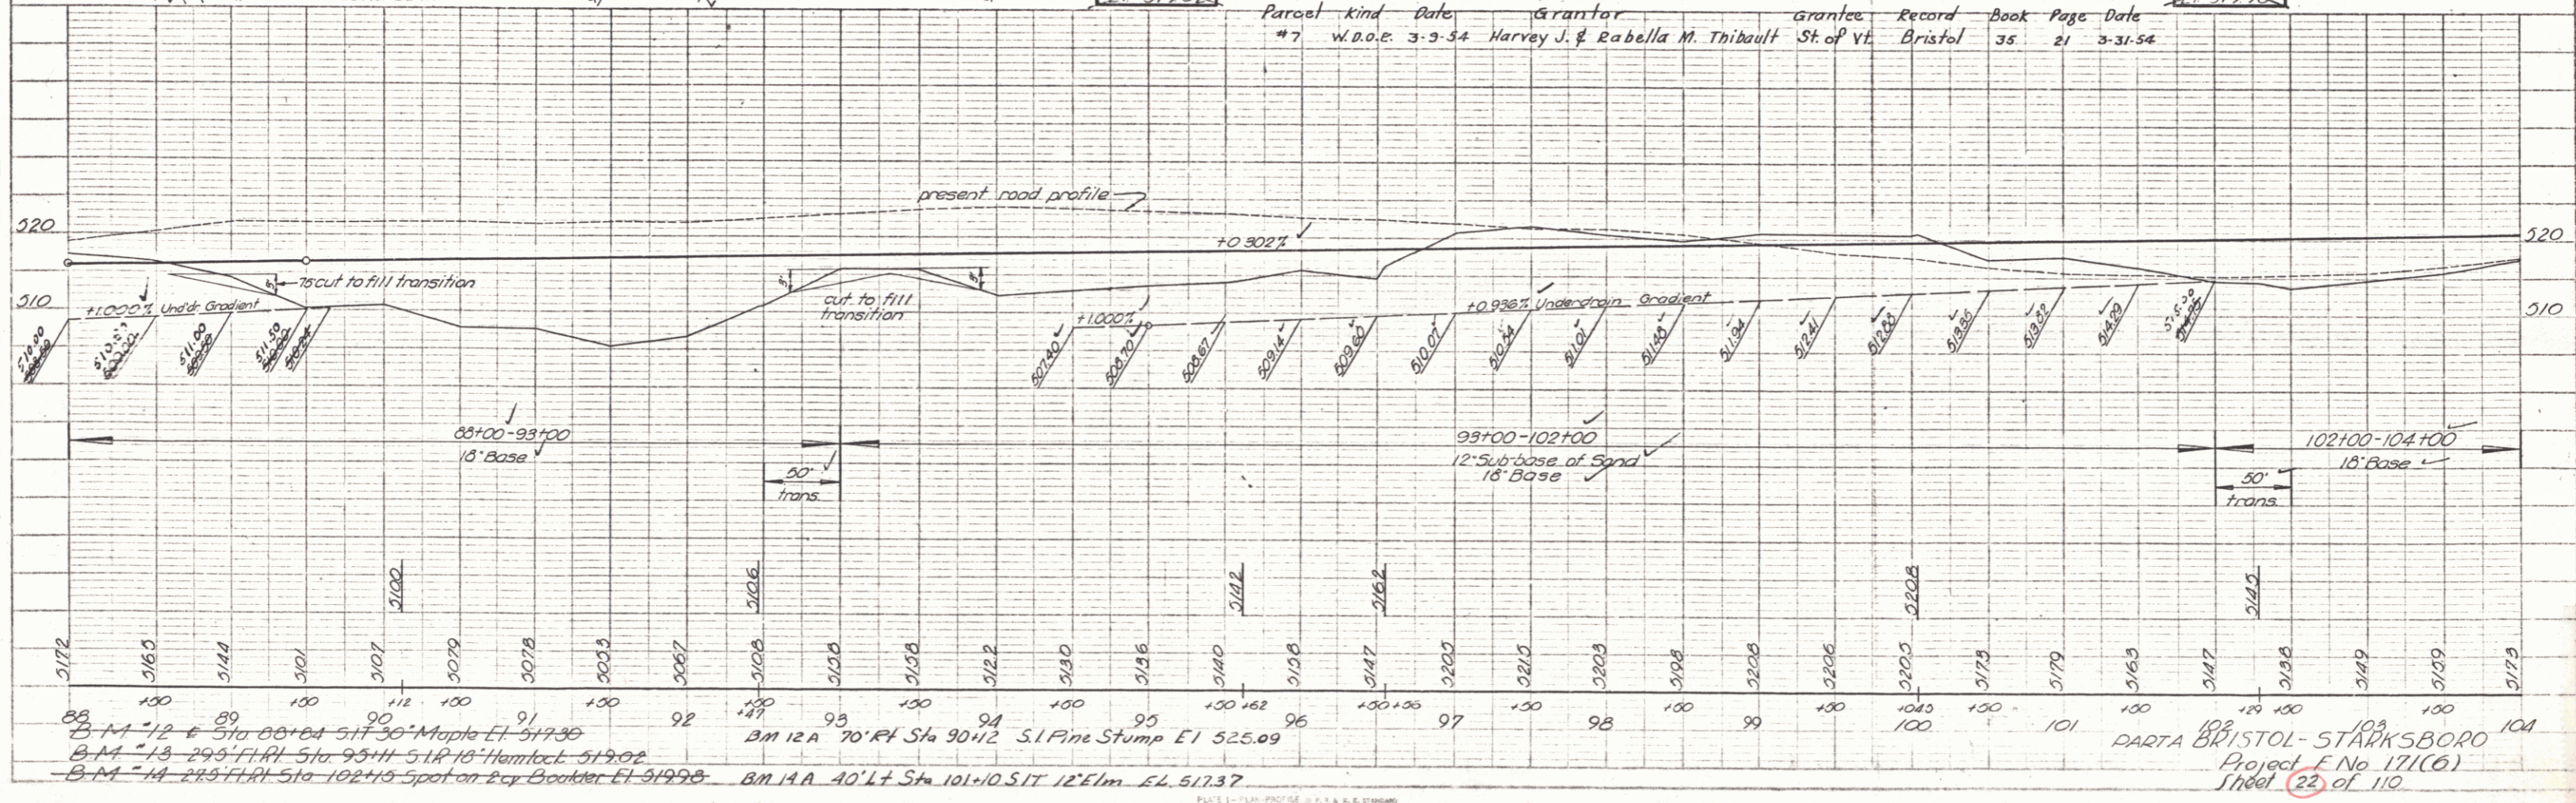

B.M. 12 511.30 Maple El. 517.35  
 B.M. 13 299.41 Rt Sta 93+14 5.14 10' Hamlock El. 517.02  
 B.M. 14 245.41 Rt Sta 102+45 Spot on Box Boulder El. 519.95  
 B.M. 12A 70' Rt Sta 90+12 5.1 Pine Stump El. 525.09  
 B.M. 14A 40' Lt Sta 101+0 5.11 12' Elm El. 517.37

Parcel	Kind	Date	Grantor	Grantee	Record	Book	Page	Date
#7	W.D.O.E.	3-9-54	Harvey J. & Rabella M. Thibault	St. of Vt.	Bristol	35	21	3-31-54

DARTA BRISTOL-STARKSBORO  
 Project E No 171(C)  
 Sheet 23 of 110