

PLAN
 785' x 7' 2-3/4"
 DATE NOV 1958
 DRAWN BY PALMER
 NO. 2-32

PROFILE
 110' x 11' 2-3/4"
 DATE NOV 1958
 DRAWN BY PALMER
 NO. 2-32

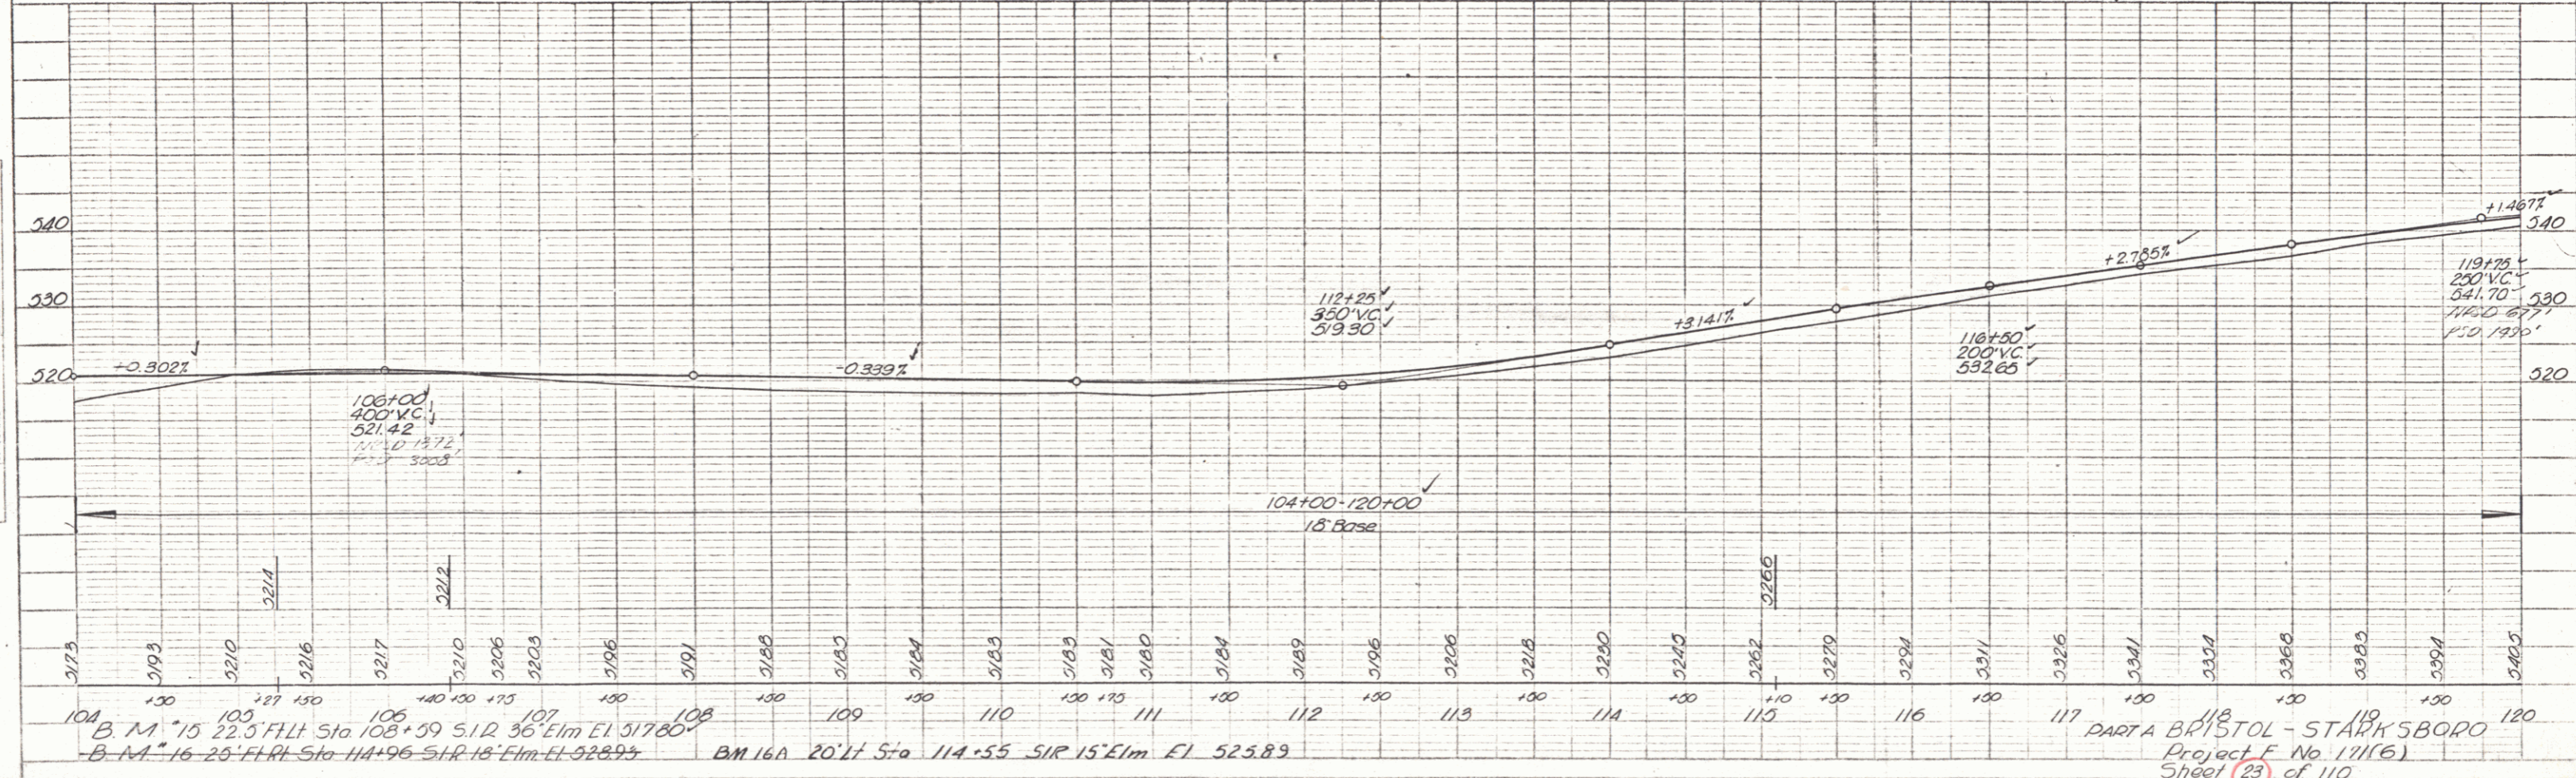
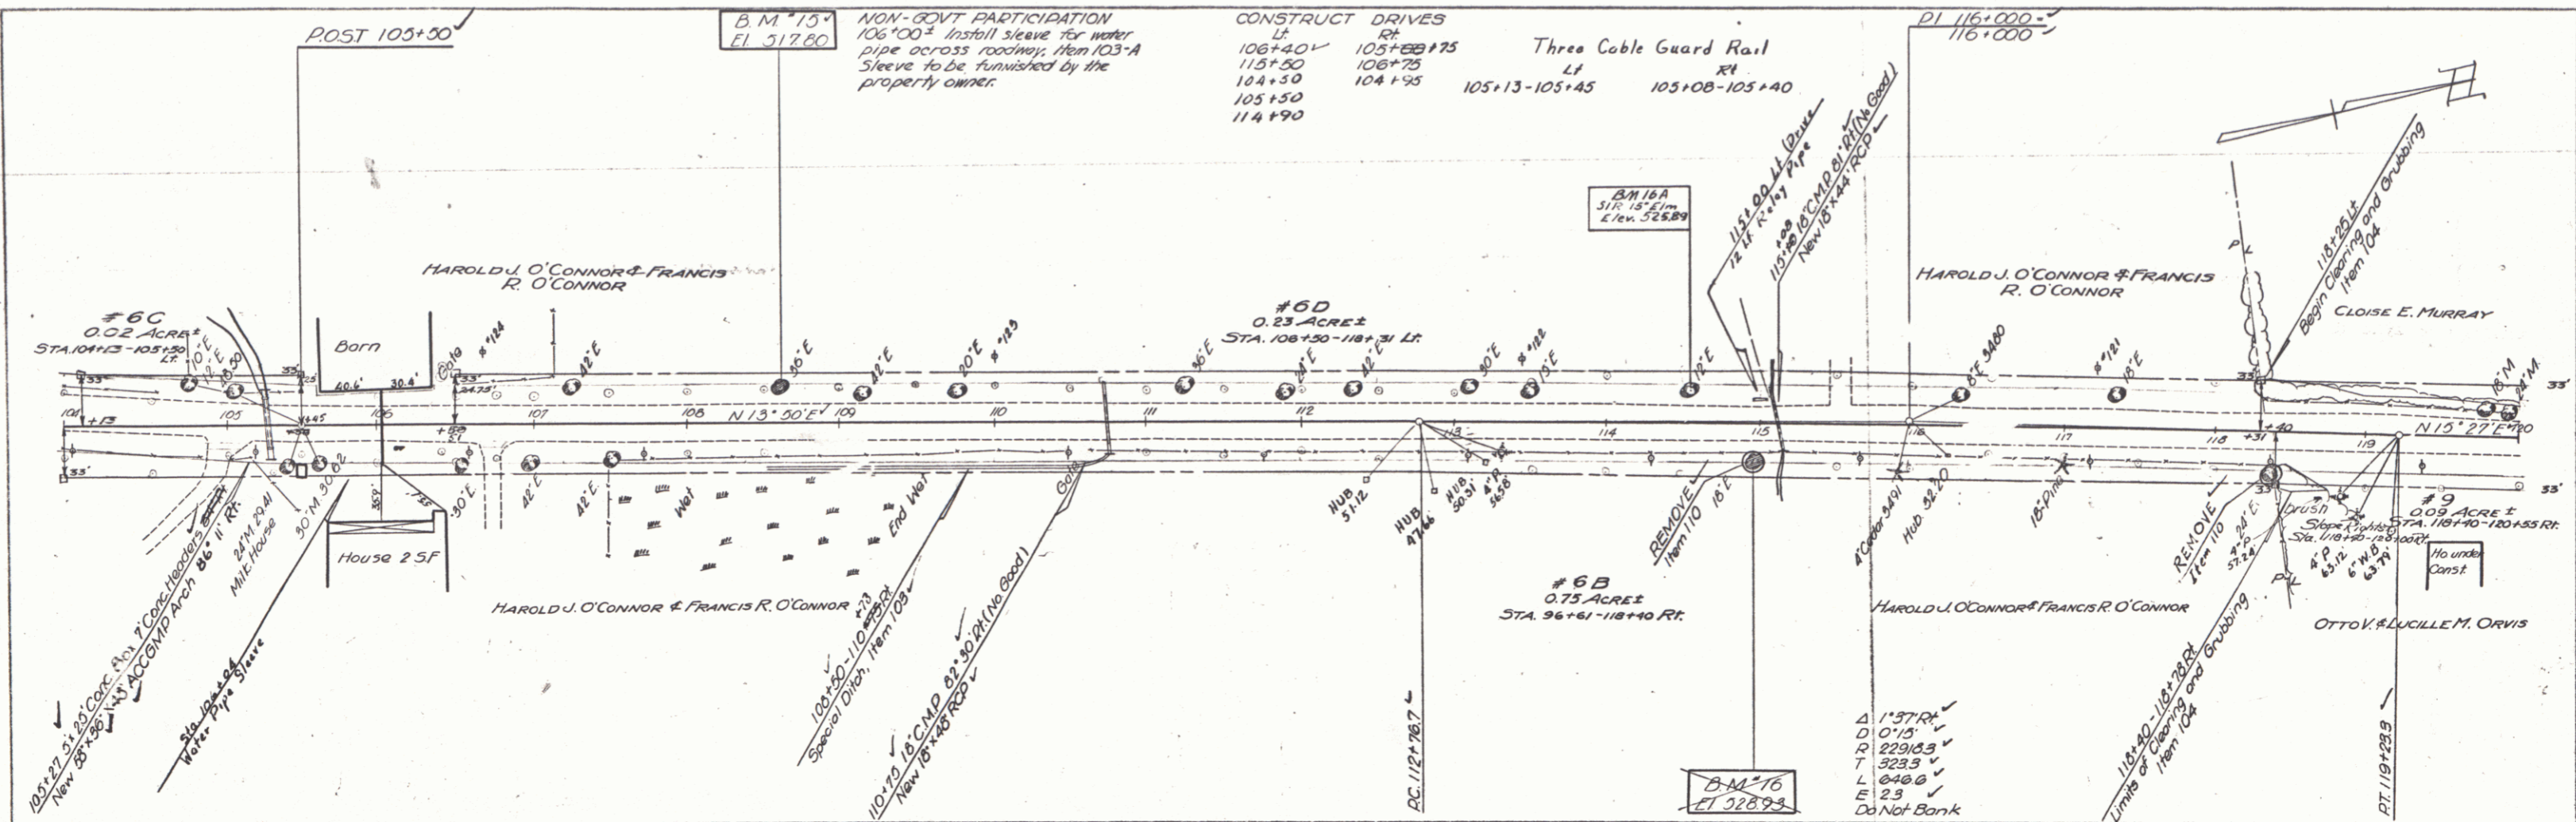


PLATE 1 - PLAN PROFILE
 METROPOLITAN ENGINEERING CO., NEW YORK
 110 N. 3RD ST.