



PLAN
 DATE
 PRICE
 SHEETS
 2-28

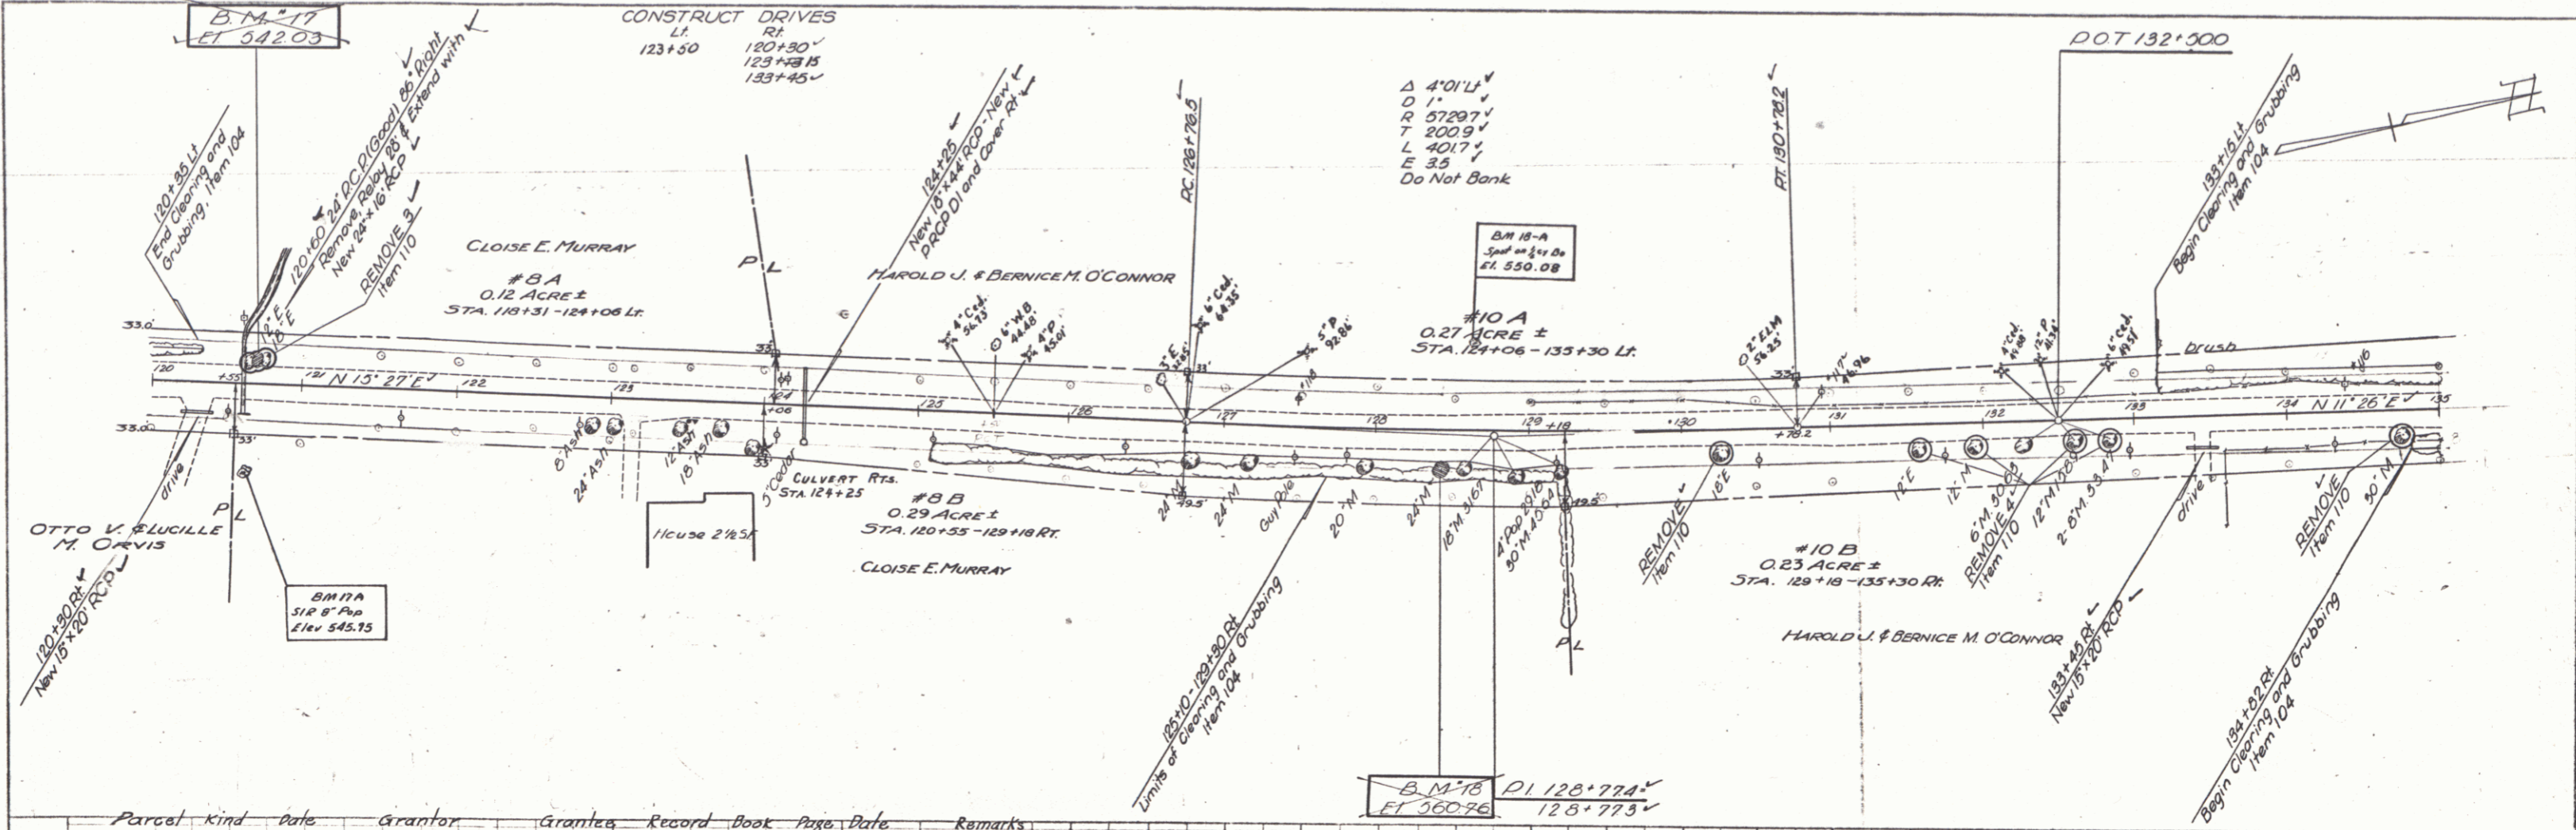

Parcel	Kind	Date	Grantor	Grantee	Record	Book	Page	Rate	Remarks
#8 AB	W.D.O.E.	3-10-54	Cloise E. Murray	St. of Vt.	Bristol	35	23	3-38-54	See also sheet 23
#9	W.D.O.E.	3-11-54	Otto V. & Lucille M. Orvis	St. of Vt.	Bristol	35	41	5-5-54	See also sheet 23
#10	ABSGE COND.	1-15-54	Harold J. & Bernice M. O'Connor	St. of Vt.	Bristol	34	376-79	1-15-54	Appeal. See also sheet 25 & Addison County Court Stipulation.

PROFILE
 DATE
 PRICE
 SHEETS
 2-28

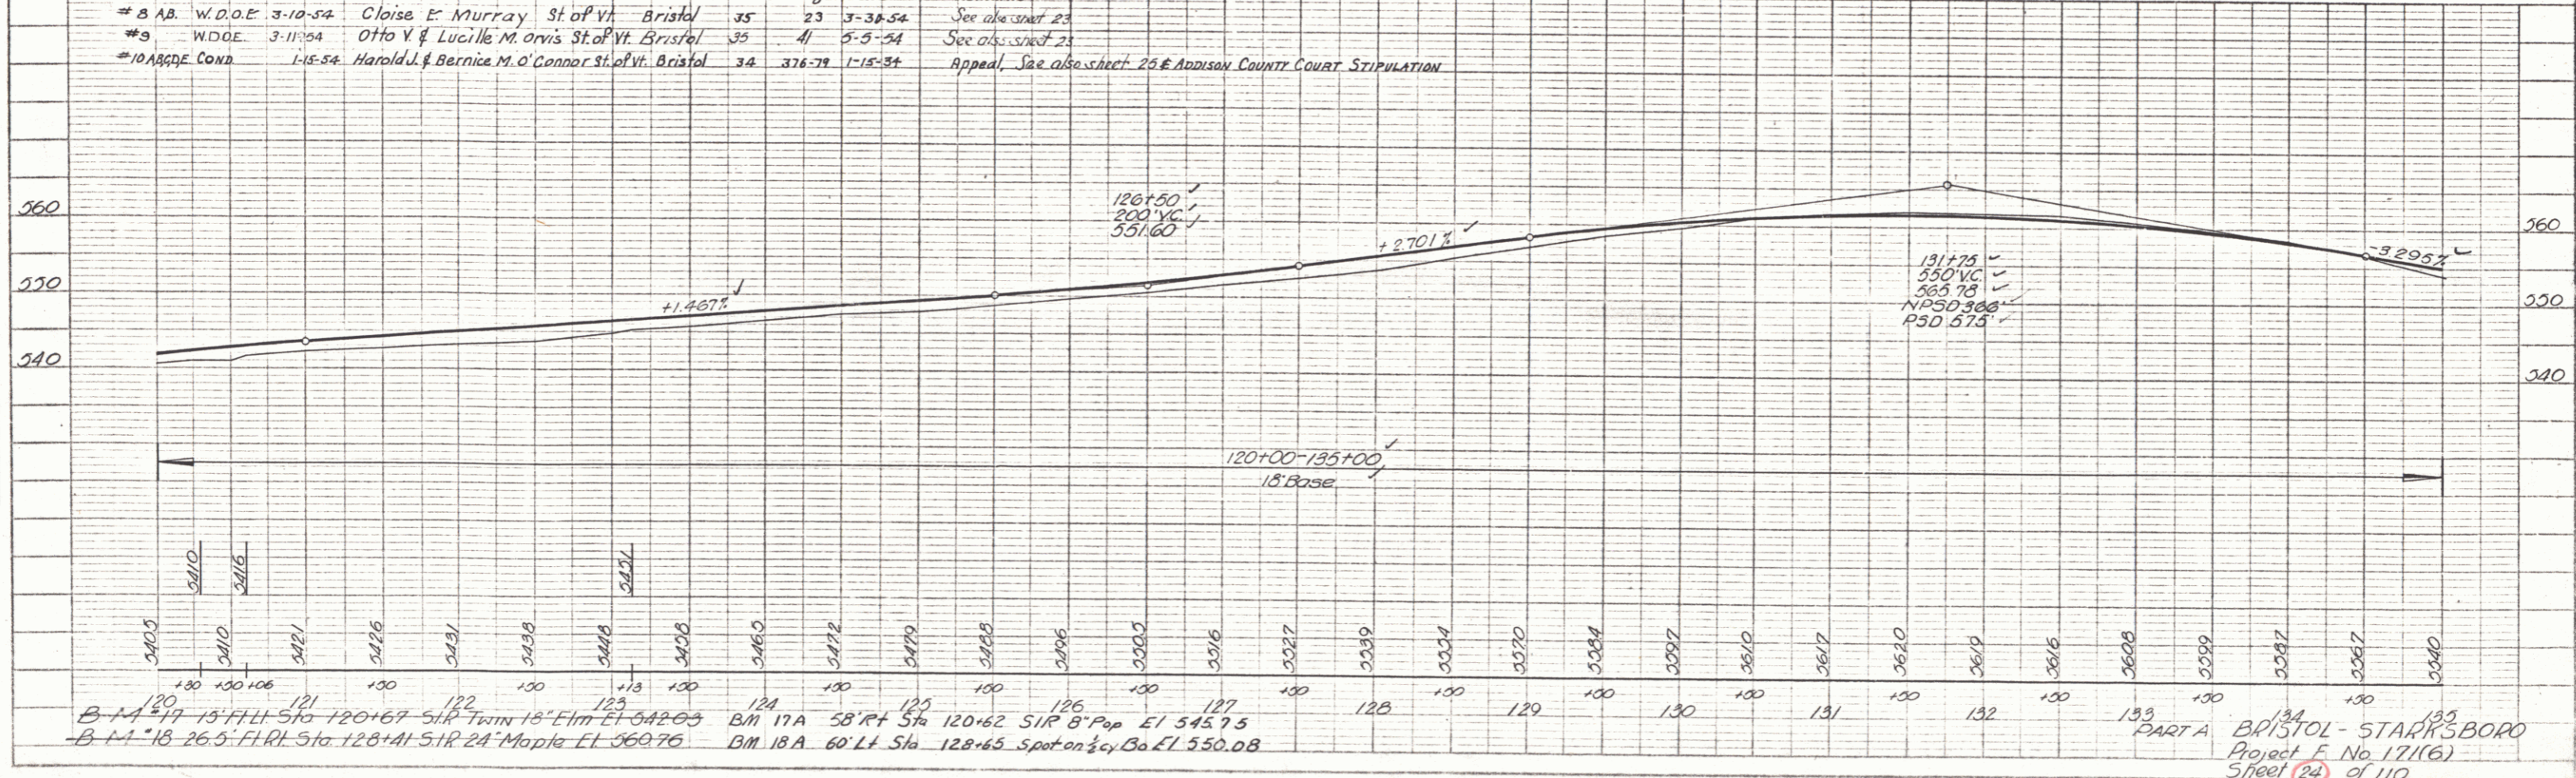

B.M. 17 13' Ht. 510 120+67 51R Twin 18' Elm El 542.03
 B.M. 18 26.5' FLRL 510 128+41 51R 24' Maple El 560.76
 B.M. 17A 58' RT 510 120+62 51R 8' Pop El 545.75
 B.M. 18A 60' LT 510 128+65 Spot on 1/2 cy B El 550.08

PLATE 1 - PLAN PROFILE & P&R DRAWING
 SCALE: 1" = 40' HORIZ. 1" = 4' VERT.
 DATE: 10/15/54