


LIST OF QUANTITIES (BRIDGE ONLY)

106A	Channel Excavation of Earth	145A	cy
106B	Channel Excavation of Rock	162	cy
107	Structure Excavation (mod)	387	cy
109	Maintenance of Traffic for Br Projects	1	15
301	Bituminous Conc Pavt for Br Floors	15	ton
401B	Concrete Class B (mod)	41	cy
401C	Concrete Class C (mod)	240	cy
402	Reinforcing Steel	15260	lb
403A	Structural Steel	24078	lb
407	Asphaltic Asbestos Coating	10	cy
492	Removal of Present Superstructure	1	13
501	Furnishing Equip for Driving Piles	1	13
502A	Ultrason Timber Piling	2450	lf
502B	Cutoffs for Timber Piling	210	lf
502C	Metal Shoes for Timber Piling	70	each
542	Two Cable Guard Rail	70	lf

LIST OF SHEETS (Bridge Only)

10	Preliminary Information Sheet
11	Details of Abut No. 1
12	Details of Abut No. 2
13	Reinforcing Steel
14	Earthwork Sheet
15	Std Dwg. 5B-20 (Det. D.F.H.) K.L.L.
16	Std Dwg. 5B-30 (H20) 30' Span-30' Skew
17	Std Dwg. 5B-11
18	Std Dwg. 5B-5-1
101-110	Channel Sections

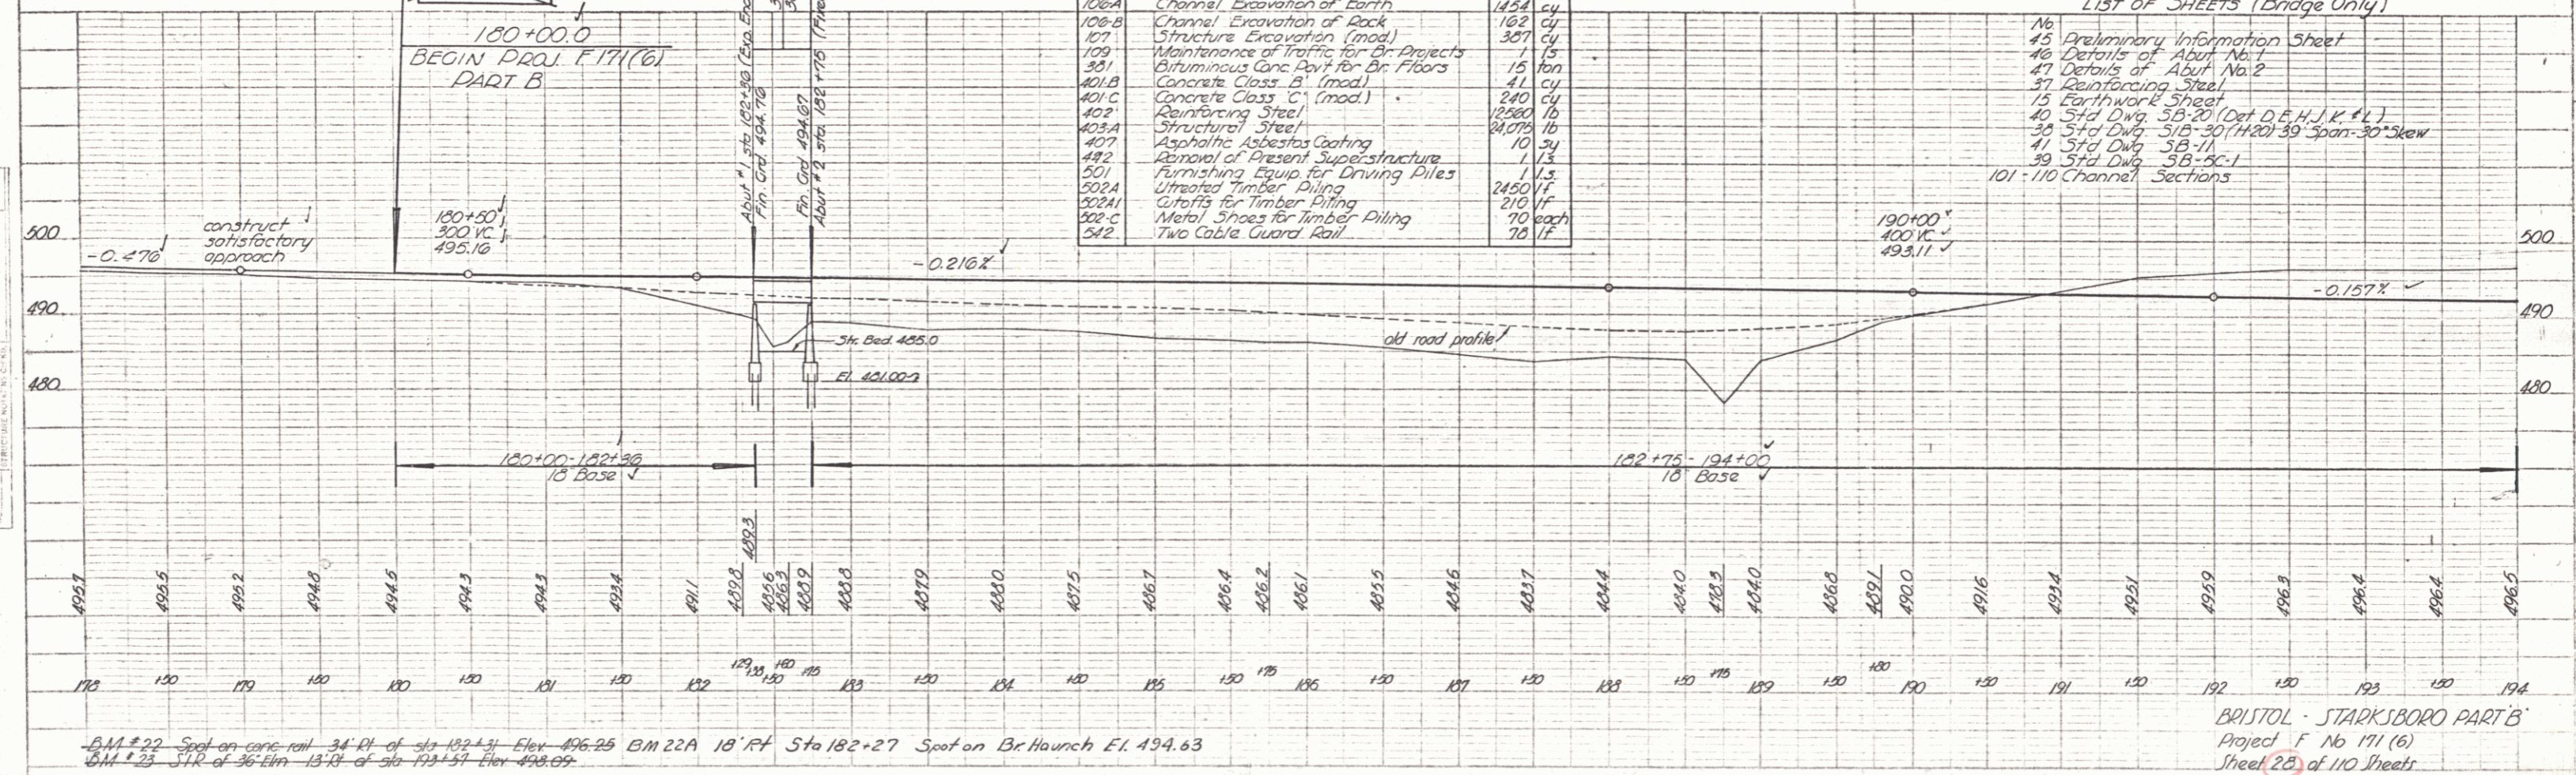

BM 22 Spot on care rail 34' Rt of Sta 182+31 Elev 496.25 BM 22A 18' Rt Sta 182+27 Spot on Brittaunch El. 494.63  
 BM 23 STR of 36' km 13-13 of 30 193+51 Elev 498.09

BRISTOL - STARKSBORO PART B  
 Project F No 171 (6)  
 Sheet 20 of 110 Sheets