


PLAN
 DATE 9-27-52
 DRAWN BY J. B. BOSTER
 CHECKED BY L. W. LAMM

PROFILE
 DATE 9-27-52
 DRAWN BY J. B. BOSTER
 CHECKED BY L. W. LAMM



Control of Section of Old Highway Between Sta. 219+70 RT. And
Sta. 238+75 RT. Relinquished To Town of Starksboro. Recorded
Book 22, Page 522. Date Sept 23, 1955.

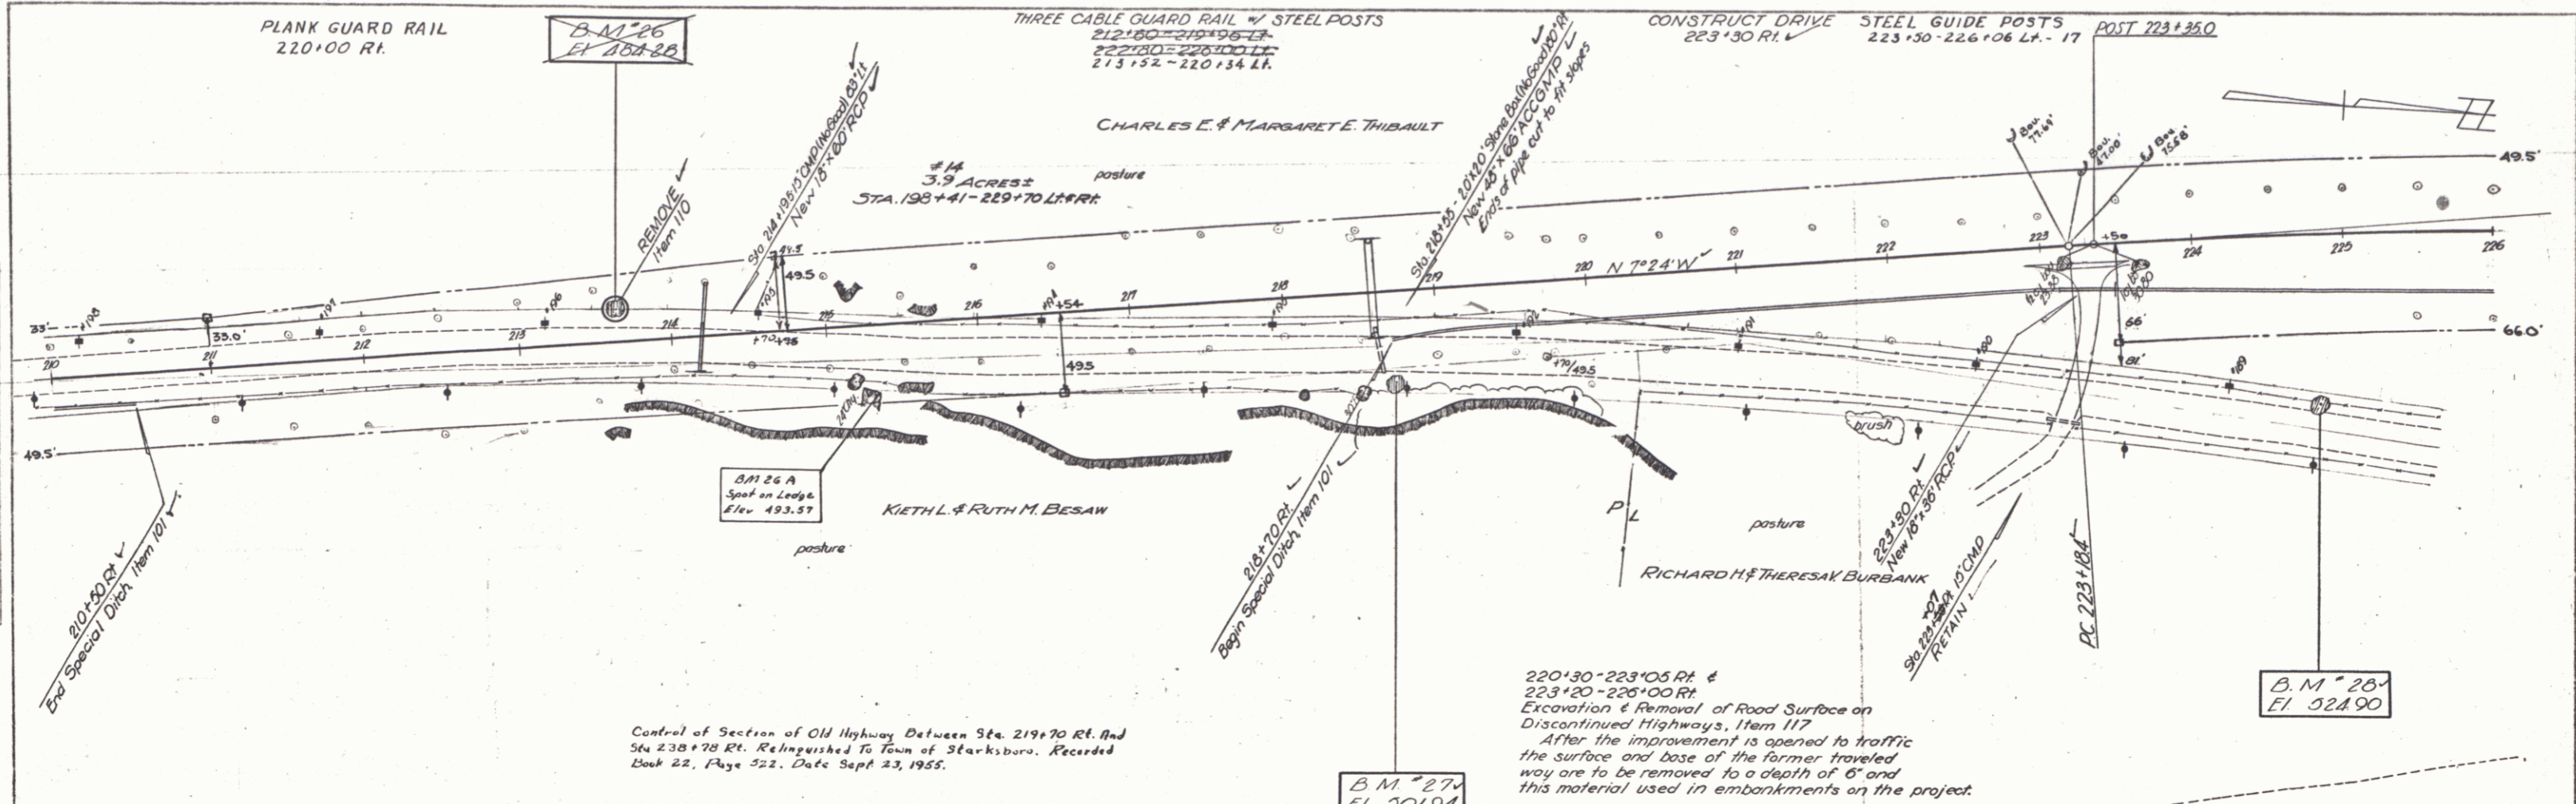