


NON-GOVT PARTICIPATION
 3/10/88 install sleeve for water pipe
 across roadway. Item 103 Non-Govt.
 Sleeve to be furnished by property
 owner.

Construct 8' Shoulder
 13+75 - 16+50 Rt

Construct Two-Cable Guard-Rail
 18+00 - 18+80 Lt
 18+80 - 19+00 Lt
 19+00 - 20+53 Lt
 21+50 - 47+43 Lt


Wood Guide Posts
 18+00 - 18+80 Lt
 18+80 - 19+00 Lt
 19+00 - 20+53 Lt
 21+50 - 28+00 Lt
 WOOD GUIDE POSTS
 STA Lt Rt
 14+56-14+88 3 16%
 17+42 1
 19+96 1
 25+50 1

Construct Drives
 Lt Rt
 18+00 18+00
 18+80 18+80
 19+00 19+00
 20+53 20+53
 21+50 21+50
 25+50 25+50

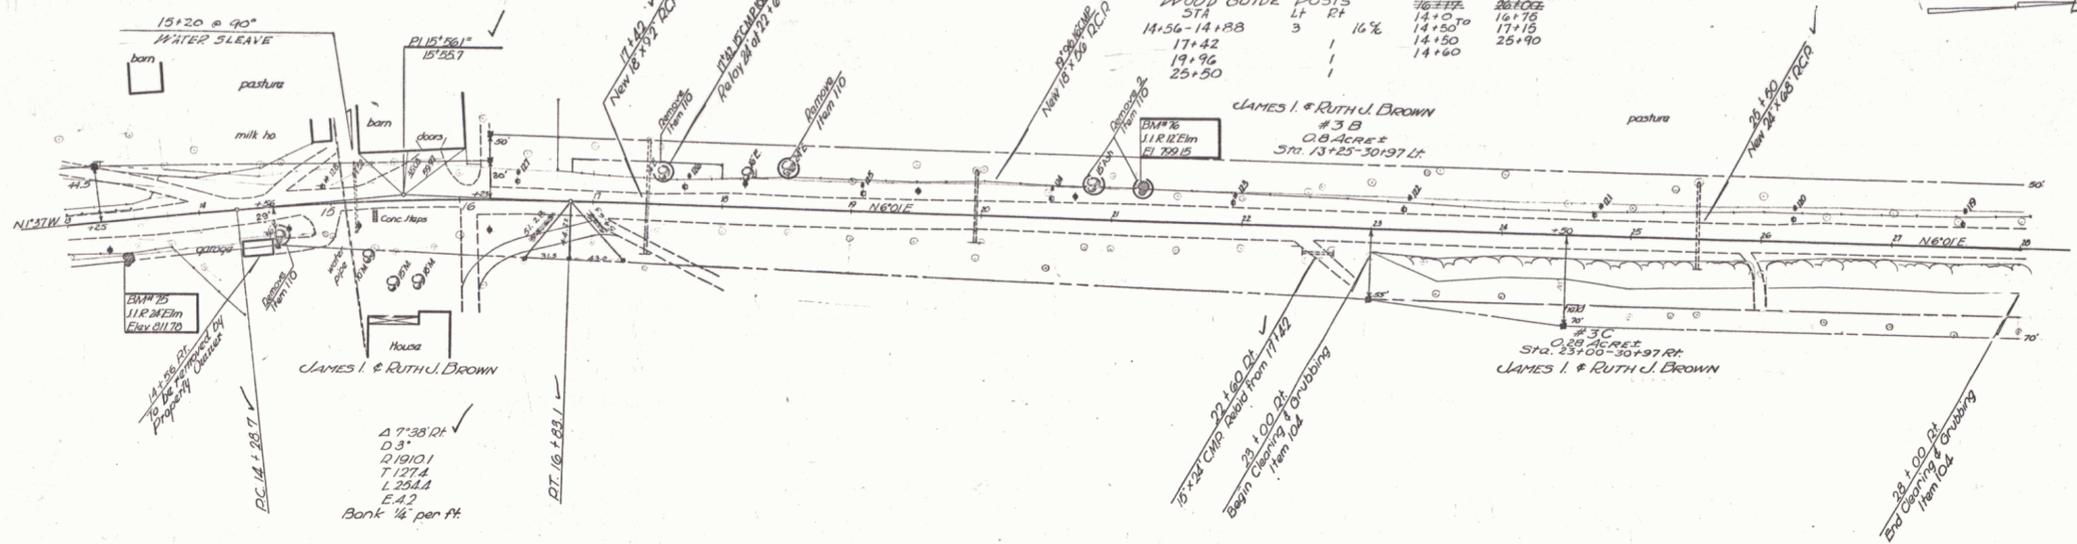

PLAN	DATE	BY	CHKD
9/20	9/20	JR	JR
9/20	9/20	JR	JR
9/20	9/20	JR	JR

PROFILE	DATE	BY	CHKD
9/20	9/20	JR	JR
9/20	9/20	JR	JR
9/20	9/20	JR	JR

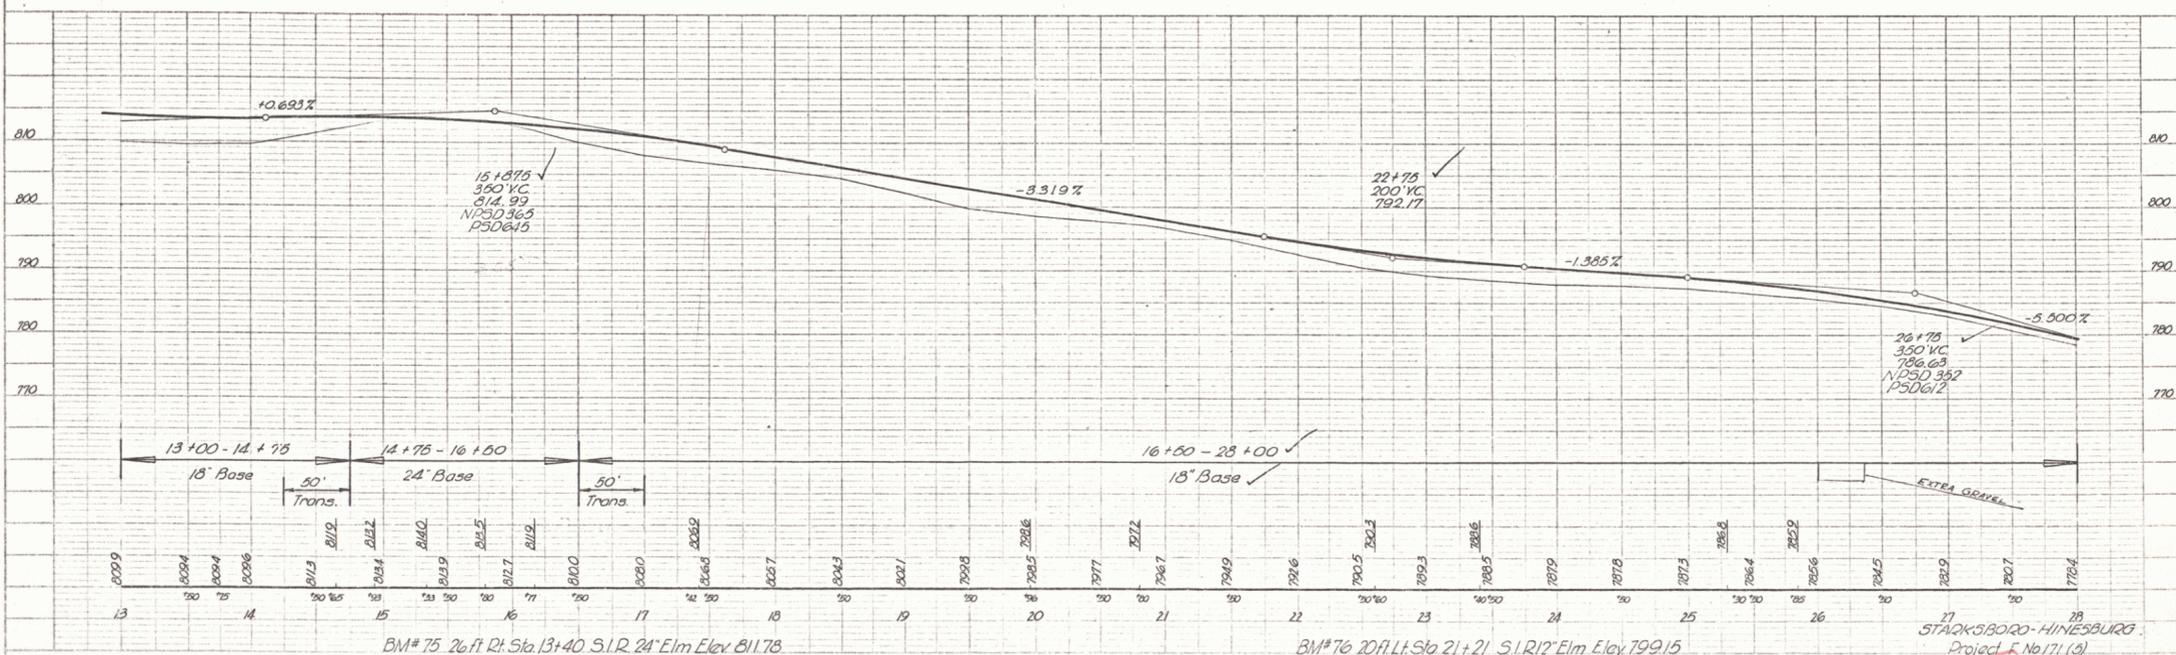

STARXSBORO-HINESBURG
 Project No 171 (3)
 Sheet 14 of 104