


PLAN	DATE	BY
APPROVED	9/30	W.H.
REVISIONS		
NO.	DESCRIPTION	DATE
1	As Shown	9/30
2	As Shown	11-30

DATE	BY
9/30	W.H.
11-30	H.H.

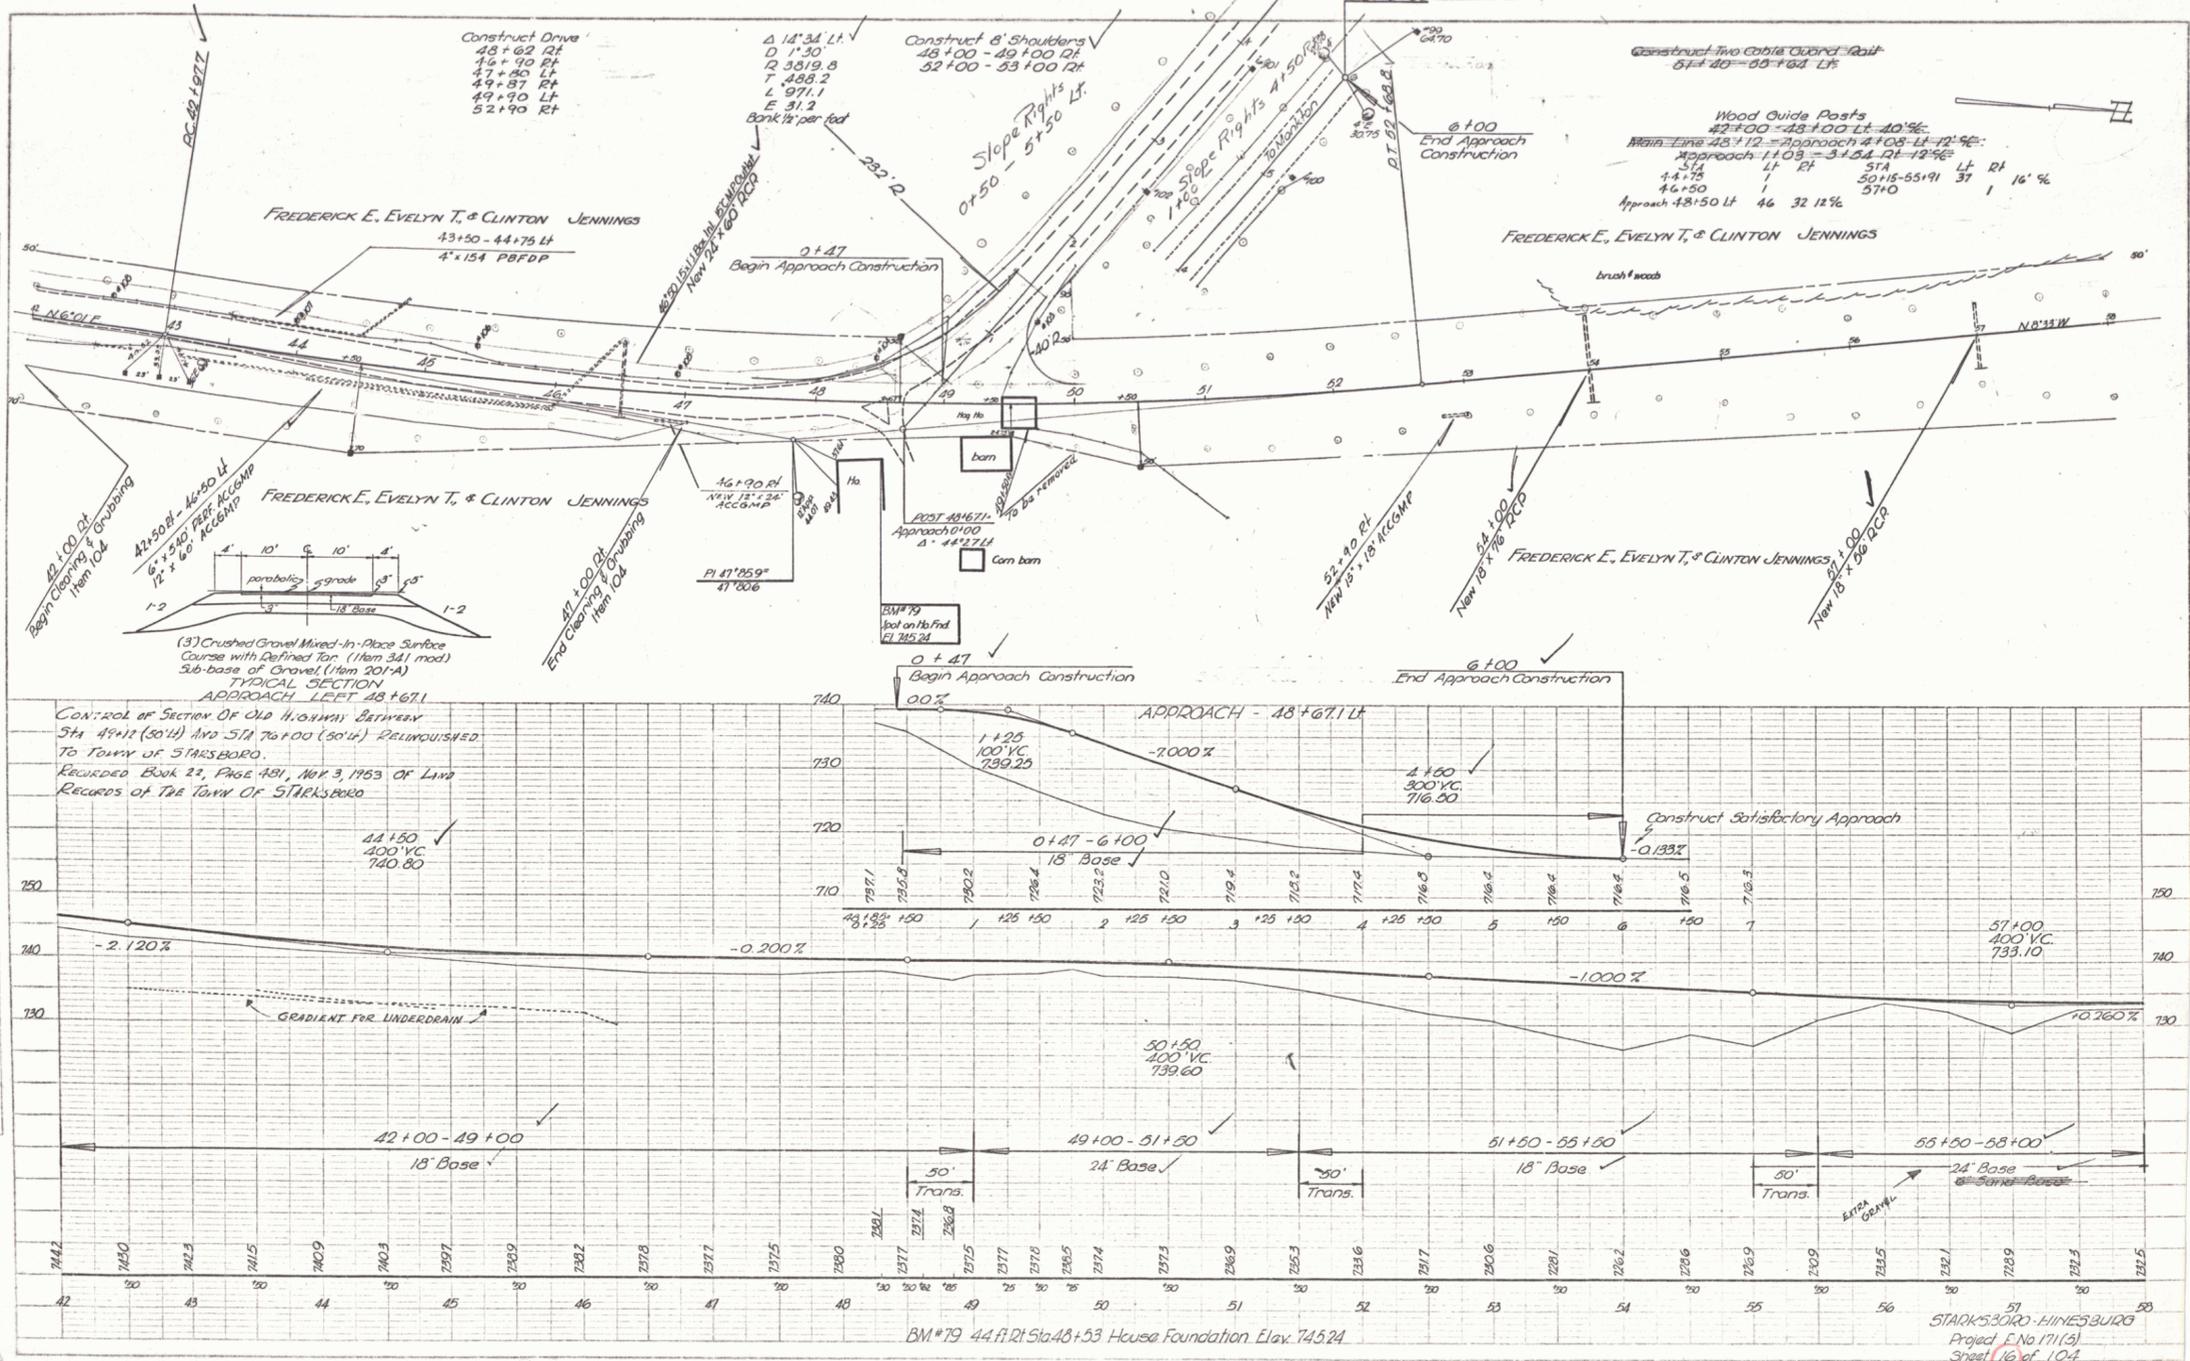

BM #79 44 ft. Rt Sta. 48+53 House Foundation Elev. 745.24

STARKSBORO - LINESBURG  
 Project E No 1711(3)  
 Sheet 16 of 104