


PLAN  
 DATE 9-23-09  
 DRAWN BY J. HURLEY  
 CHECKED BY J. HURLEY  
 NO. 1120

FILE NO. 9-23-09  
 DATE 9-23-09  
 DRAWN BY J. HURLEY  
 CHECKED BY J. HURLEY  
 NO. 1120



Parcel	Instn	Date	Grantor	Grantee	Recorded	Book	Page	Date	Remarks
#7	W.D.O.E.	6-4-52	Carroll & Ruthena M. Zeno	St. of Vt.	Starksboro	22	434	6-11-52	
#B,A,B,C	W.D.O.E.	6-4-52	Kenneth H. & Wilma J. Besaw	St. of Vt.	Starksboro	22	438	6-11-52	See Sheet 20
#B,D	W.D.O.E.	1-2-53	"	"	"	22	464	1-8-53	Ditch & Drains Plans

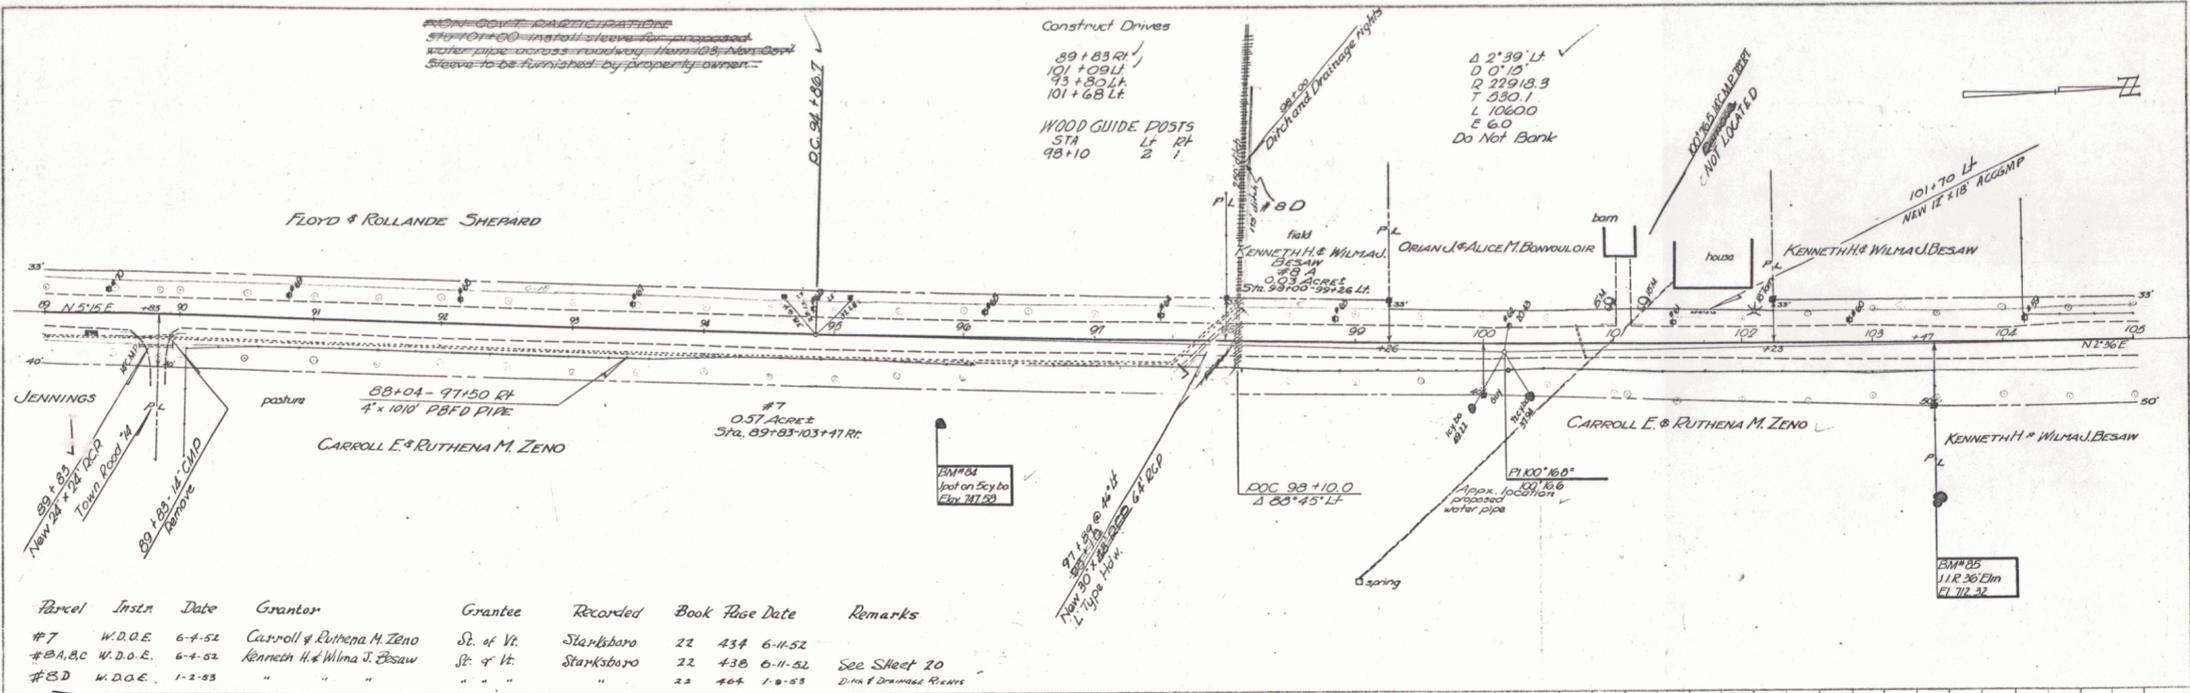