



PLAN
 DRAWN BY: S. J. HURBY
 DATE: 11/29/79
 PROJECT: 118

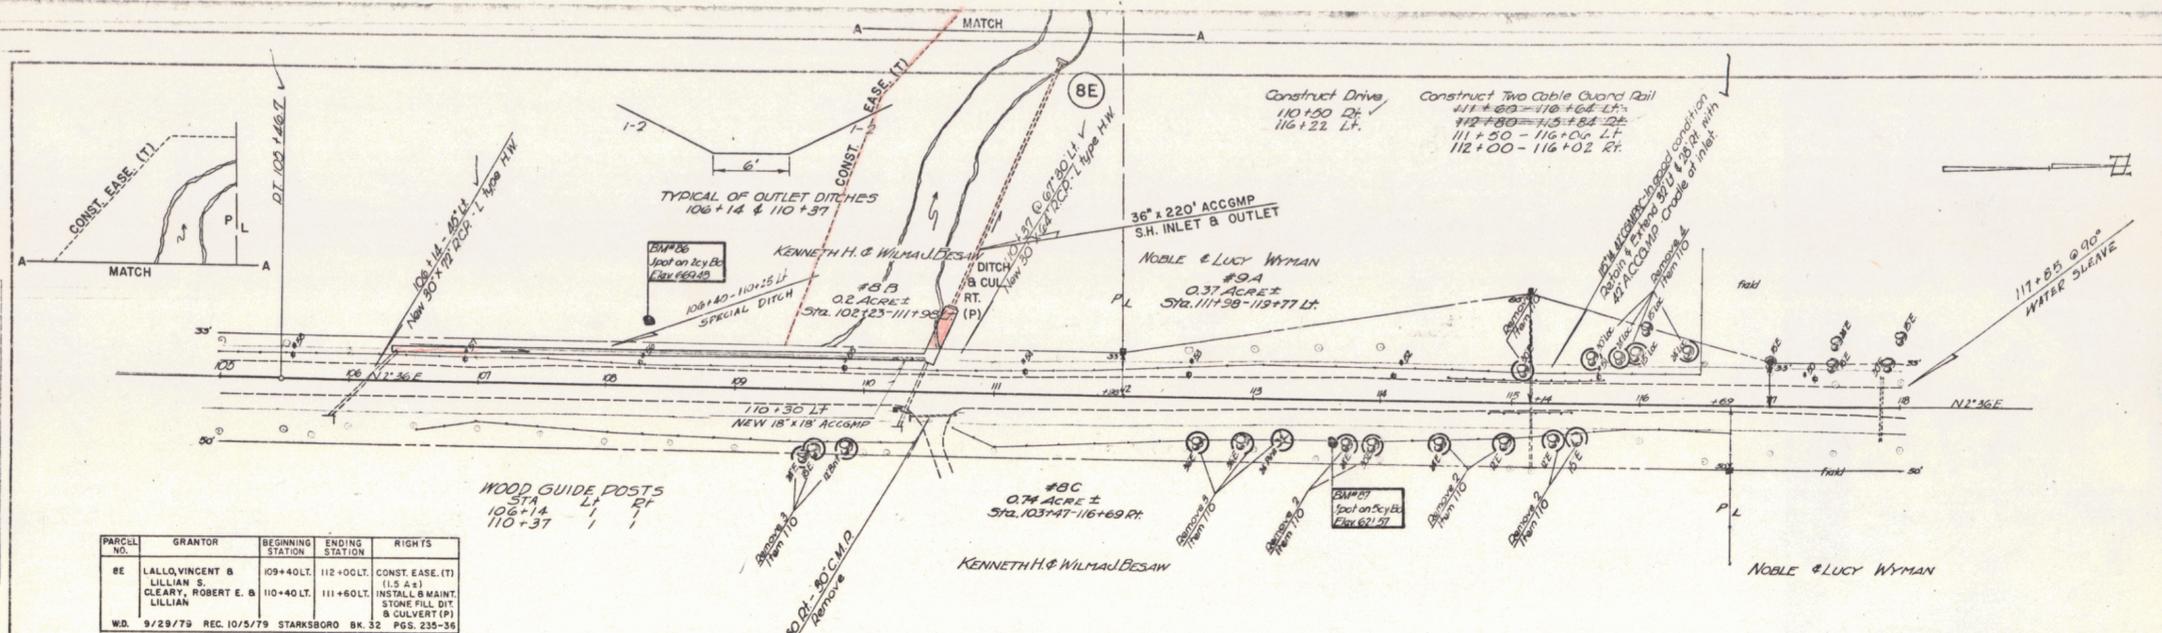

PARCEL NO.	GRANTOR	BEGINNING STATION	ENDING STATION	RIGHTS
BE	LALLQ, VINCENT & LILLIAN S. CLEARLY, ROBERT E. & LILLIAN	109+40 LT.	112+00 LT.	CONST. EASE. (T) (1.9 A)
		110+40 LT.	111+60 LT.	INSTALL & MAINT. STONE FILL DITCH & CULVERT (P)
WD.	9/29/79 REC. 10/5/79 STARKSBORO BK. 32 PGS. 235-36			

Parcel	Inst.	Date	Grantor	Grantee	Recorded	Book	Page	Date	Remarks
#9A, B, C, D	Condemn	5-52	Noble & Lucy Wyman	St. of Vt.	Starksboro	22	49	5-6-52	See Sheets 21, 22

PROFILE
 DRAWN BY: S. J. HURBY
 DATE: 11/29/79
 PROJECT: 118

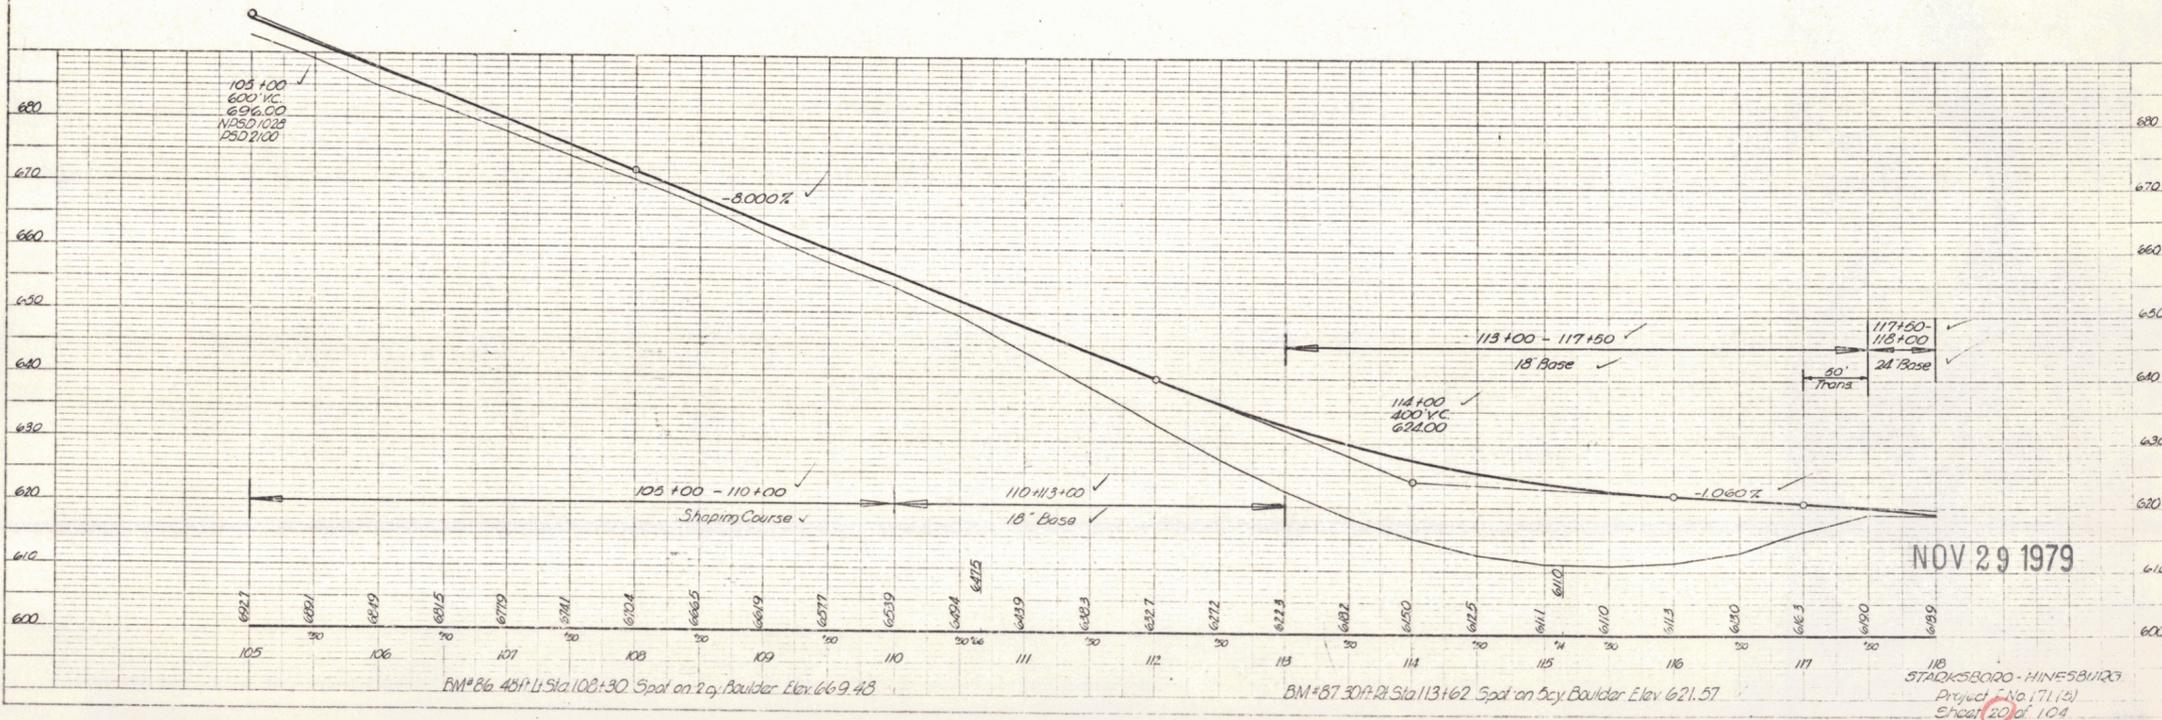

NOV 29 1979

118 STARKSBORO - HINESBURG
 Project No. 171(2)
 Sheet 20 of 104