


PLAN  
 DATE 2-20-50  
 DRAWN BY J. J. HURLEY  
 CHECKED BY J. J. HURLEY  
 SCALE 1" = 40'

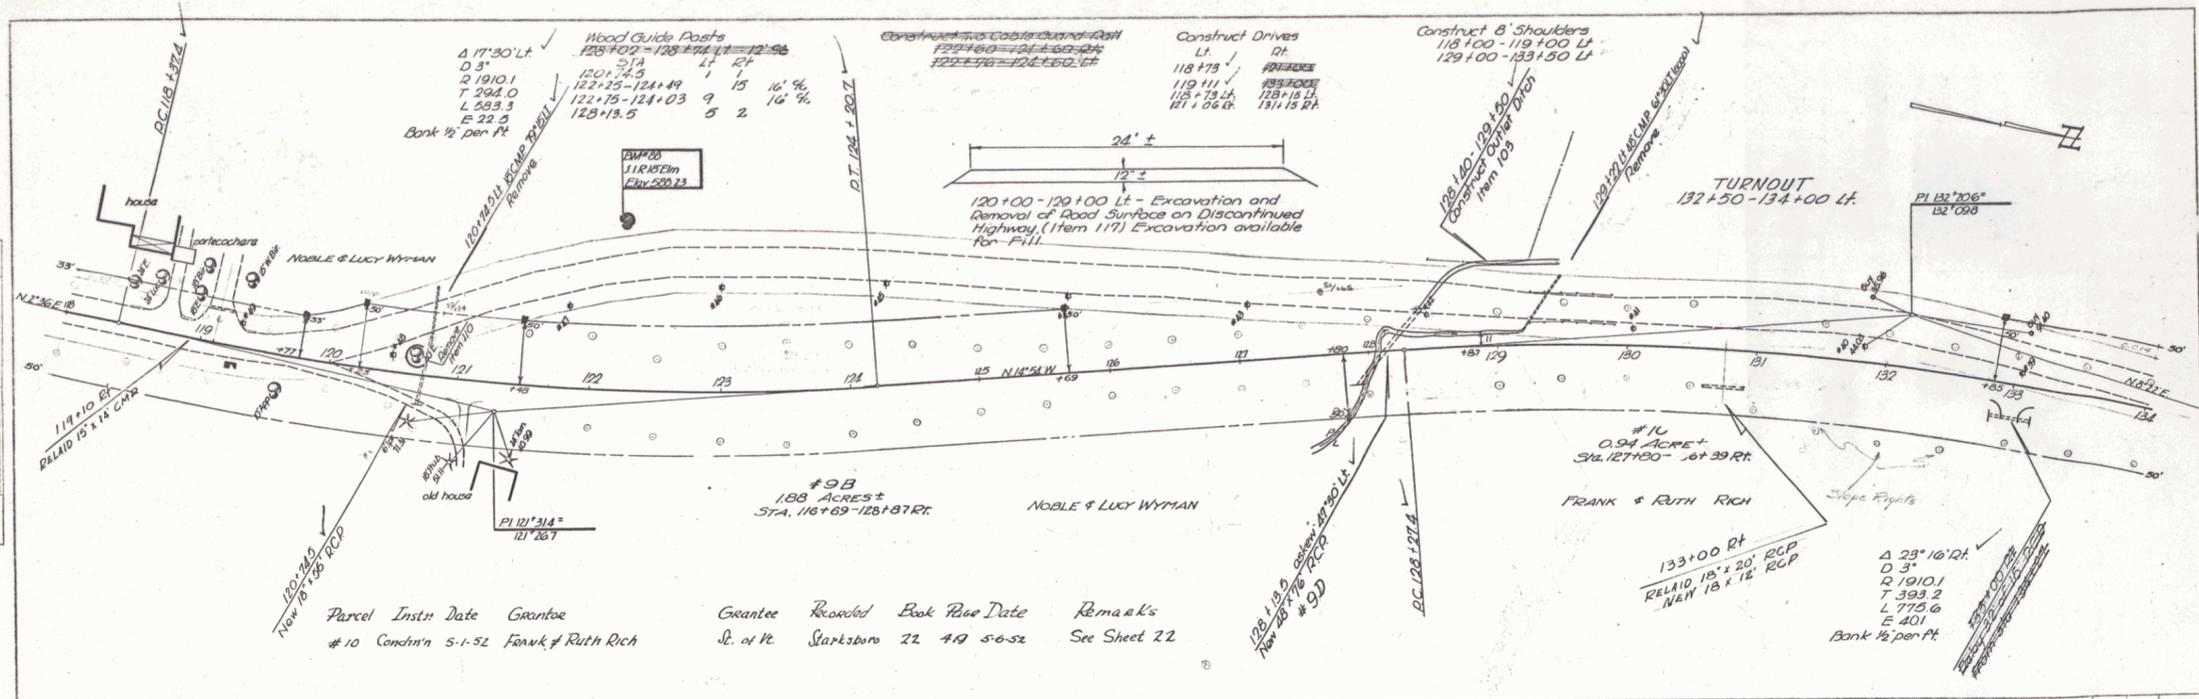

PROFILE  
 DATE 2-20-50  
 DRAWN BY J. J. HURLEY  
 CHECKED BY J. J. HURLEY  
 SCALE 1" = 40'

