



PLAN  
 DRAWN BY: [Signature]  
 CHECKED BY: [Signature]  
 DATE: 11/20/12

PROFILE  
 DRAWN BY: [Signature]  
 CHECKED BY: [Signature]  
 DATE: 11/20/12

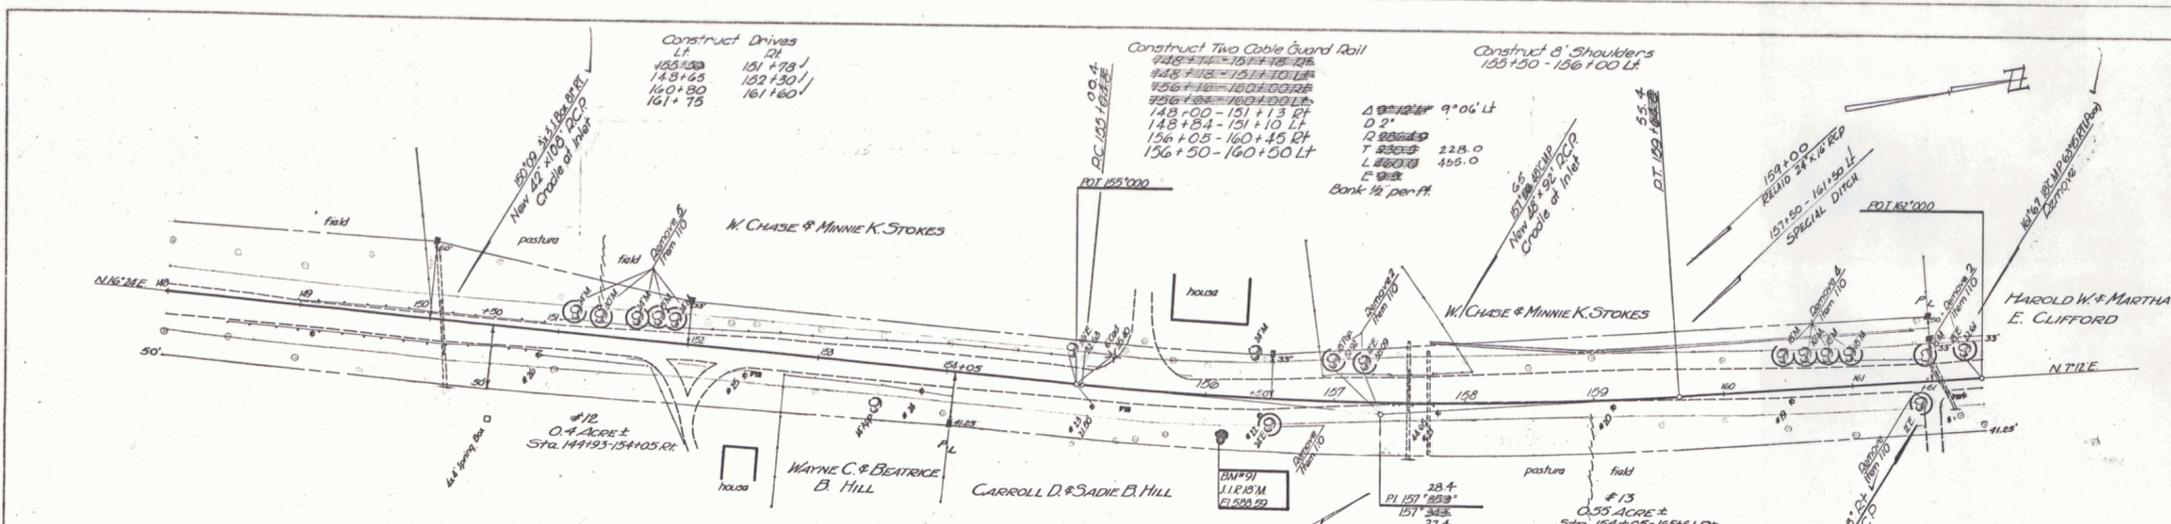

Parcel	Instr.	Date	Grantor	Grantee	Recorded	Book	Page	Date	Remarks
#12	W.D.O.E.	6-4-52	Wayne C. & Beatrice B. Hill	St. of Vt.	Starksboro	22	430	6-11-52	See Sheet 22
#13	W.D.O.E.	6-5-52	Carroll D. & Sadie B. Hill	St. of Vt.	Starksboro	22	436	6-11-52	See Sheet 24

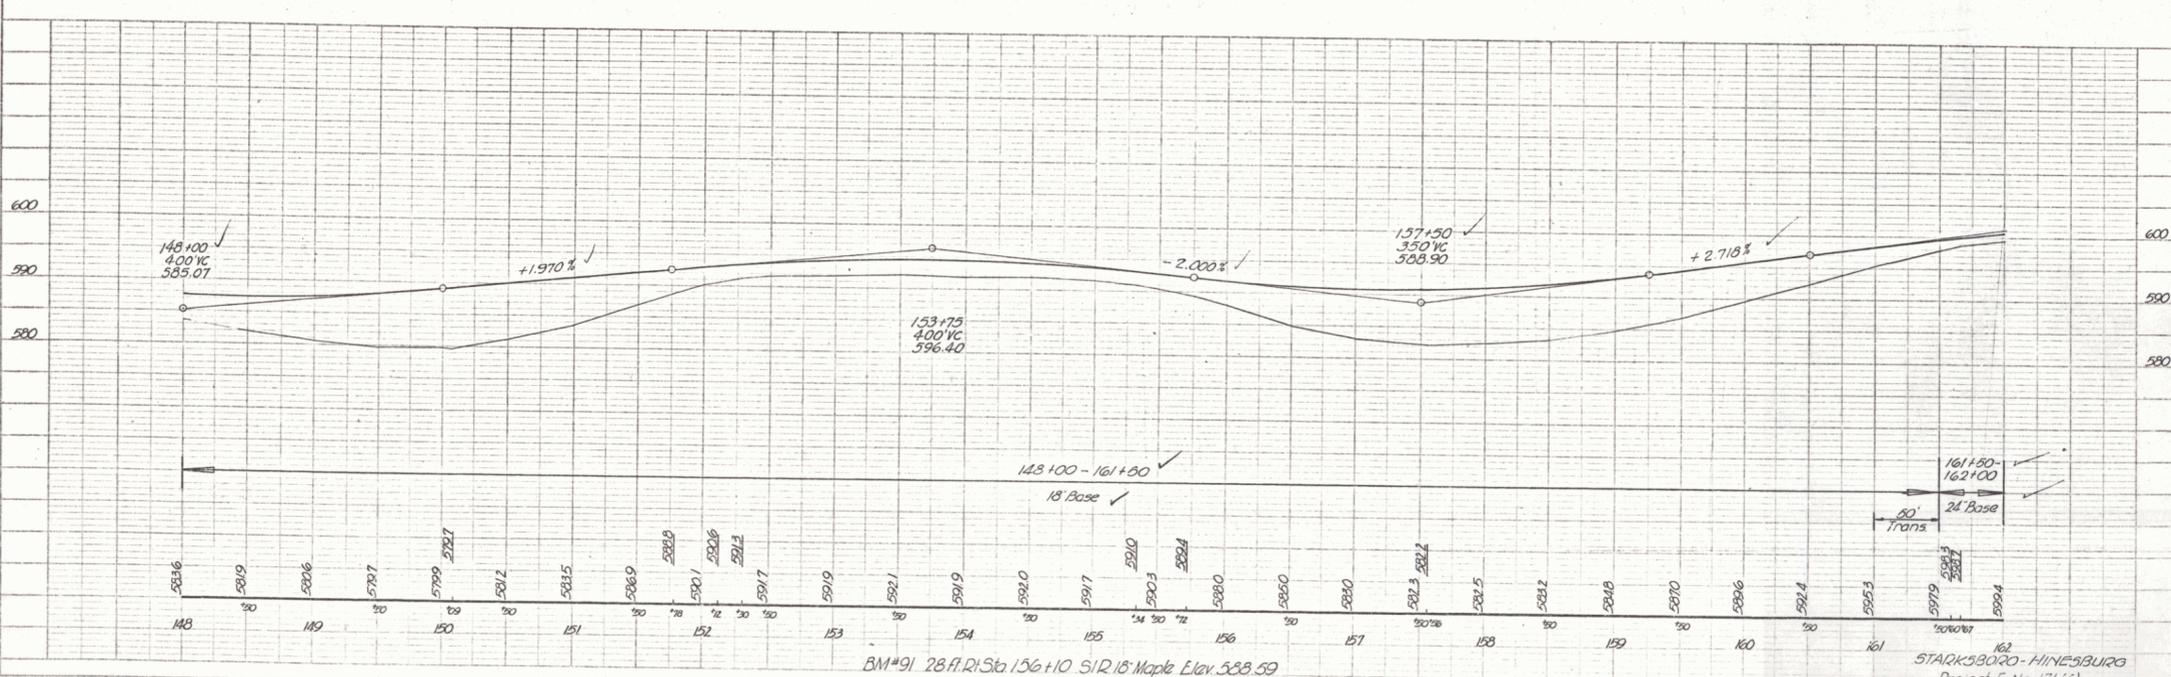

162  
 STARKSBORO - HINESBURG  
 Project No. 171(5)  
 Sheet 23 of 104