



PLAN	9/30
DATE	12/30
BY	H. Hurley
CHECKED	
DATE	
BY	

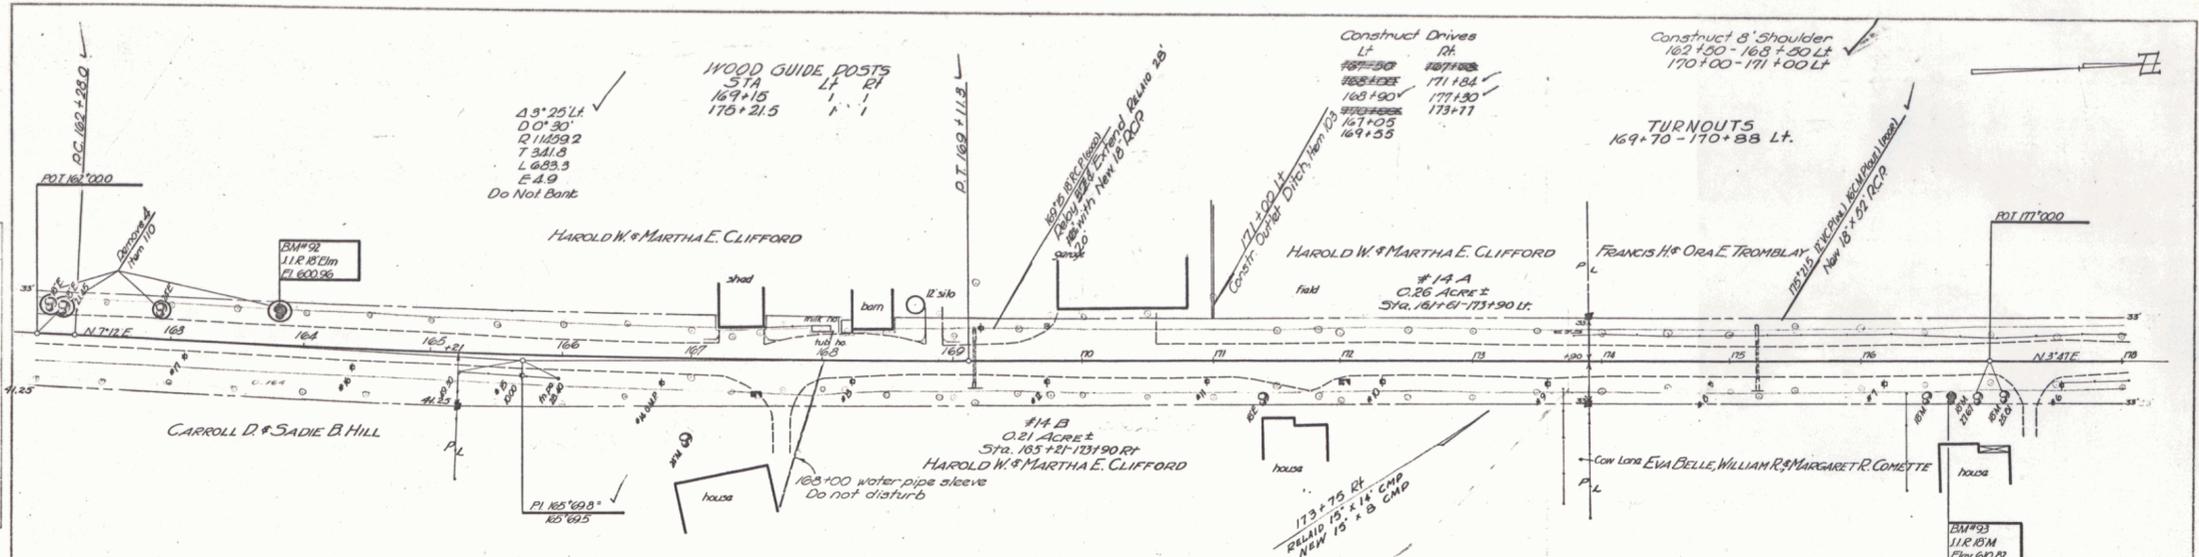

Parcel	Instr.	Date	Grantor	Grantee	Recorded	Book	Page	Date	Remarks
#14 A, B	W.D.O.E.	6-16-52	Harold W. & Martha E. Clifford	St. of W.	Starksboro	22	442	6-20-52	See Sheet 23

PROFILE	9/30
DATE	12/30
BY	H. Hurley
CHECKED	
DATE	
BY	

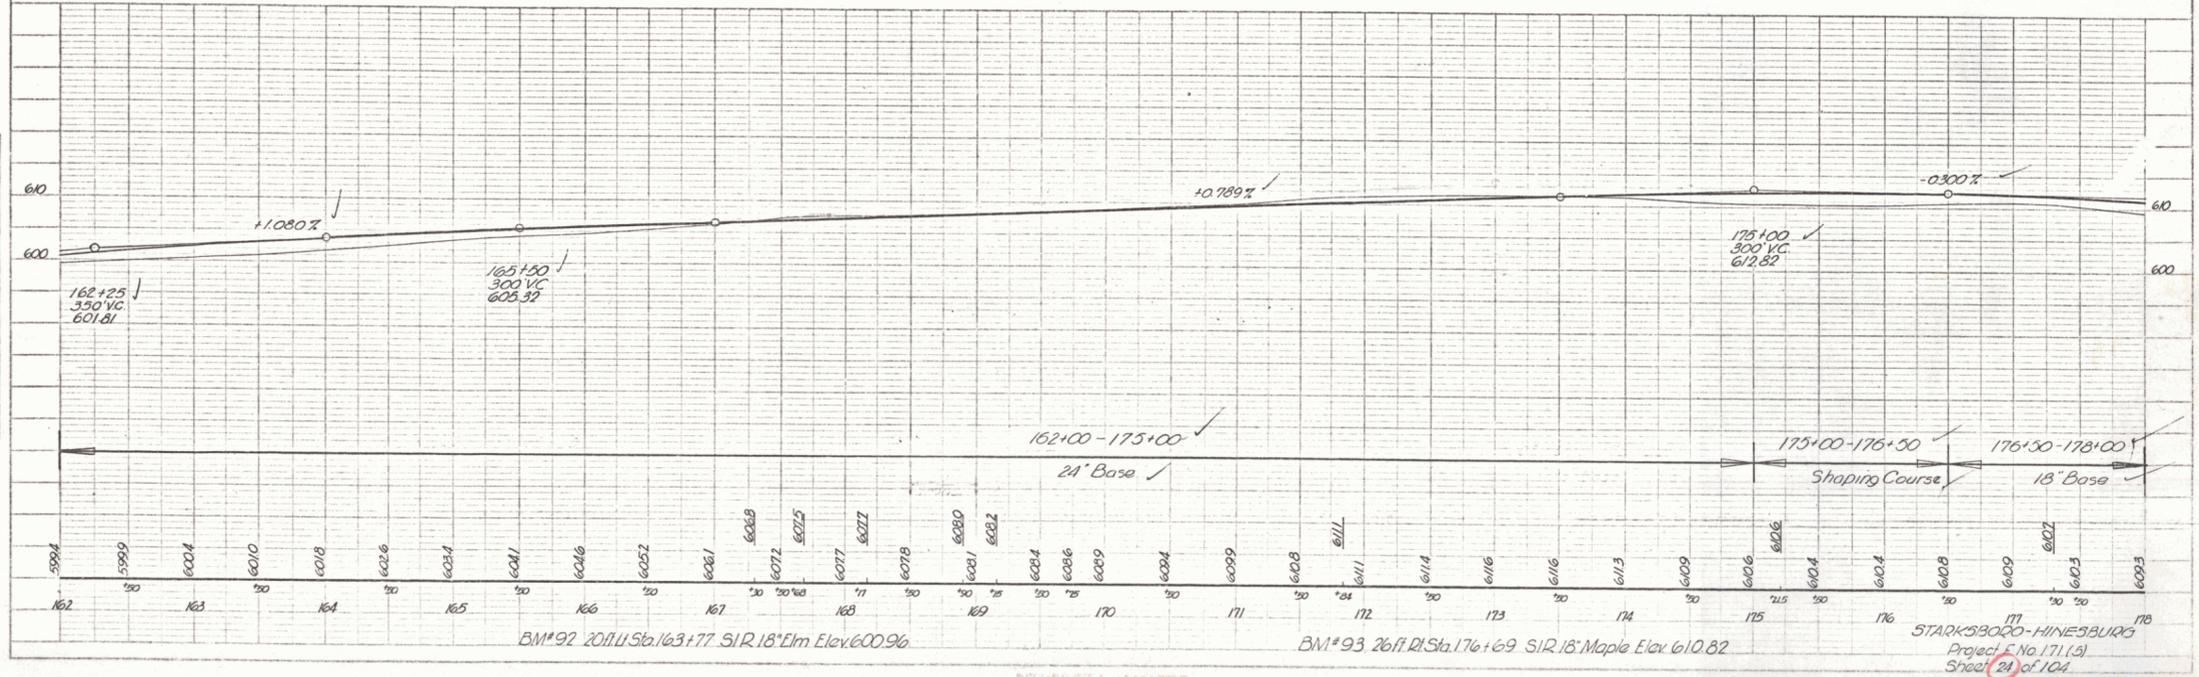

STARKSBORO-HINESBURG
 Project No. 171 (S)
 Sheet 21 of 104