

Parcel	Instr.	Date	Grantor	Grantee	Recorded	Book	Page	Date	Remarks
#15	W.D.O.E.	7-2-52	Francis H & Ora E. Tromblay	St. of Vt.	Starksboro	22	440	7-5-52	See Sheets 24, 26
#16	W.D.O.E.	6-17-52	E.B., W.R. & M.R. Comette	St. of Vt.	Hinesburg	29	245	8-18-52	See Sheet 26, 27
#17	W.D.O.E.	6-17-52	Rollin C. & Jessie A. Place	St. of Vt.	Starksboro	22	452	6-28-52	
					Hinesburg	29	193	7-7-52	


CONSTRUCT DRIVES
 PI 185+30
 185+50
 185+60 If
 185+93 If
 185+15 Rt

Construct 8' Shoulders
 185+50 - 191+50 Lt
 193+50 - 199+00 Lt


Wood Guide Posts

STA	Lt	Rt	16.96
181+46 - 183+90	10	6	
181+50 - 183+30	1	1	
184+71.5	1	1	
192+01.5	2	2	

PLAN
 DRAWN BY
 CHECKED BY
 DATE
 12/52

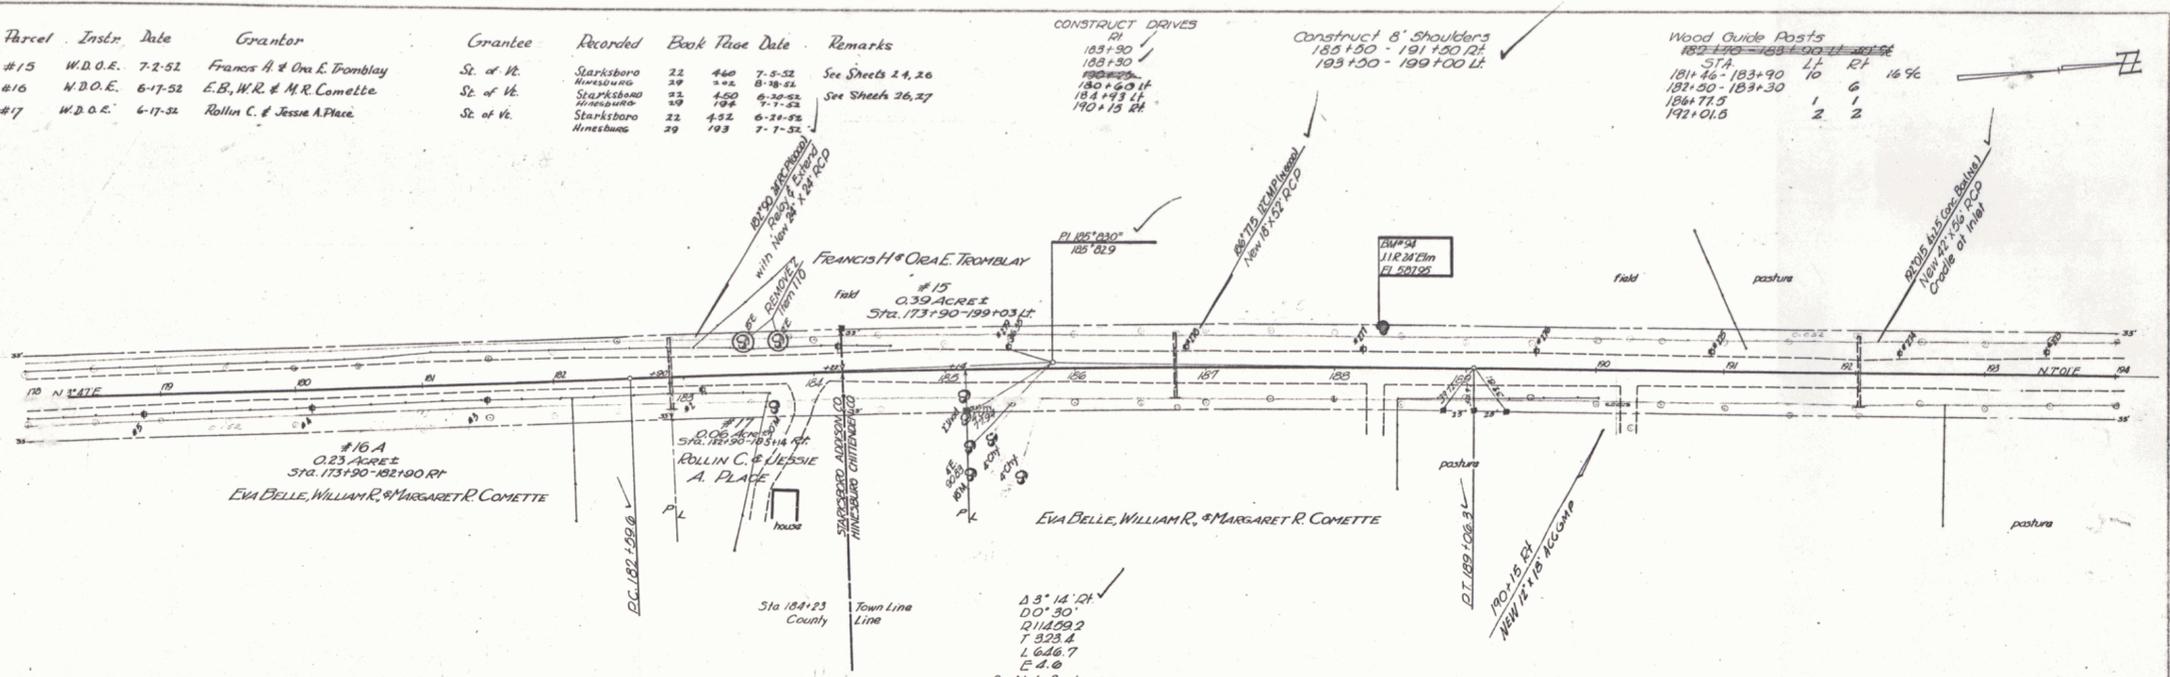

PROFILE
 DRAWN BY
 CHECKED BY
 DATE
 12/52

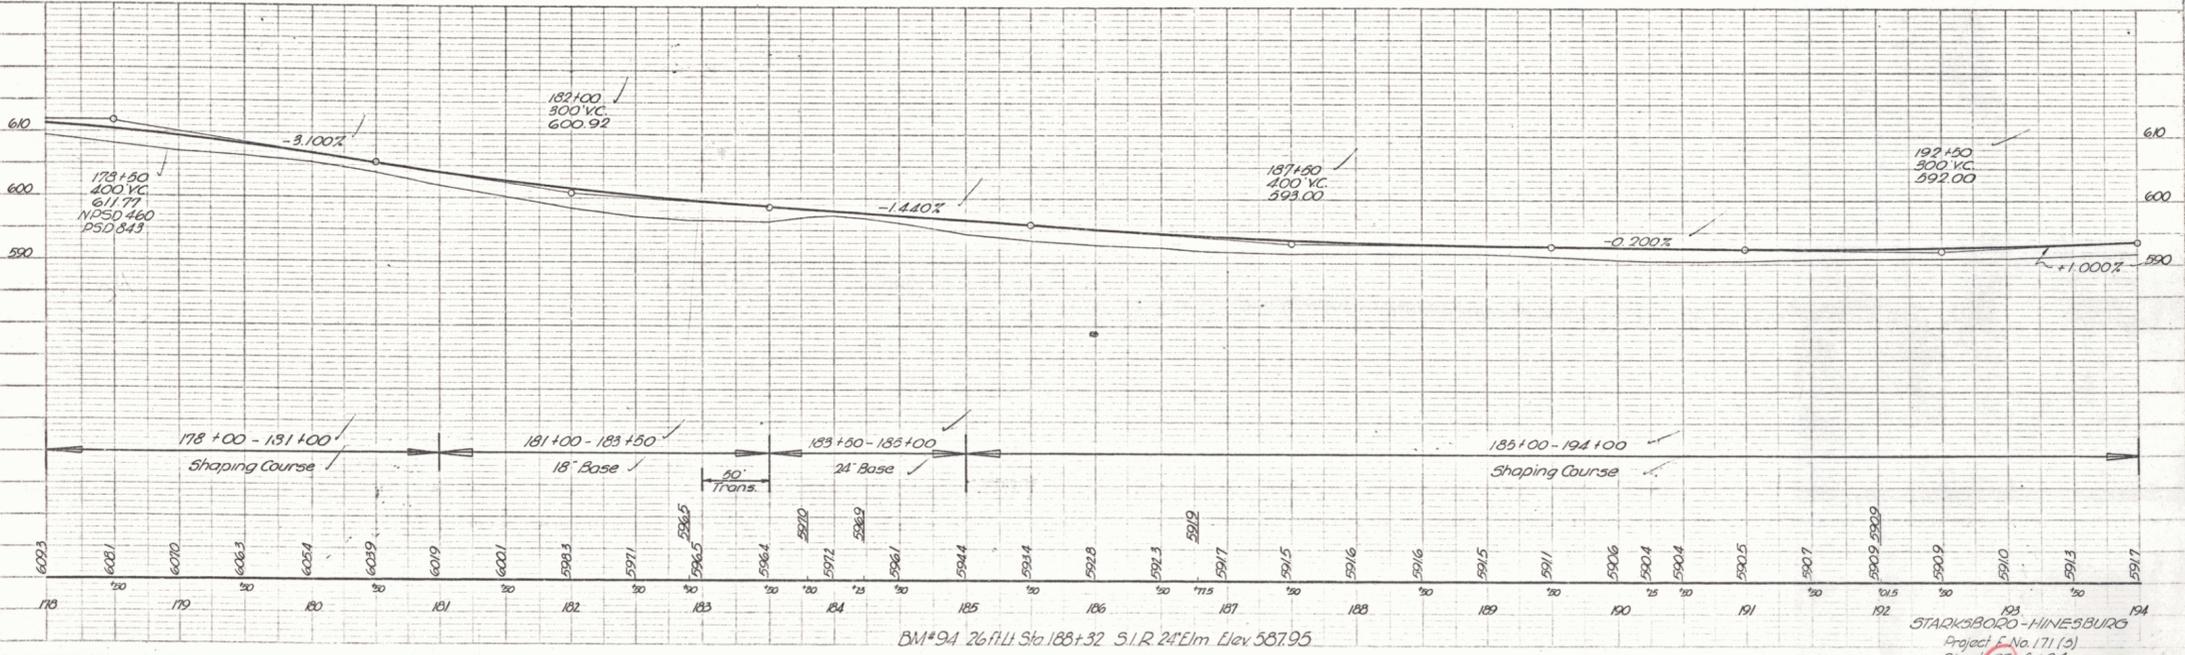

BM*94 26 ft Lt Sta 188+32 S.I.R. 24" Elm Elev 587.95

183
 STARKSBORO-HINESBURG
 Project E No. 171 (3)
 Sheet 25 of 104