




PLAN
 DATE: 1/22/52
 DRAWN BY: J. H. HARRIS
 CHECKED BY: J. H. HARRIS
 PROJECT: STARKSBORO-HINESBURG
 SHEET: 25 OF 104

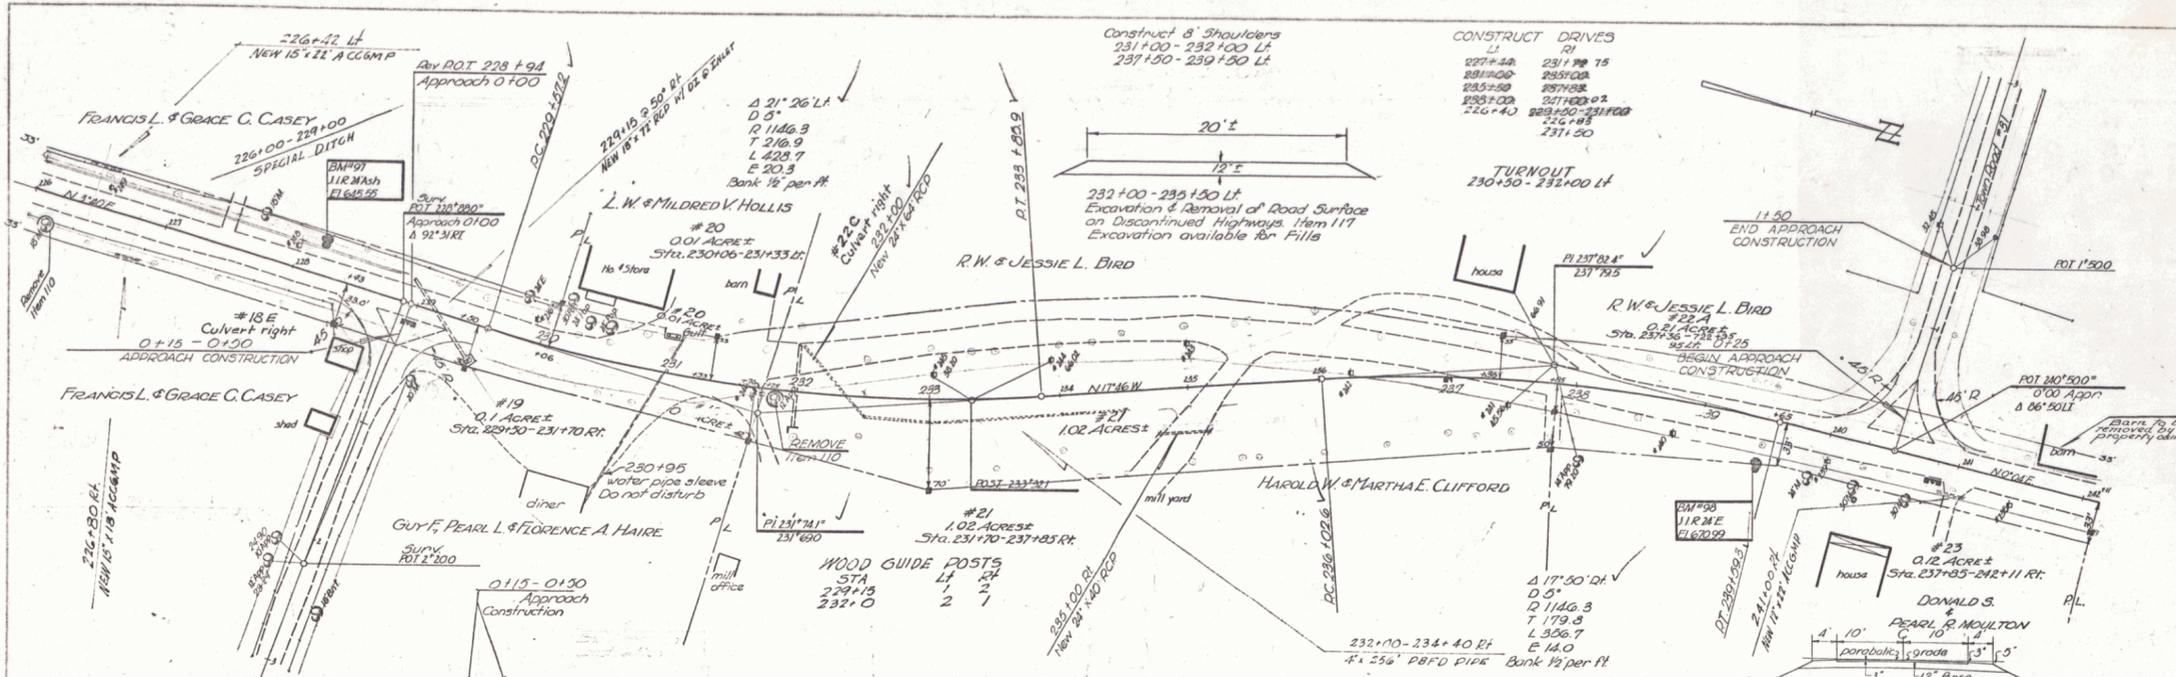

CONSTRUCT DRIVES

227+30	231+70	75
231+00	235+00	75
235+00	241+00	75
241+00	247+00	75
247+00	253+00	75
253+00	259+00	75
259+00	265+00	75
265+00	271+00	75

Parcel	Instr.	Date	Grantor	Grantee	Recorded	Book	Page	Date	Remarks
#19	Q.C.D.O.E.	6-17-52	Guy F. R.L. & F.A. Haire	St. of Vt.	Hinesburg	29	109	6-20-52	
#20	W.D.O.E.	6-17-52	L.W. & Mildred V. Hollis	St. of Vt.	Hinesburg	29	110	6-20-52	
#21	W.D.O.E.	6-16-52	Harold W. & Martha E. Clifford	St. of Vt.	Hinesburg	29	187	6-20-52	
#22	W.D.O.E.	6-16-52	Harold W. & Martha E. Clifford	St. of Vt.	Hinesburg	29	188	6-20-52	
#23	W.D.O.E.	6-25-52	Donald S. & Pearl R. Moulton	St. of Vt.	Hinesburg	29	289	7-7-53	See Sheet 29

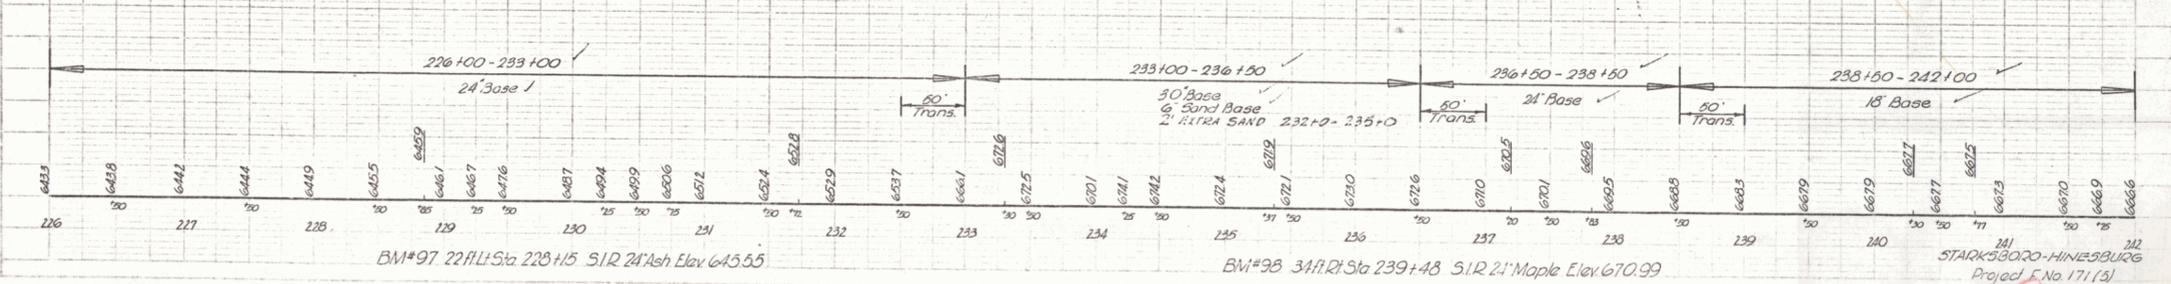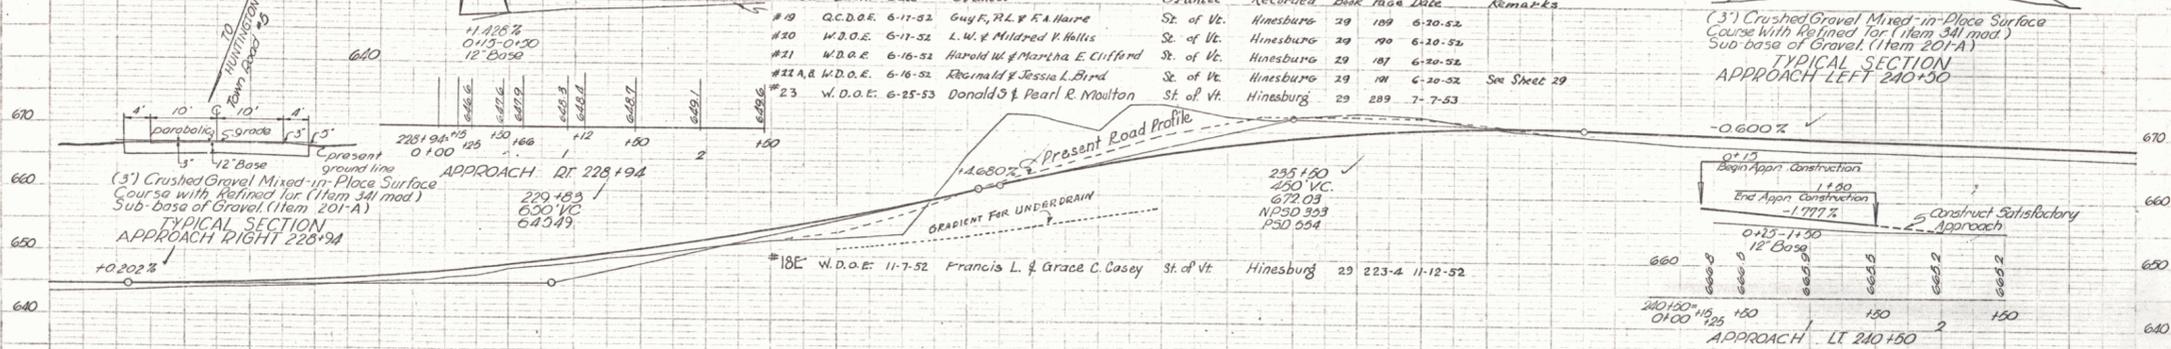

BM#97 22 Hill Sta 228+15 5.12 24' Ash Elev 645.55

BM#98 341 Rt Sta 239+48 5.12 21' Maple Elev 670.99

STARKSBORO-HINESBURG
 Project No 171(3)
 Sheet 25 of 104