
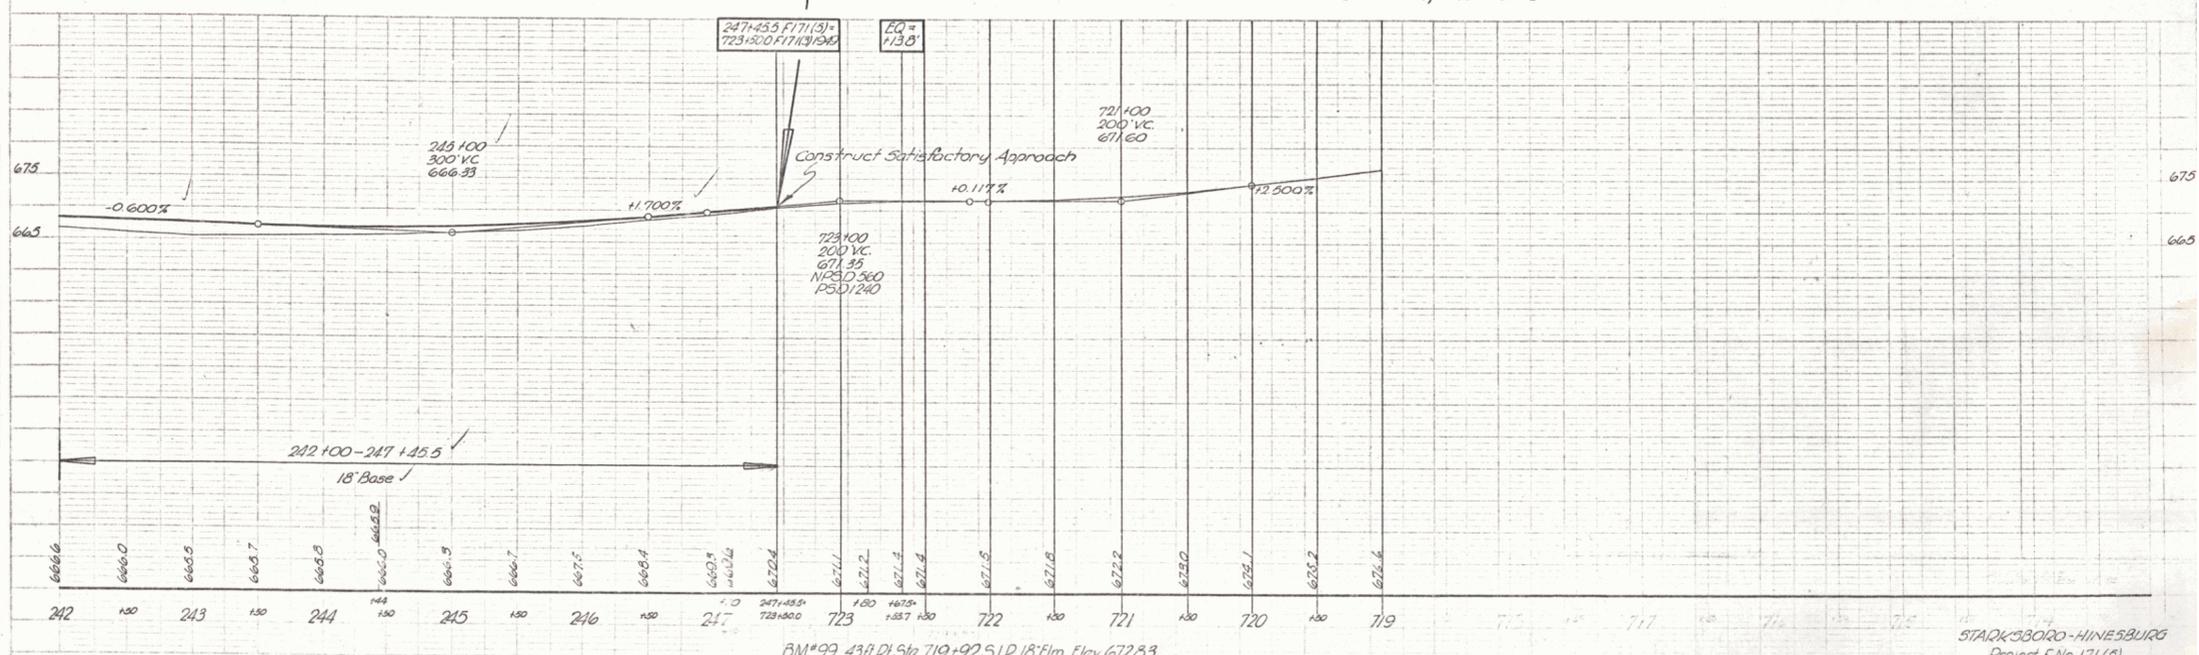


PLAN	DATE	BY
REVISION		
NO. 1	1/25/30	AP
NO. 2		
NO. 3		
NO. 4		
NO. 5		
NO. 6		
NO. 7		
NO. 8		
NO. 9		
NO. 10		

REVISION	DATE	BY
NO. 1	1/25/30	AP
NO. 2		
NO. 3		
NO. 4		
NO. 5		
NO. 6		
NO. 7		
NO. 8		
NO. 9		
NO. 10		

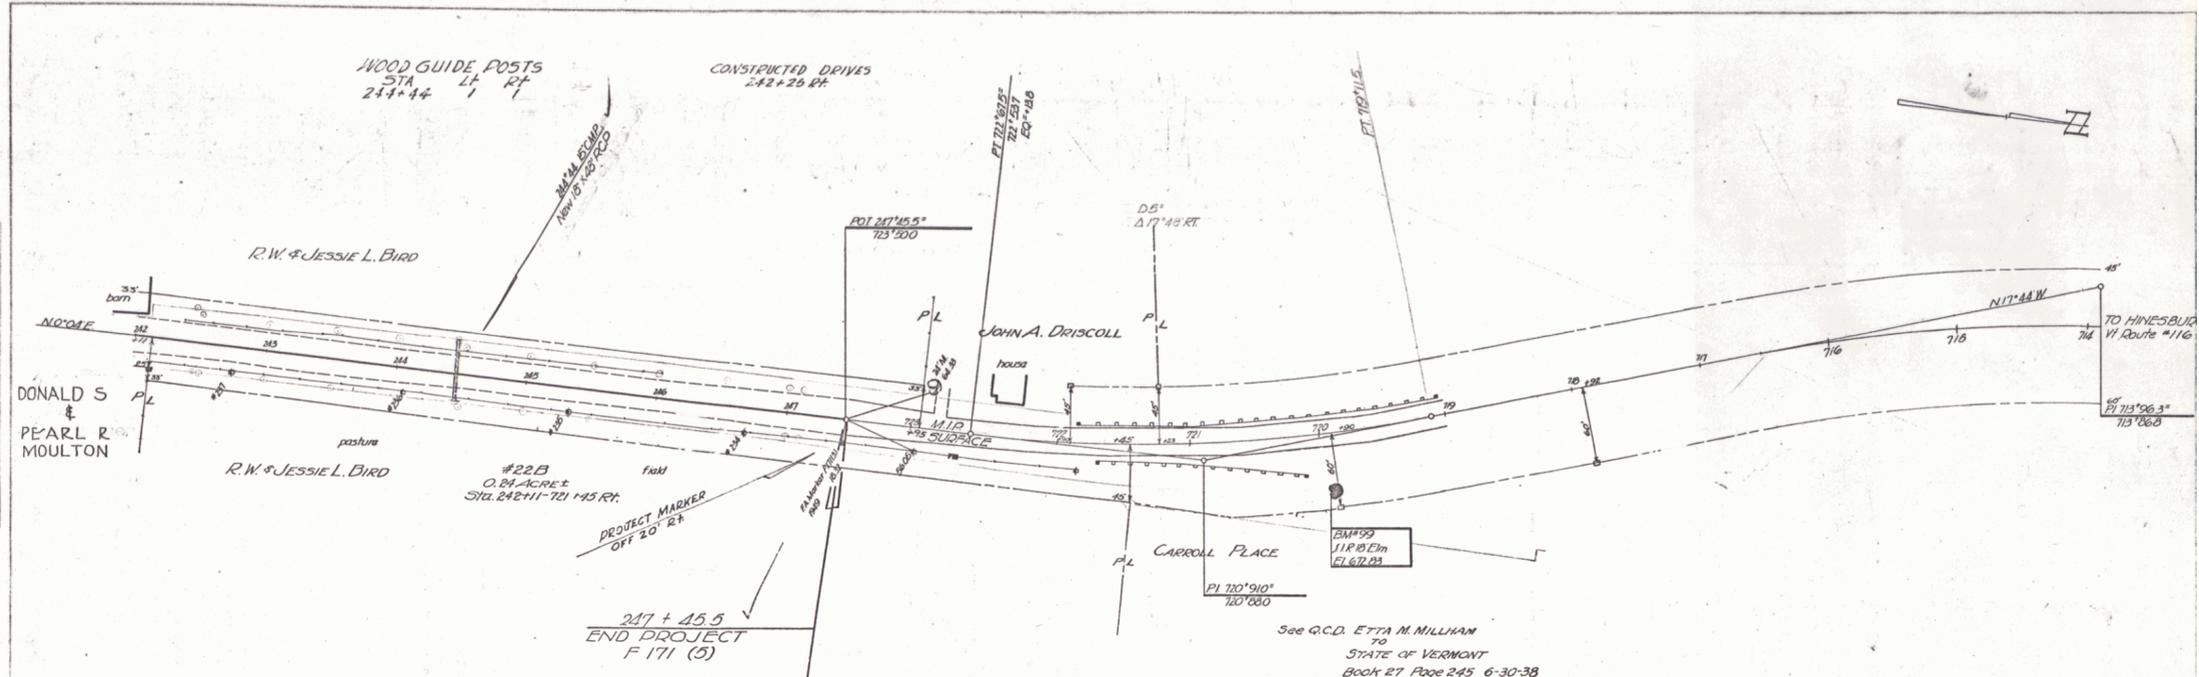

STAIRSBORO-HINESBURG
 Project F No 171 (5)
 Sheet 19 of 104