



FED. ROAD DIST. NO.	STATE	PWA	FISCAL YEAR	SHEET NO.	TOTAL SHEETS
3	VT.	VE1028	1936	2	13

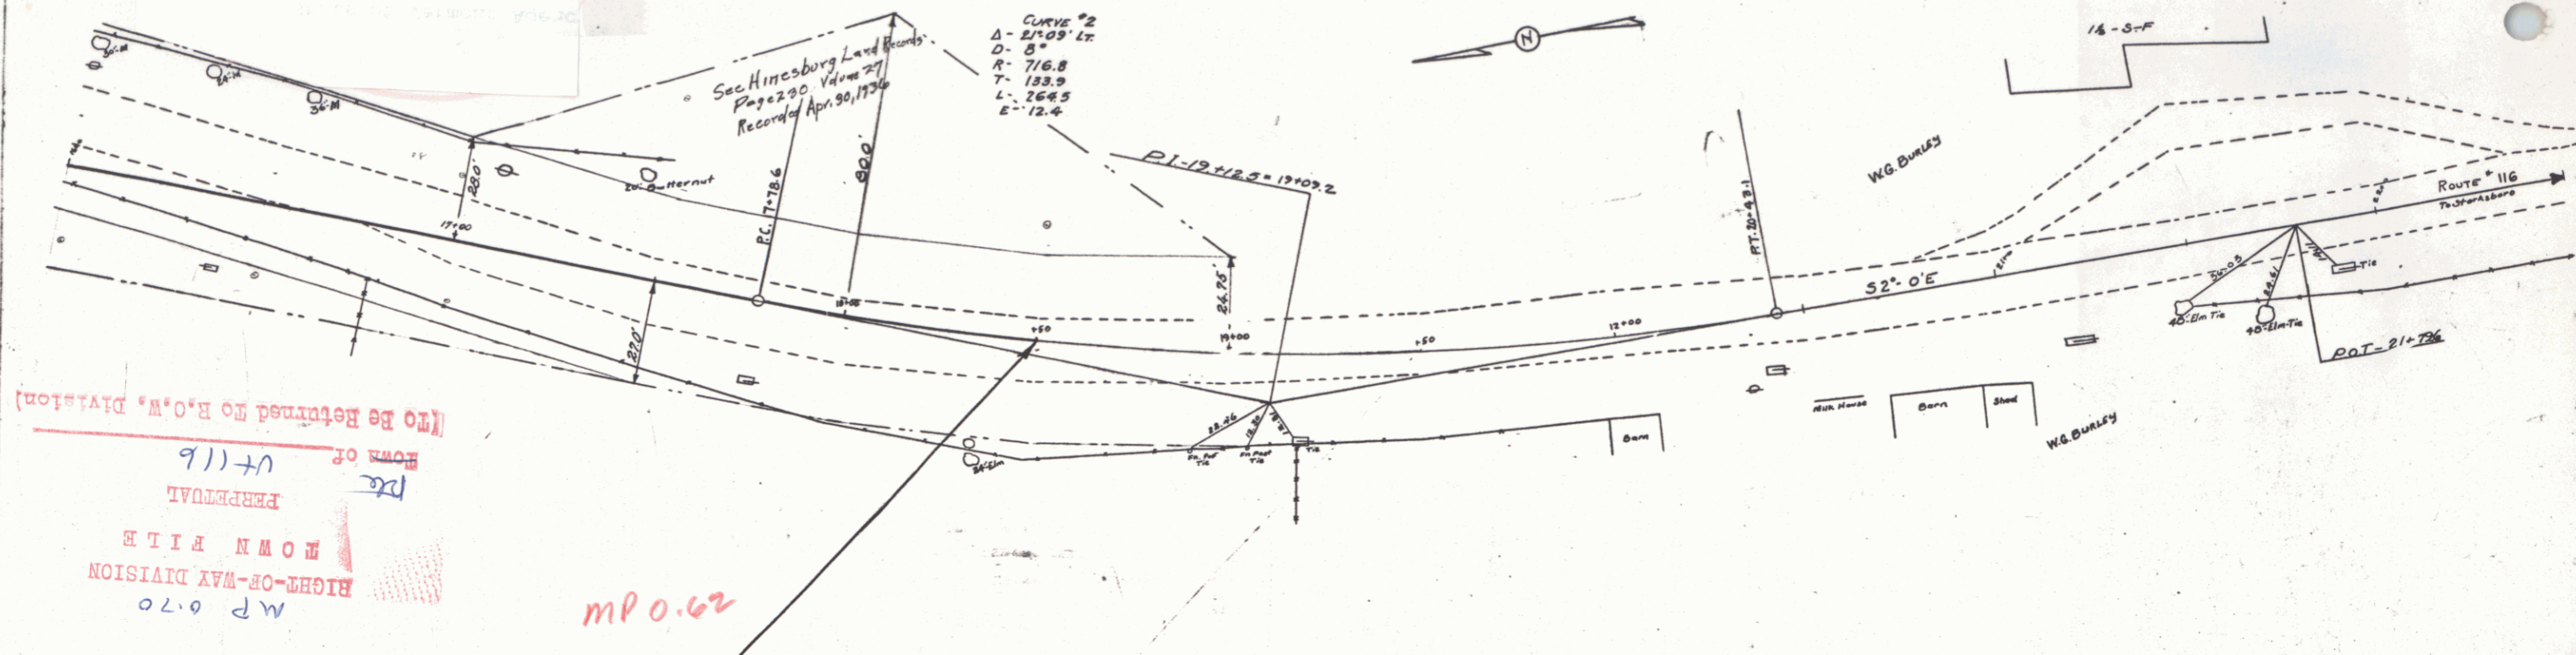

MP 0.70
 RIGHT-OF-WAY DIVISION
 MON FILE
 PERPETUAL
 FORM OF V-116
 (To Be Returned to R.O.W. DIVISION)

MP 0.62

PROJECT ENDS
 STA 18+50

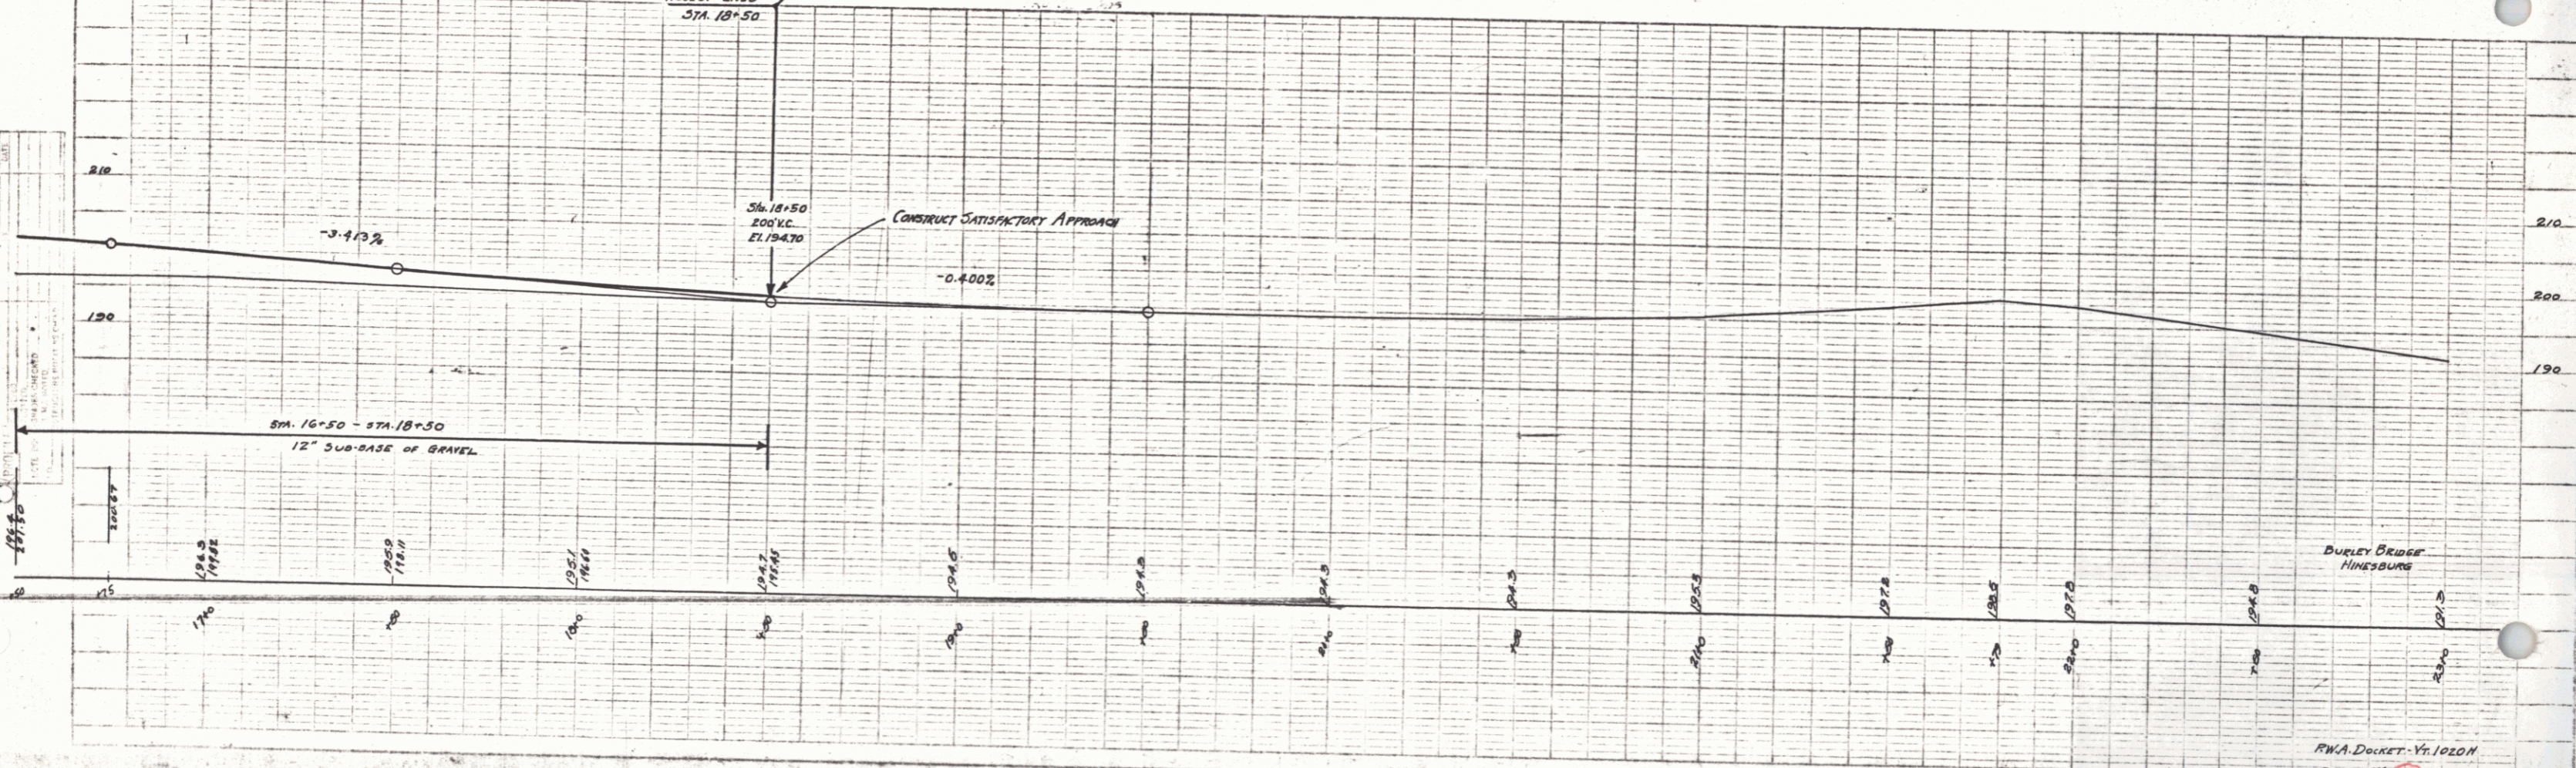

RWA Docket: Vt. 1028
 SHEET NO. 2 OF 13 SHEETS

W.H. Day
 ALBANY
 STATE ENGINEER
 DISTRICT ENGINEER
 DISTRICT NO. 1
 DISTRICT OFFICE
 100 STATE STREET
 ALBANY, N.Y.