


DE VES CONSTRUCTED

Sta.	SE.	Posit.
588+65		Rt.
595+60		Lt.
596+90		Rt.

PARCEL INSTRUMENT	DATE	GRANTOR	GRANTEE	RECORDED HINESBURG	REMARKS
* 3	12-1-48	PHILIP P. & RUBERTA ST. OF VT.		BOOK 28 PAGE 539	1-17-49
* 4	9-29-48	H.L. & RUTH B. MURRAY		BOOK 28 PAGE 267	10-5-48

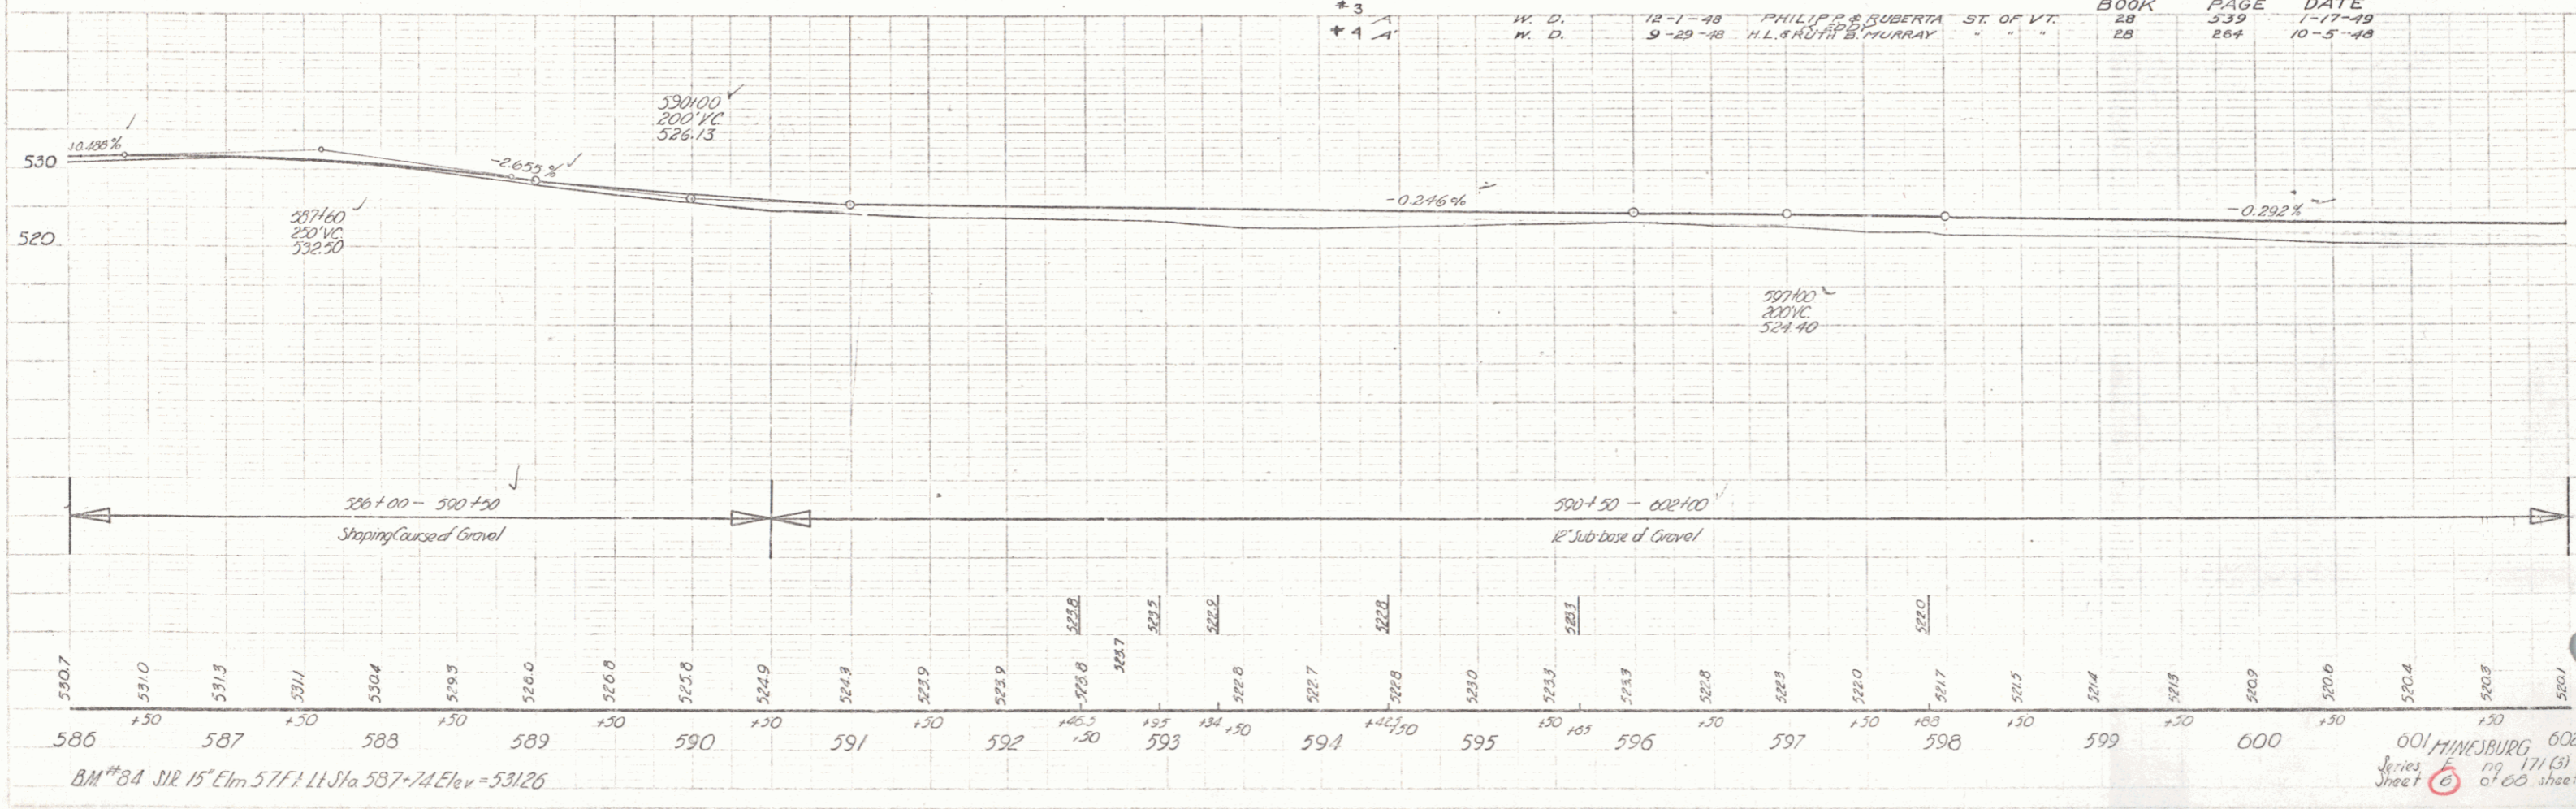

B.M. #84 112' 15" Elm. 577' Lt. Sta 587+74 Elev = 531.26

601 HINESBURG 602
 Series 171(3)
 Sheet 6 of 65 sheets

947 1948
 Surveying Paper
 14x18
 M.A.

947 1948
 Surveying Paper
 14x18
 M.A.