
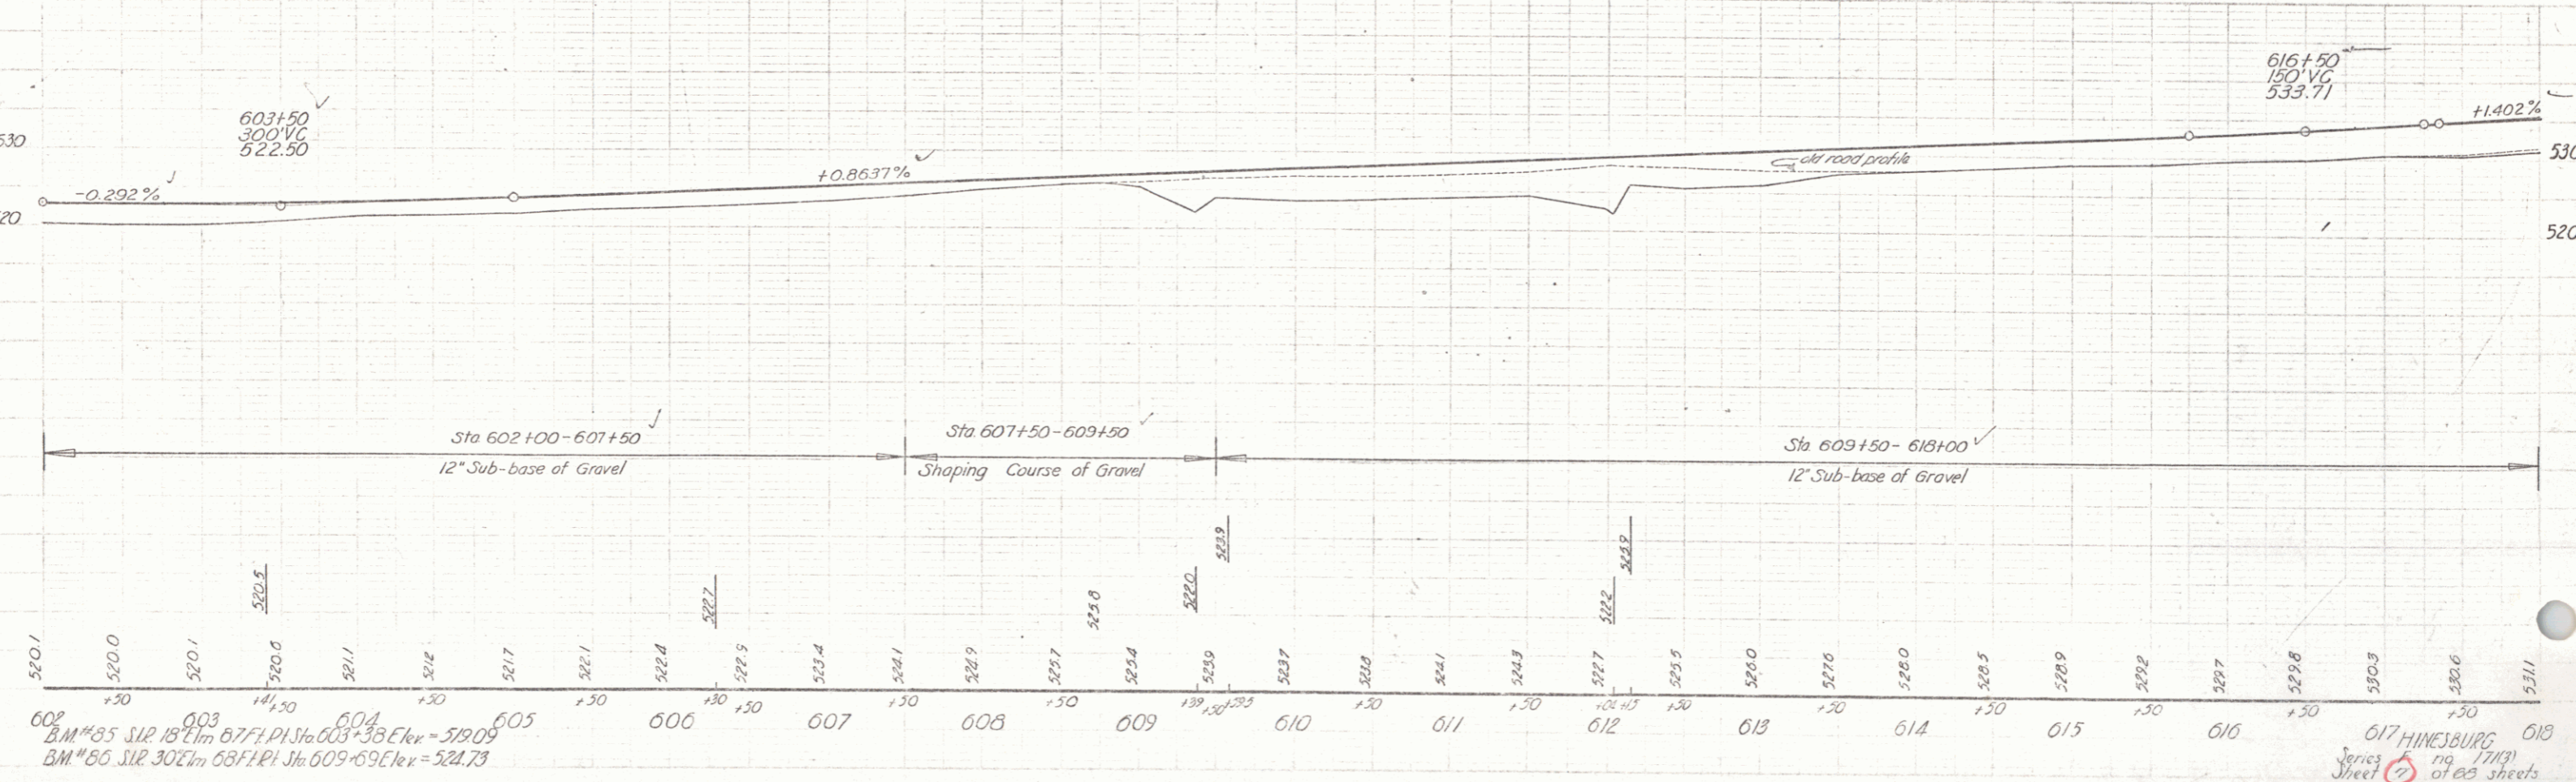


PARCEL INSTRUMENT DATE GRANTOR GRANTEE RECORDED HINESBURG REMARKS
 #5 A & B W.D. 9-16-48 ARMAND J. & MARY ANN ST. OF VT. BOOK PAGE DATE
 TREMBLAY 28 514 10-5-48 SEE SHEET 16

POST WAR F A PRIMARY

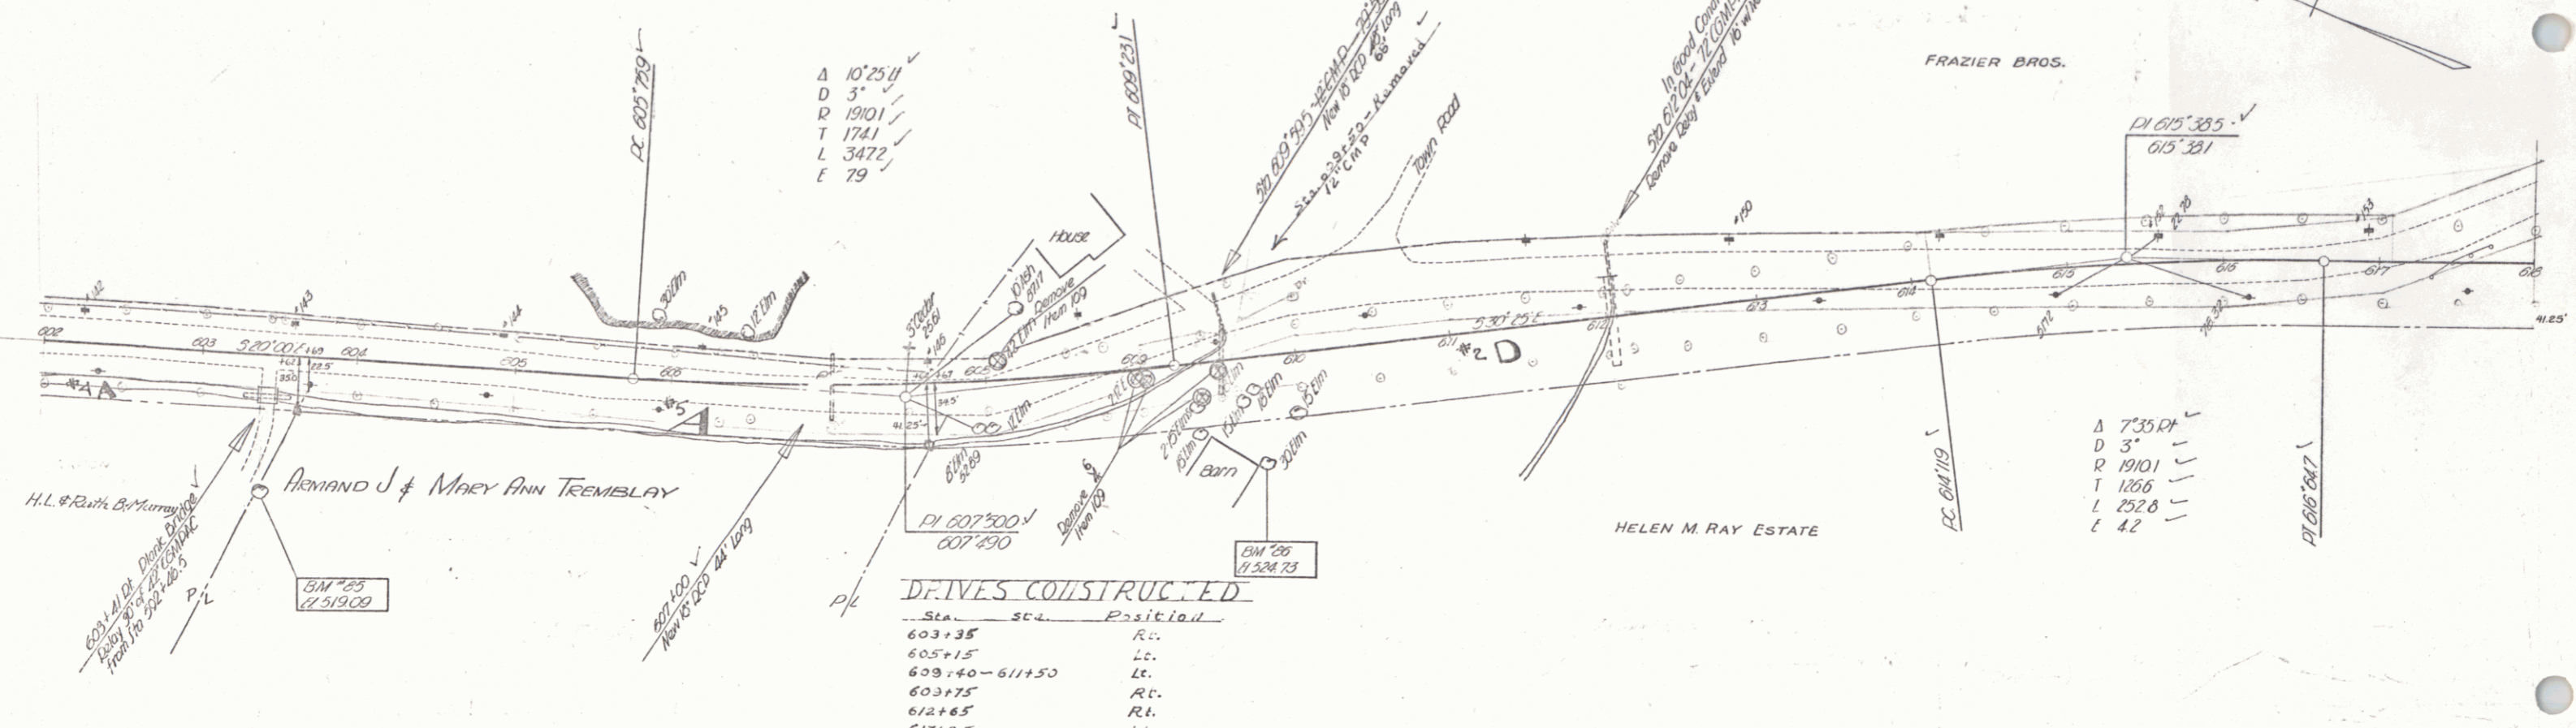

Spaulding 1947
Kerr 1948

Spaulding 1946
Austin 1946

602 B.M. #85 SUR 18' E 1/4 M 677.1 P.I. Sta 603+38 Elev = 519.09
 B.M. #86 SUR 302' E 1/4 M 681.1 P.I. Sta 609+69 Elev = 524.73

617 HINESBURG
 Series 17/131
 Sheet 17 of 23 sheets