


DRIVES CONSTRUCTED:

Stn.	Position
677+30	Lt.
679+25	Lt.
680+20	Lt.
682+25	Lt.

PARCEL	INSTRUMENT	DATE	GRANTOR	GRANTEE	RECORDED HINESBURG	REMARKS
					BOOK PAGE DATE	
*9 A, (Sheet 13), B, C	W. D.	9-16-48	DUANE & MARY BISSONETTE	ST. OF VT.	28 571 9-23-48	
*11 A	W. D.	9-16-48	NELSON AMOUR	ST. OF VT.	28 318 9-23-48	
*10 A, B (Sheet 13) & C (Sheet 14)	W. D.	9-16-48	FORREST & MARGARET TRACEY	ST. OF VT.	28 352 10-5-48	

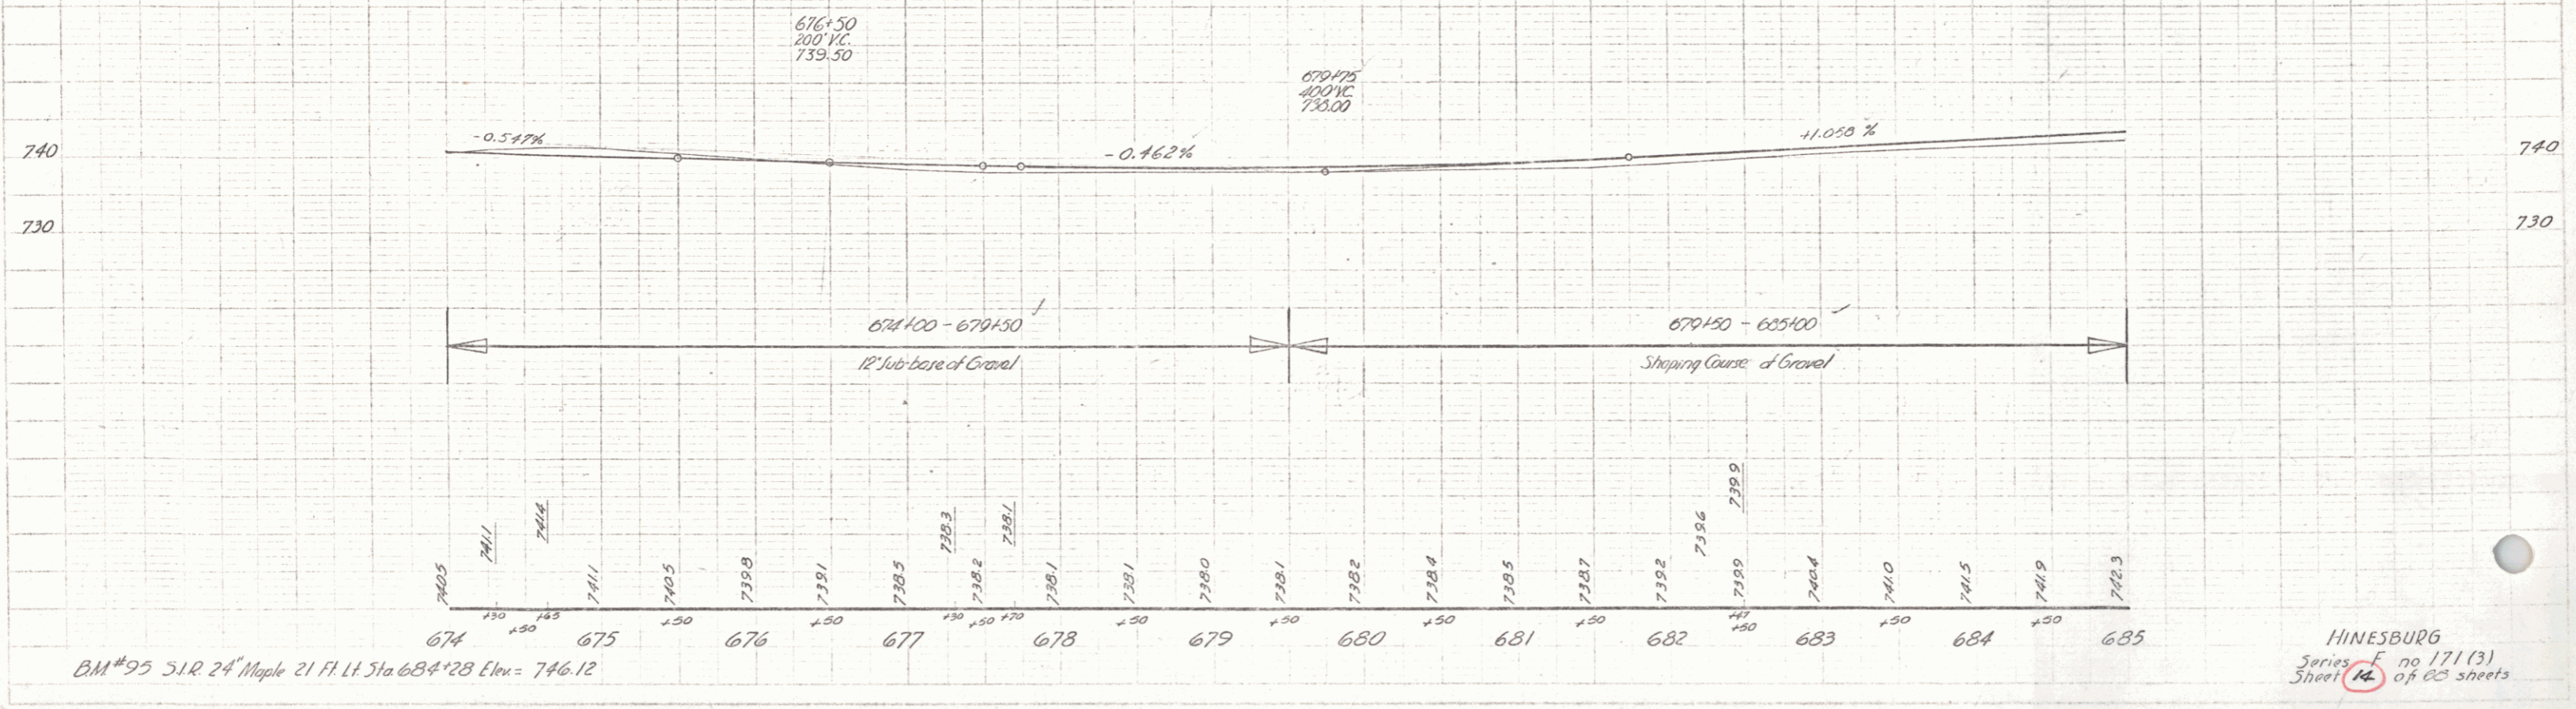

BM #95 S.R. 24" Maple 21 Ft. H Sta 684+28 Elev = 746.12

HINESBURG Series F no 171 (3) Sheet 14 of 23 sheets

Spaulding Paper 1948
Traced

Spaulding Paper 1948
Traced