
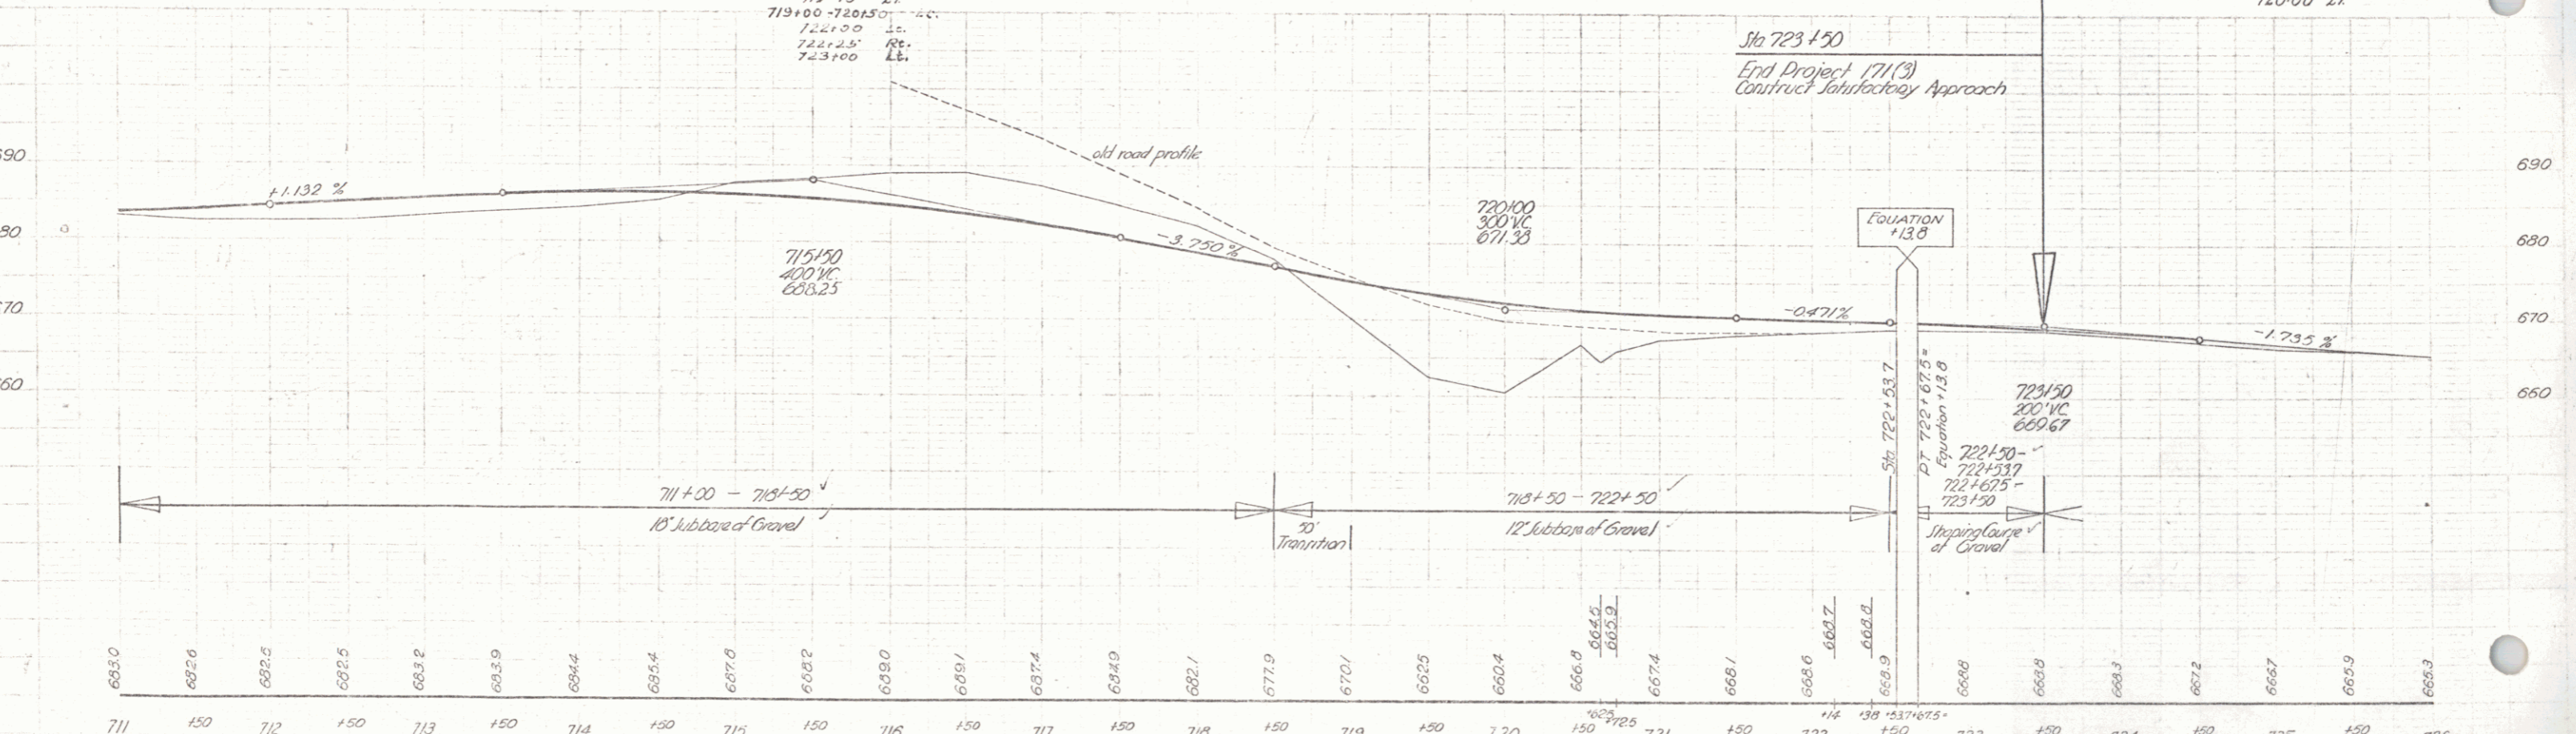


PARCEL INSTRUMENT DATE GRANTOR GRANTEE RECORDED HINESBURG REMARKS
 #2-A W.D. 9-29-48 CLYDE L. MILDRED R. ST. OF VT. BOOK 28 PAGE 220 DATE 10-5-48

FISCAL SHEET TOTAL
 DIST. NO. STATE PROJ. NO. YEAR NO. SHEETS
 121(0) 17 60
 POST WAR F A PRIMARY

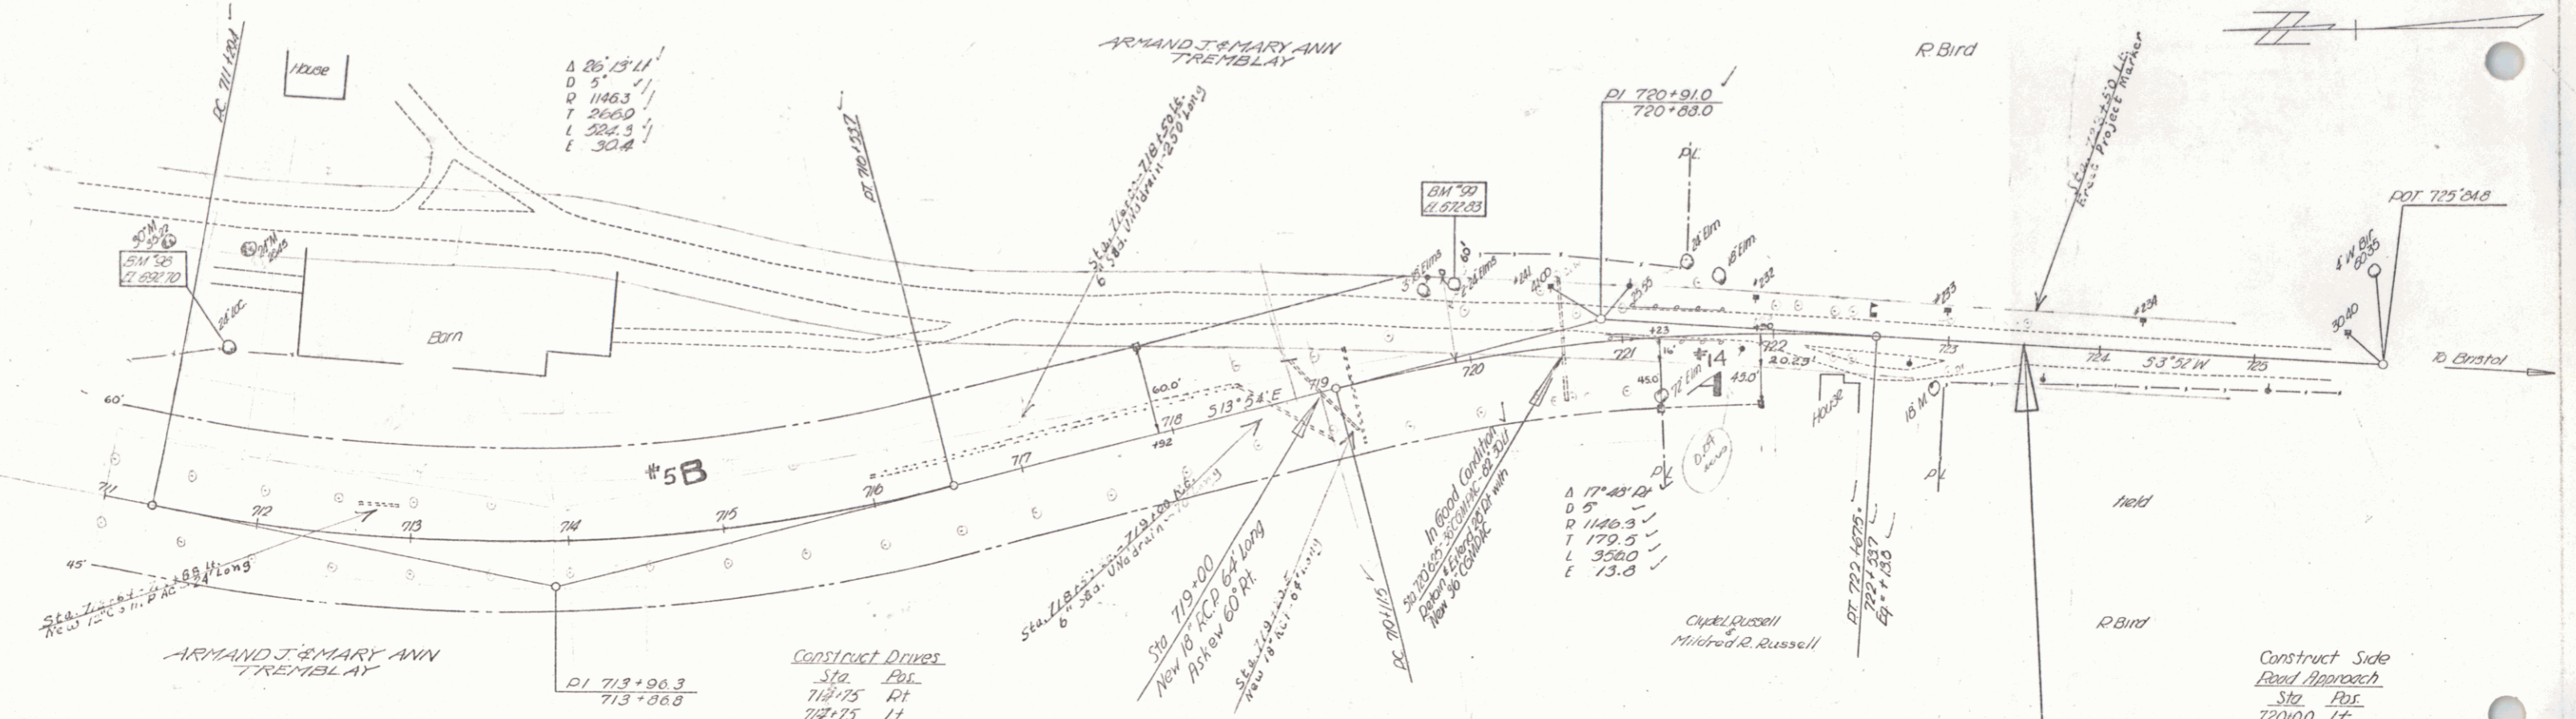

711 150 712 +50 713 150 714 150 715 150 716 150 717 150 718 150 719 150 720 150 721 150 722 150 723 150 724 150 725 150 726

B.M. # 35 S.I.T. 24' Locust 108 Ft. Lt. Sta. 711+62 Elev. 692.70
 B.M. # 99 S.I.T. 24' Elm 46 Ft. Lt. Sta. 719+97 Elev. 672.83

HINESBURG Series No. 171(3) Sheet 17 of 60 Sheets