


PLAN
 DATE: 12-23-30
 NOTE BOOK: [unclear]
 BY: [unclear]

SECTION
 DATE: 12-23-30
 NOTE BOOK: [unclear]
 BY: [unclear]



BOULDER PARCEL	INSTRUMENT	DATE	GRANTOR	GRANTEE	RECORDED	REMARKS
POSTURE A	Q.C.D.	5-3-38	J.L. BISONETTE	ST. OF VT.	BOOK PAGE DATE 27 241 5-5-38	

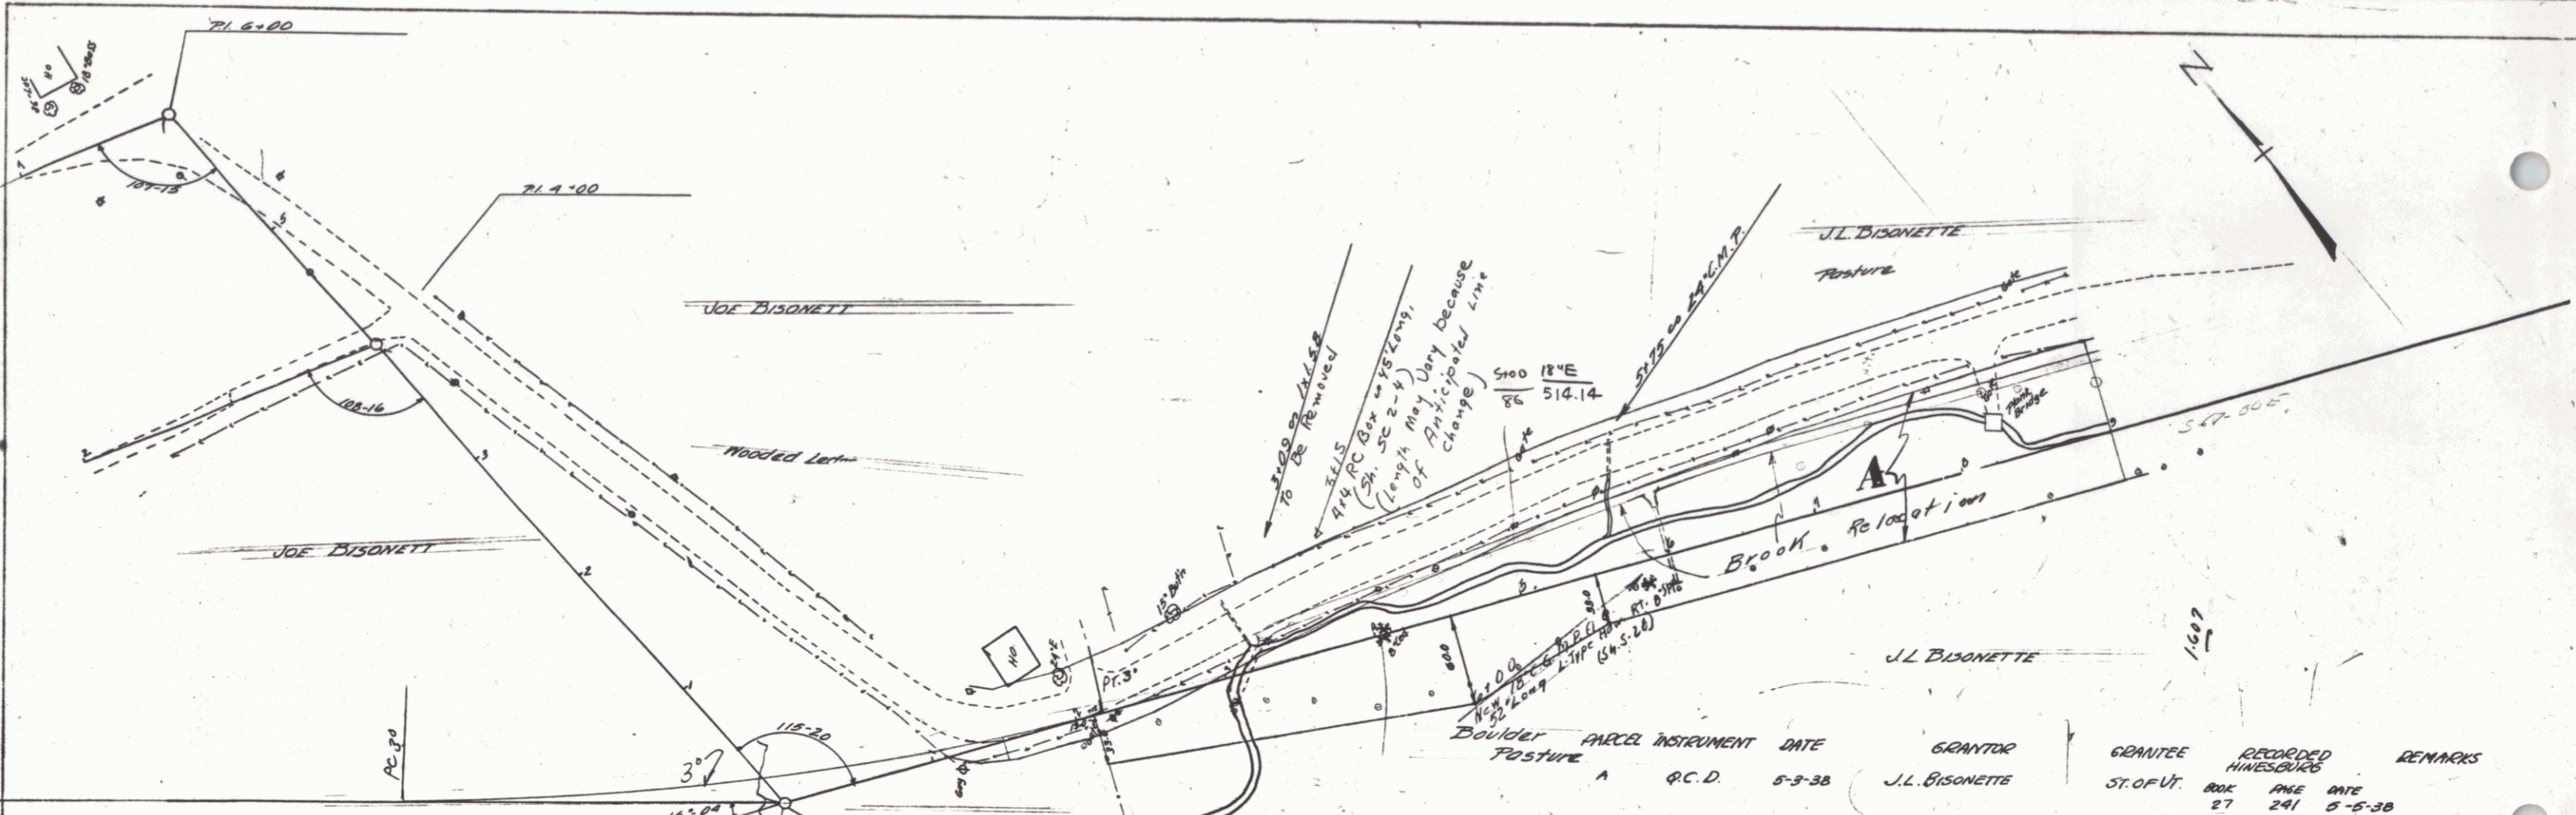