


PLAN  
 DRAWN BY: [blank]  
 CHECKED BY: [blank]  
 DATE: [blank]

PROFILE  
 DRAWN BY: [blank]  
 CHECKED BY: [blank]  
 DATE: [blank]

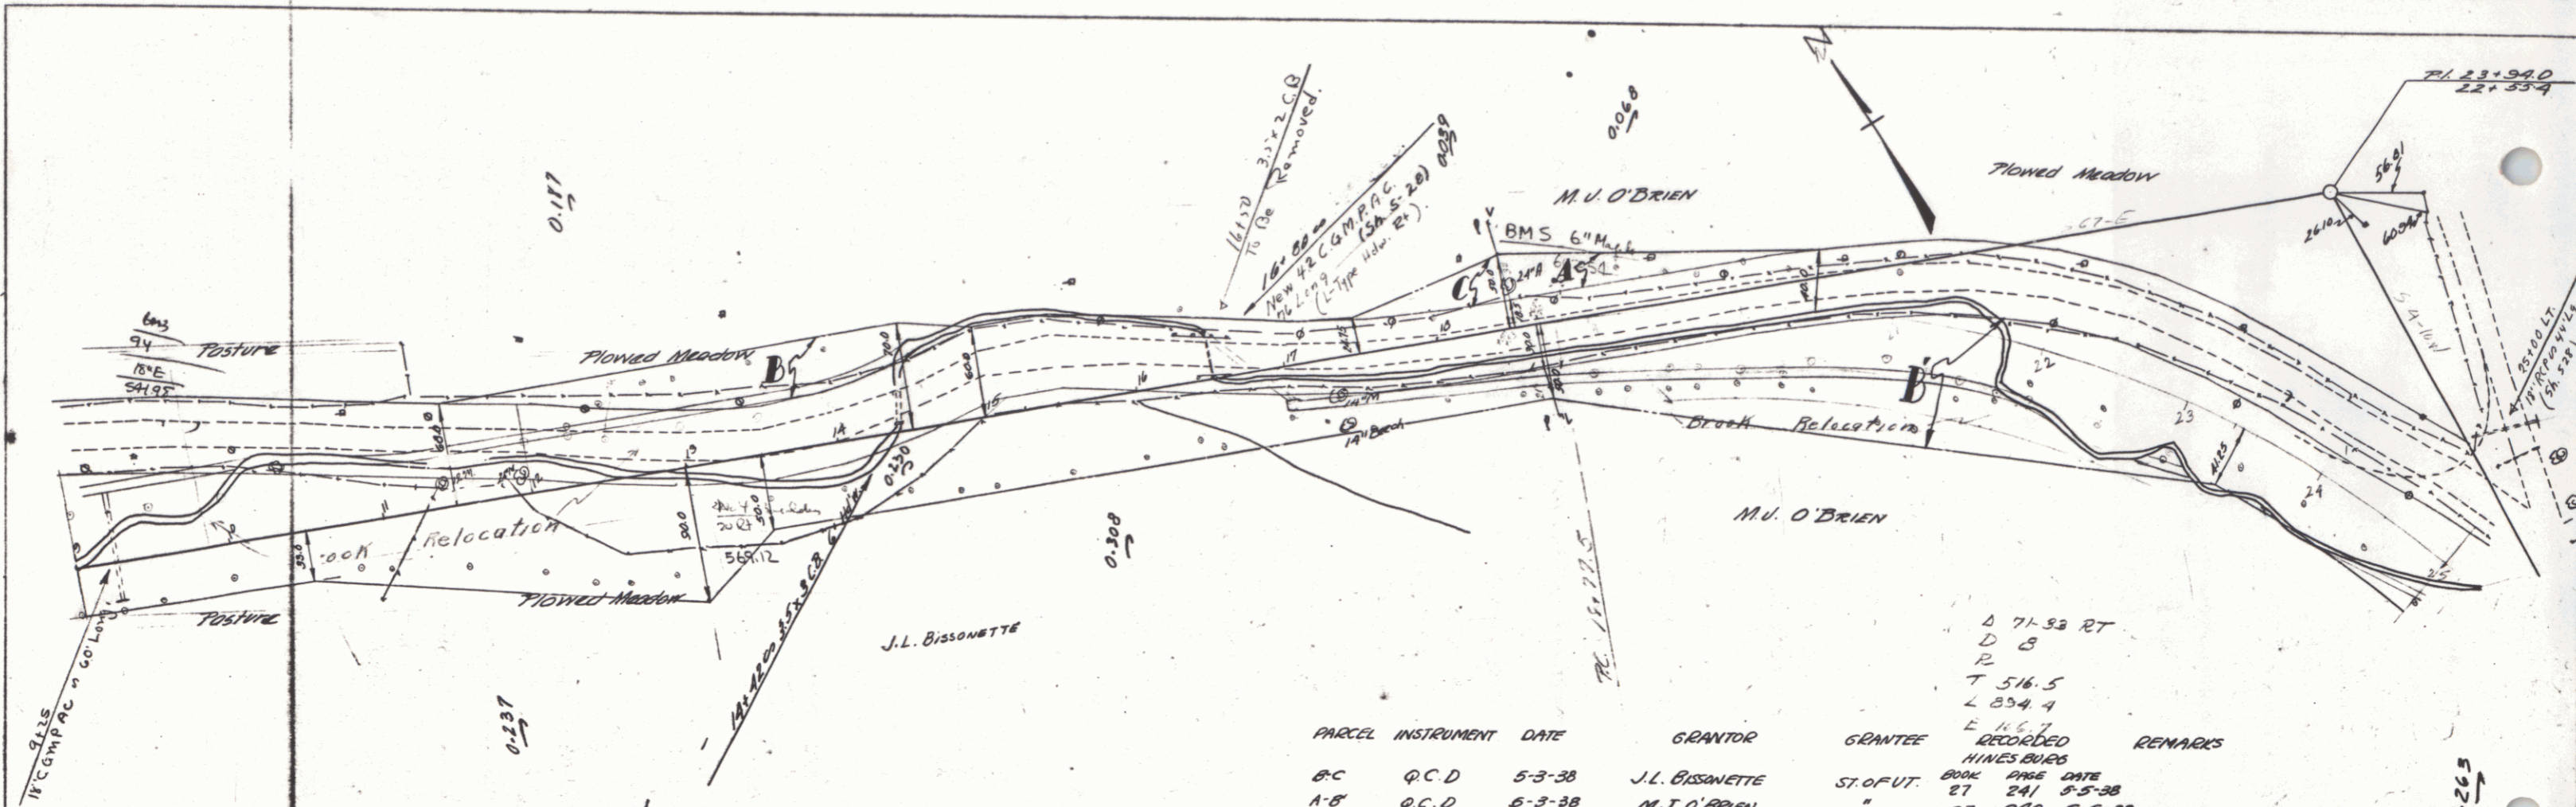

PARCEL	INSTRUMENT	DATE	GRANTOR	GRANTEE	RECORDED	REMARKS
B-C	Q.C.D	5-3-38	J.L. Bissonette			
A-B	Q.C.D	5-3-38	M.J. O'Brien			

ST. OF CUT	BOOK	PAGE	DATE
	27	241	5-5-38
"	27	240	5-5-38

