

INDEX OF SHEETS

SHEET NO.	TITLE PAGE
1	TITLE PAGE
2	TYPICAL CROSS-SECTION OF IMPROVEMENT } GRADING, DRAINAGE AND BASE
3	BANKING AND WIDENING TABLES } WITH DOUBLE TRACK CURV. OF REFINED TAR
4-9	PLAN AND PROFILE SHEETS
10	STANDARD STRUCTURE SHEET S-28 PIPE CULVERTS
11	STANDARD STRUCTURE SHEET S-30 GUARD RAIL
12	STANDARD STRUCTURE SHEET S-30A BOUNDARY MARKERS
13	STANDARD STRUCTURE SHEET S-40 BARRICADES, SIGNS & LIGHTS
14	STANDARD STRUCTURE SHEET S-41 ROUNDING OF SLOPES
15	STANDARD STRUCTURE SHEET SC-2-4 BOX CULVERTS
16	STANDARD STRUCTURE SHEET SCW-4 BOX CULVERTS
17-38	CROSS SECTIONS

STANDARD STRUCTURE SHEETS
 APPROVED BY THE CHIEF ENGINEER
 S-28 JULY 11, 1933
 S-30 AUGUST 15, 1934

FED. ROAD DIST. NO.	STATE	STATE PROJ. NO.	FISCAL YEAR	SHEET NO.	TOTAL SHEETS
9	Vt.	140-N	1940	1	38

STATE OF VERMONT
 STATE HIGHWAY DEPARTMENT


PLAN AND PROFILE OF PROPOSED
 STATE HIGHWAY

TOWN OF HINESBURG


BURLINGTON - BRISTOL ROAD - ROUTE 116

BEGINNING AT A POINT 1400 FT. SOUTH OF THE ST. GEORGE-HINESBURG TOWN LINE AND EXTENDING SOUTHERLY 1.543 MILES

LENGTH OF PROJECT 8151.0 FT. = 1.543 MILES

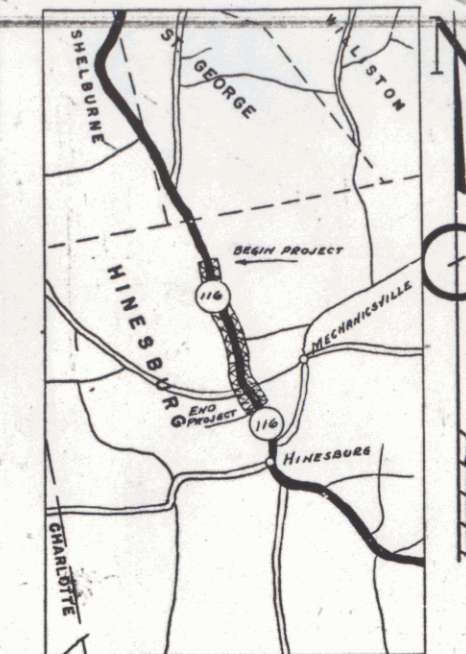

RECORD PLANS
 By: W.H. Chase

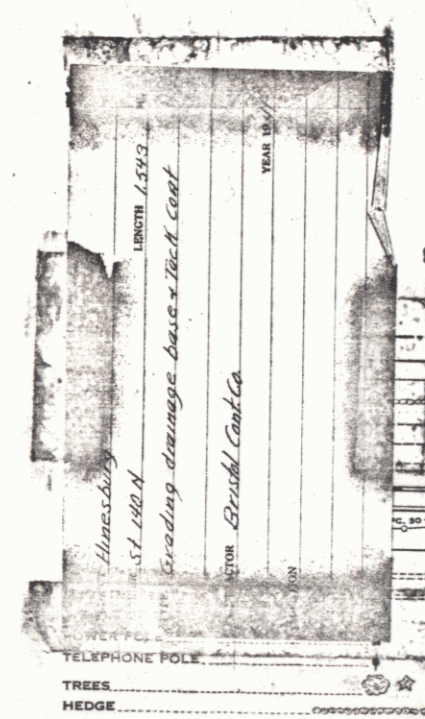

Record Plans
 Hinesburg - Bristol
 Conf. Bristol Const. Co.




CURVE DATA

DEFLECTION ANGLE	Δ
DEGREE OF CURVE	D
RADIUS OF CURVE	R
TANGENT DISTANCE	T
LENGTH OF CURVE	L
EXTERNAL DISTANCE	E
POINT OF INTERSECTION	P. I.
POINT OF CURVE	P. C.
POINT OF TANGENT	P. T.
POINT ON TANGENT	P. O. T.

SCALES

TITLE	1" = 800'
TYPICAL	1" = 2'
PLAN	1" = 30'
PROFILE HORIZONTAL	1" = 30'
PROFILE VERTICAL	1" = 10'
CROSS SECTIONS	1" = 5'

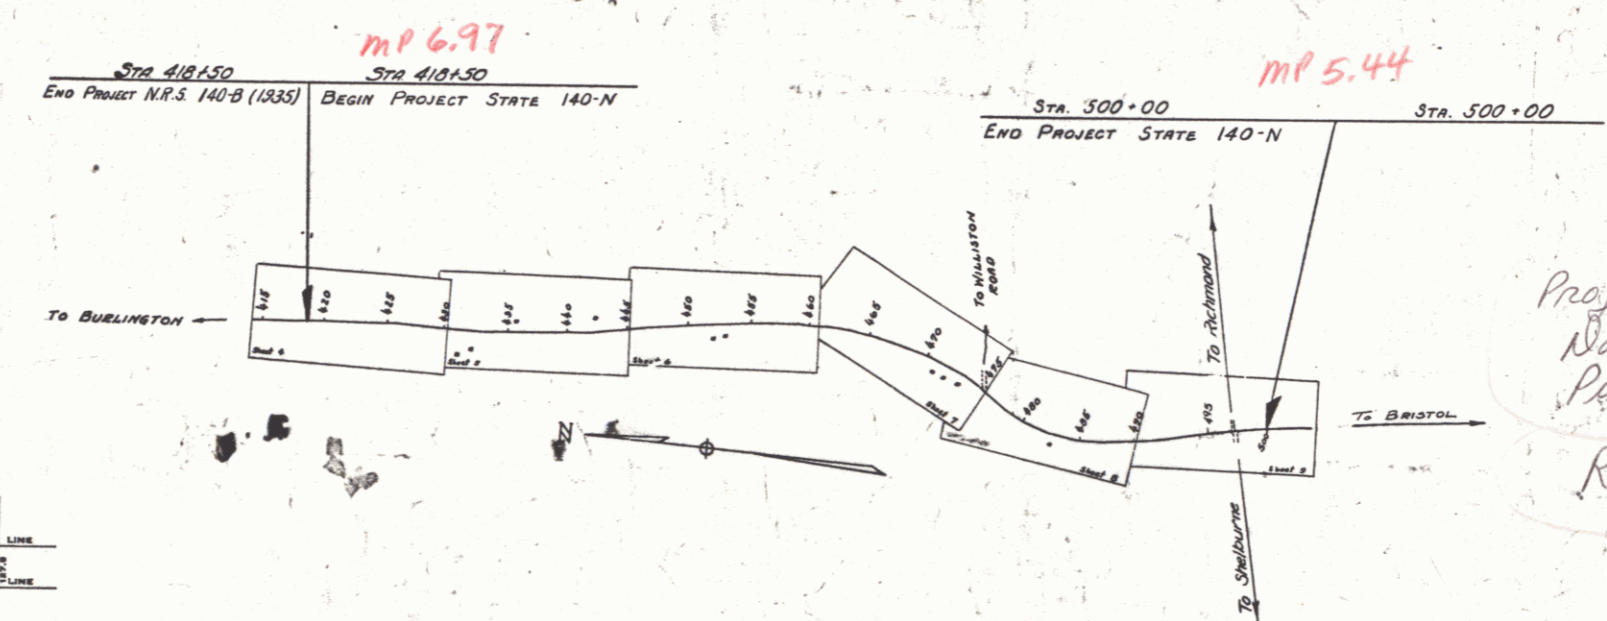

Project ST 140-N
 Date: 07/06/1940
 Per: 00R500
 Route: VT 116

APPROVED: July 6, 1940
 H. B. August
 COMMISSIONER OF HIGHWAYS

RECOMMENDED FOR APPROVAL
 DISTRICT ENGINEER
 PUBLIC ROADS ADMINISTRATION
 FEDERAL WORKS AGENCY

APPROVED: June 28/40
 ROAD ENGINEER

APPROVED: July 27/40
 DISTRICT HIGHWAY COMMISSIONER

SERIES STATE 140-N FILED
 SHEET 1 OF 38

DIST. 05 PLANS