
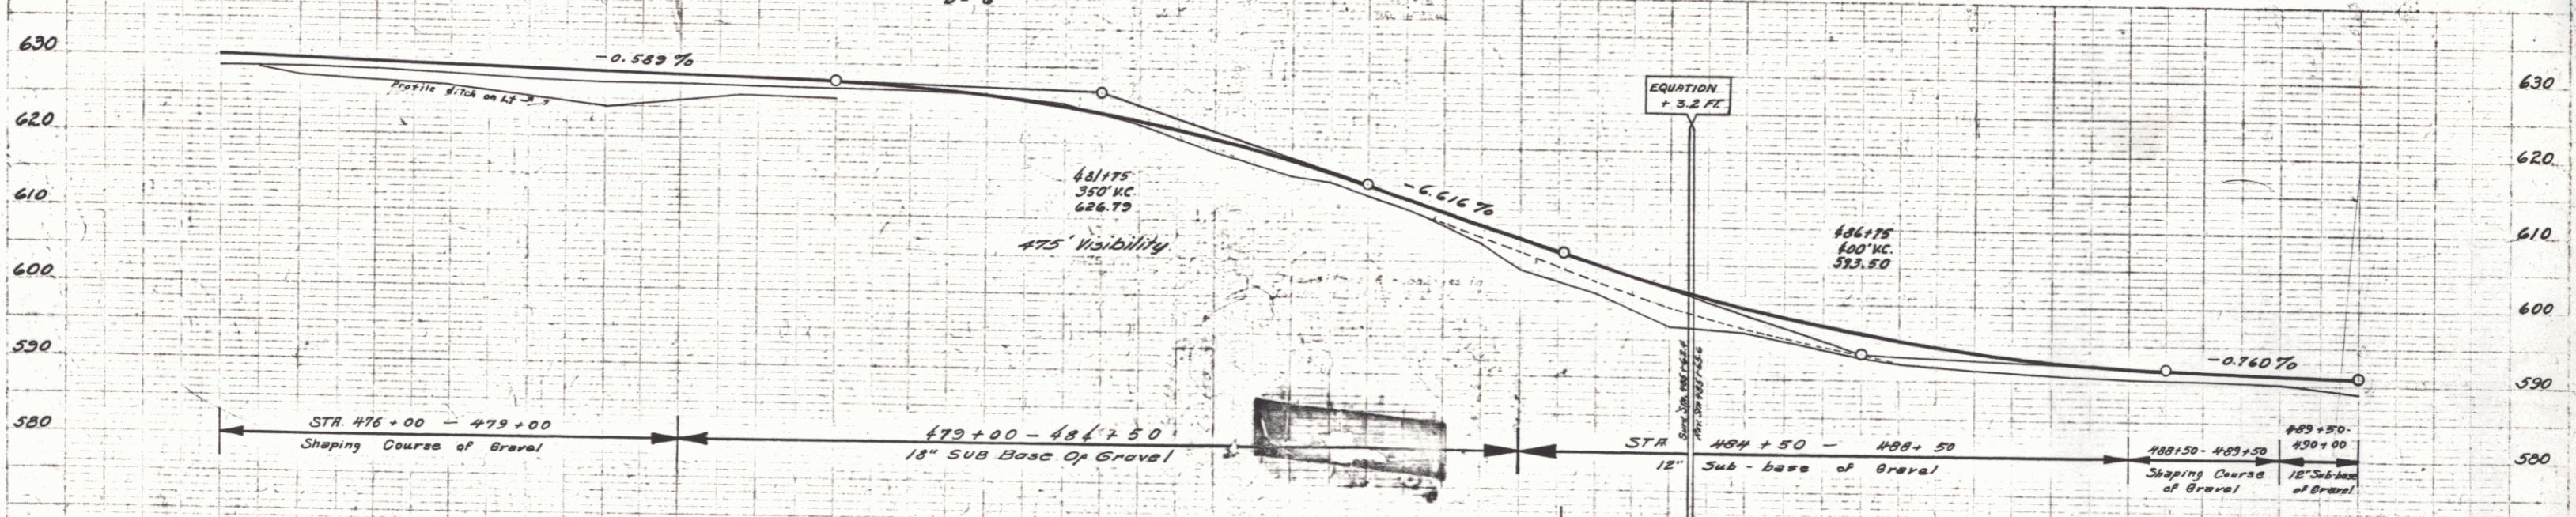


PARCEL INSTRUMENT	DATE	GRANTOR	GRANTEE	RECORDED	REMARK
B	W.D.E.	8-5-40	EVERETTE P. STYGLES	ST. OF VT.	
B-8	W.D.E.	8-5-40	FRANK GEPRAGS	ST. OF VT.	

FED. ROAD DIST. NO.	STATE	PROJECT NO.	YEAR	SHEET NO.	TOTAL SHEETS
140-N	VT	1341	8	30	

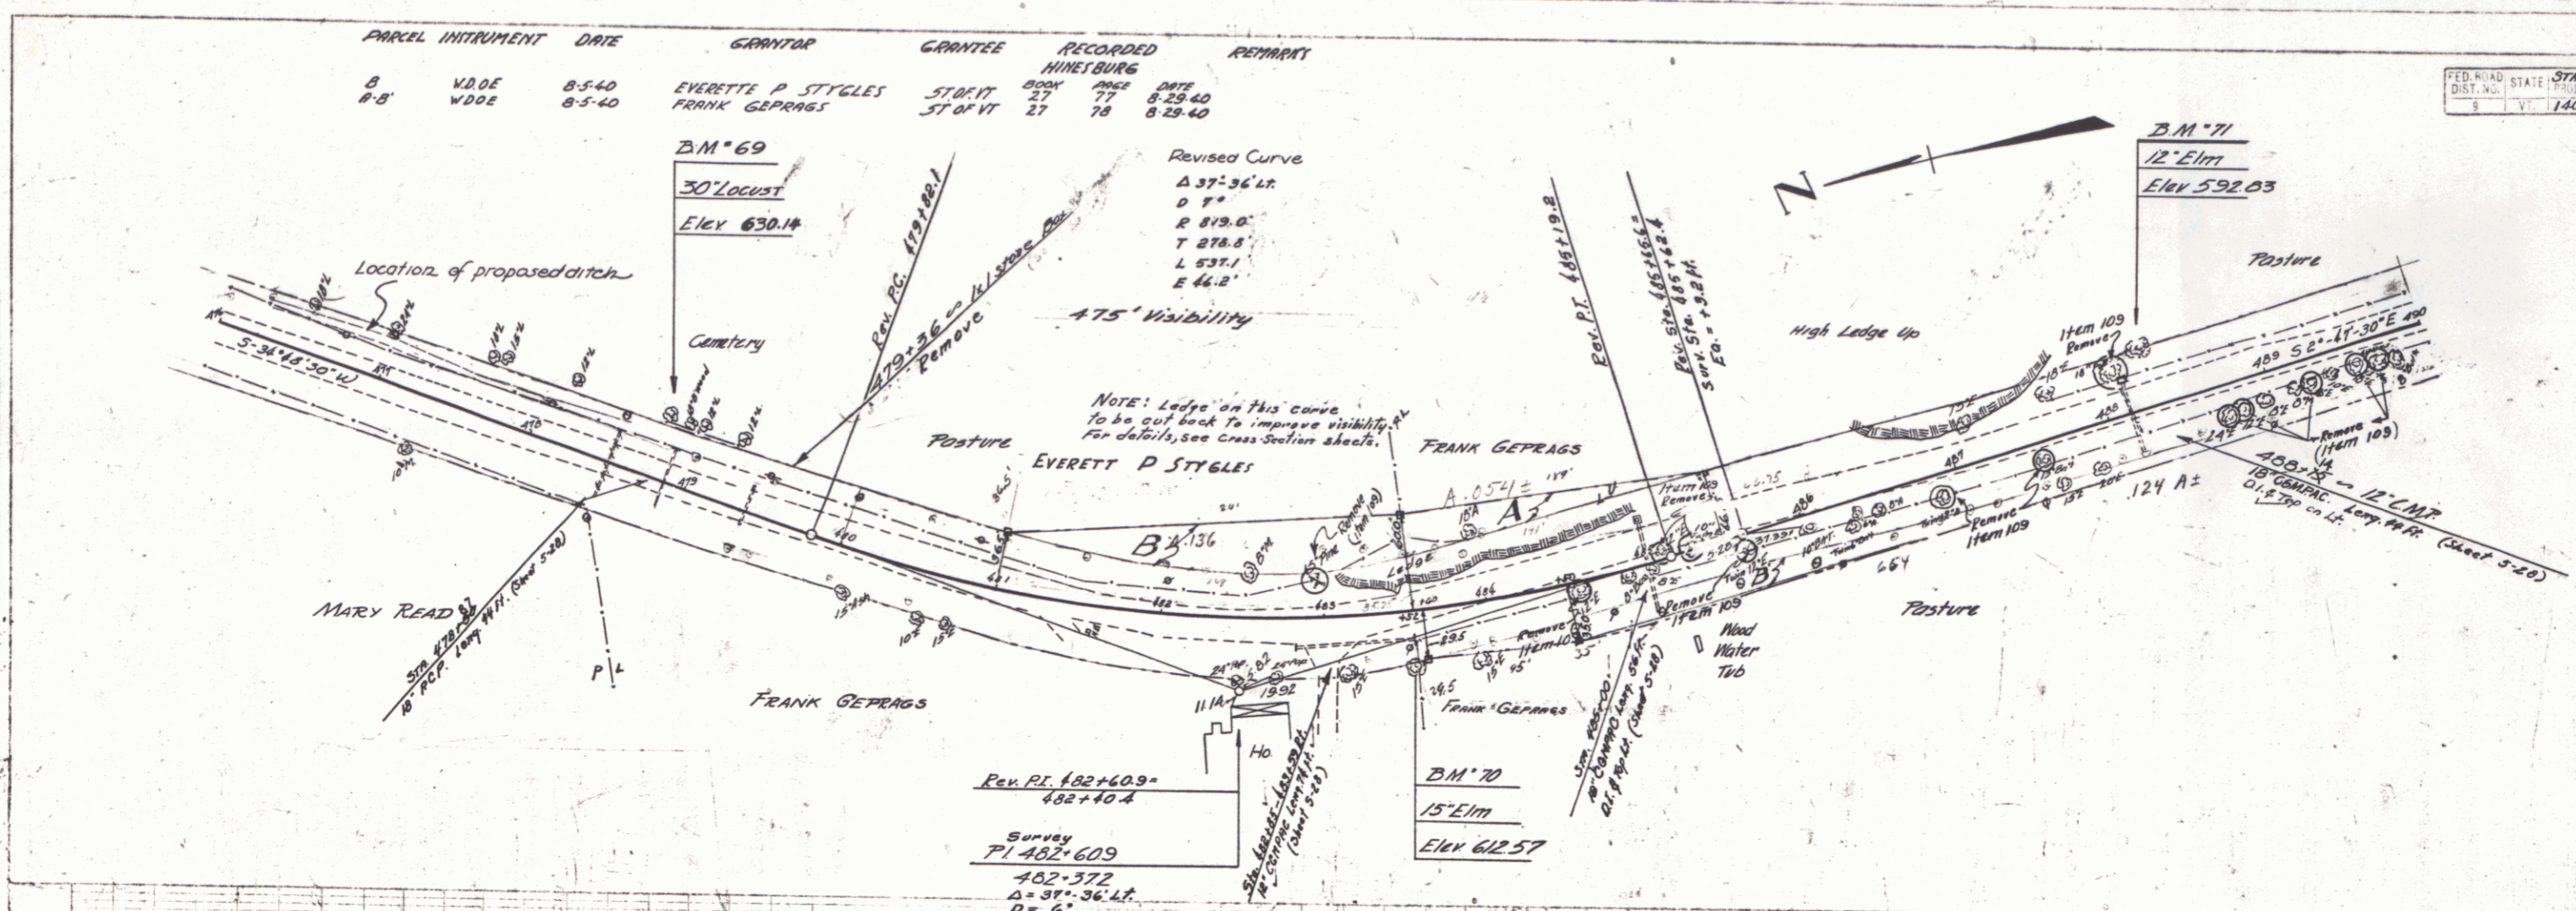

STATION	ELEVATION	STATION	ELEVATION	STATION	ELEVATION	STATION	ELEVATION	STATION	ELEVATION
476	628.7	480	627.6	484	601.6	488	597.1	490	592.0
477	628.1	481	627.2	485	601.2	489	596.7		
478	627.6	482	626.8	486	600.8	490	596.3		
479	627.1	483	626.4	487	600.4	491	595.9		
480	626.7	484	626.0	488	600.0	492	595.5		
481	626.3	485	625.6	489	599.6	493	595.1		
482	625.9	486	625.2	490	599.2	494	594.7		
483	625.5	487	624.8	491	598.8	495	594.3		
484	625.1	488	624.4	492	598.4	496	593.9		
485	624.7	489	624.0	493	598.0	497	593.5		
486	624.3	490	623.6	494	597.6	498	593.1		
487	623.9	491	623.2	495	597.2	499	592.7		
488	623.5	492	622.8	496	596.8	500	592.3		
489	623.1	493	622.4	497	596.4				
490	622.7	494	622.0	498	596.0				
491	622.3	495	621.6	499	595.6				
492	621.9	496	621.2	500	595.2				
493	621.5	497	620.8						
494	621.1	498	620.4						
495	620.7	499	620.0						
496	620.3	500	619.6						
497	619.9								
498	619.5								
499	619.1								
500	618.7								

B.M. 69 SPIKE IN ROOT 30' LOCUST 37' LT. STA 478+77 ELEV. 630.14  
 B.M. 70 SPIKE IN ROOT 15' ELM 37.5' RT. STA 483+52 ELEV. 612.57  
 B.M. 71 SPIKE IN ROOT 12' ELM 31' LT. STA 480+30 ELEV. 592.83