



EXTENSION			
DIST. NO.	STATION	YEAR	TOTAL SHEETS
140-N	749	7	29

B.M. NAME
 C.M. NAME
 DATE
 SCALE
 PROJECT NO.
 SHEET NO.

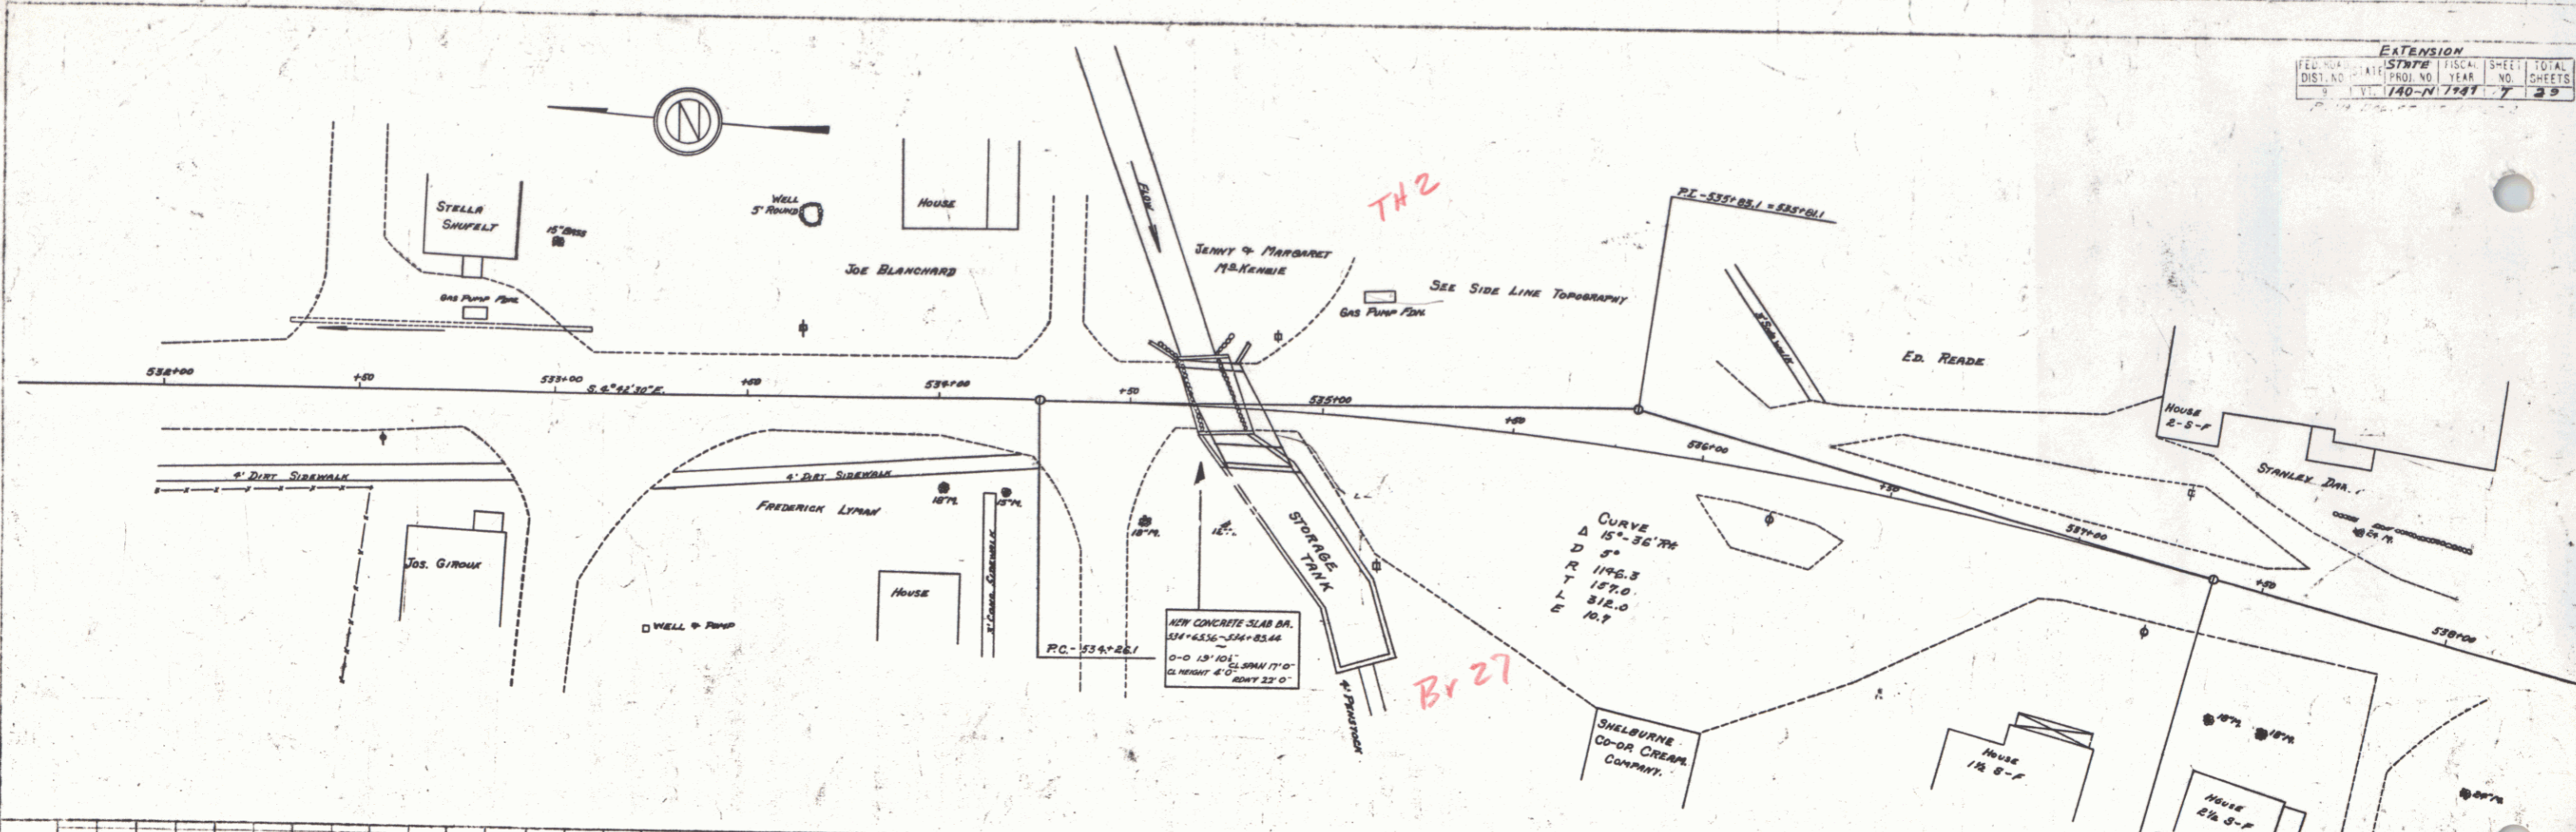

B.M. NAME
 C.M. NAME
 DATE
 SCALE
 PROJECT NO.
 SHEET NO.

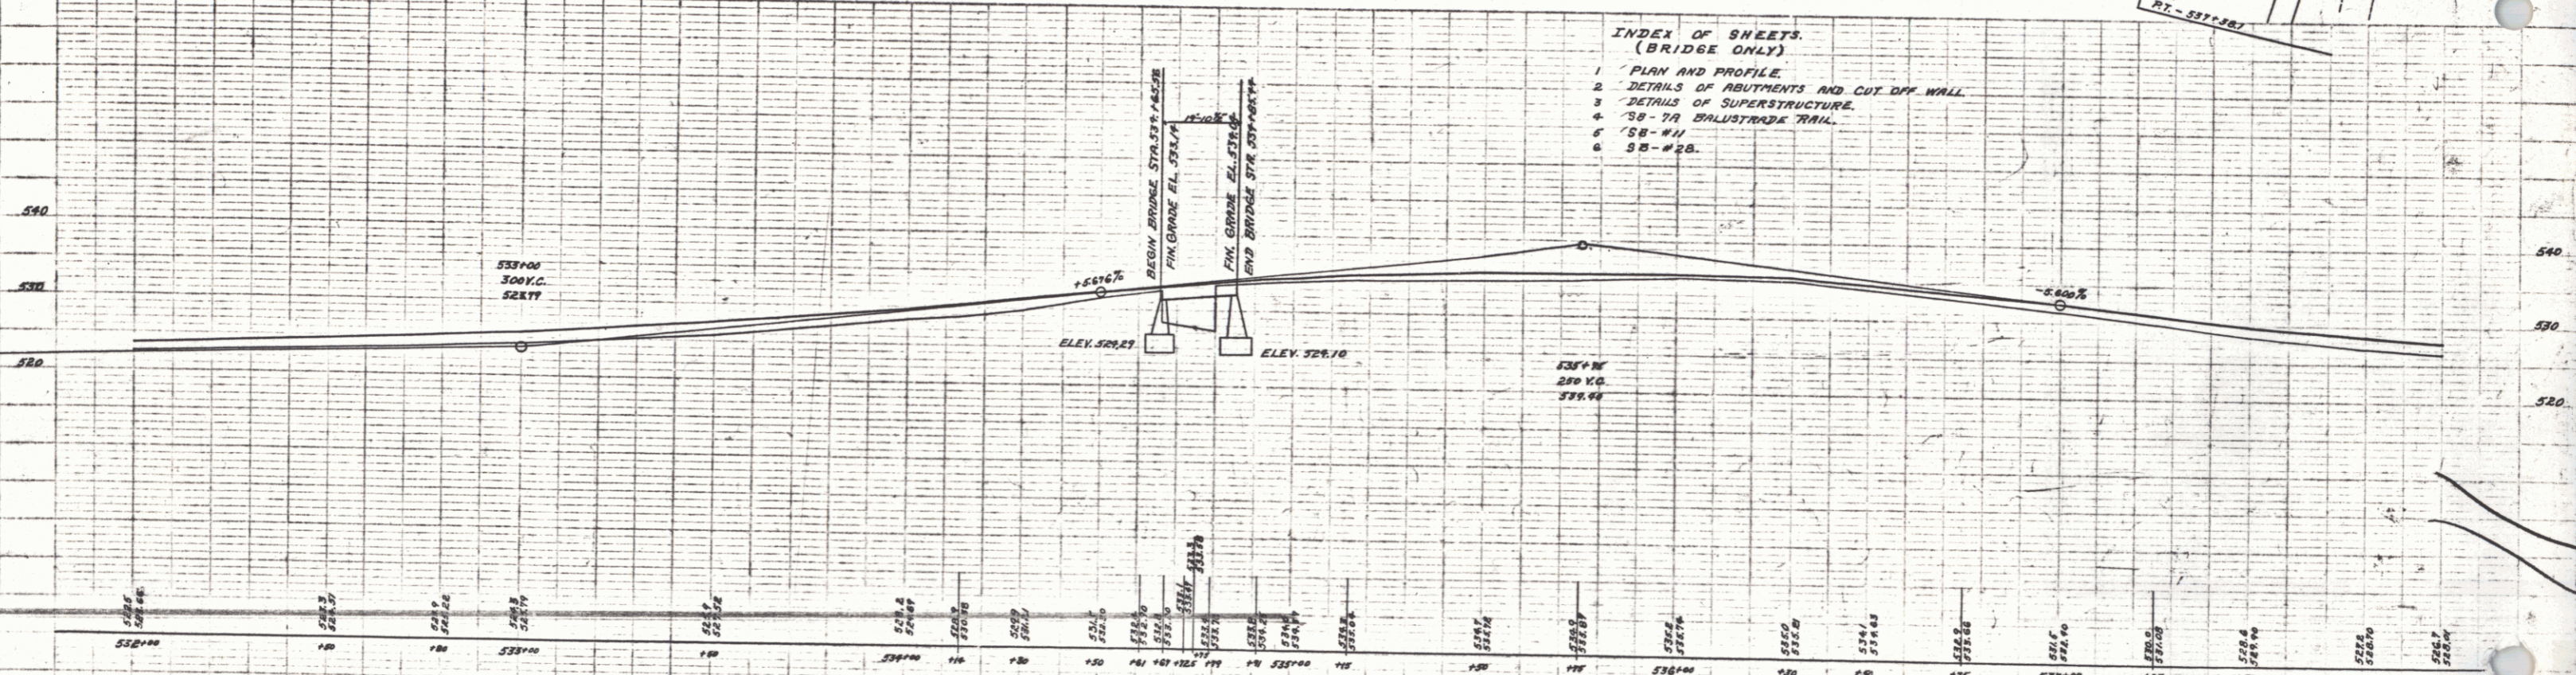

- INDEX OF SHEETS (BRIDGE ONLY)
1. PLAN AND PROFILE
 2. DETAILS OF ABUTMENTS AND CUT OFF WALL
 3. DETAILS OF SUPERSTRUCTURE
 4. 58-7A BALUSTRADE RAIL
 5. 58-8A
 6. 58-8B

HINESBURG ROUTE-116
 SERIES EXTENSION STATE RD-N
 SHEET (7) OF 29
 MCKENZIE BRIDGE