

Δ 2°-26' 77"  
 D 0°-45"  
 P 76395  
 T 1623  
 L 3244  
 E 1.0


PARCEL	INSTRUMENT	DATE	GRANTOR	GRANTEE	RECORDED
					BOOK PAGE DATE
B	QCD	10-18-39	ALONSO KENDALL AND MARGARET KENDALL	ST. OF VT.	22 139-40 11-15-39

STARKSBORO Proj. 171-L


SHEET 2





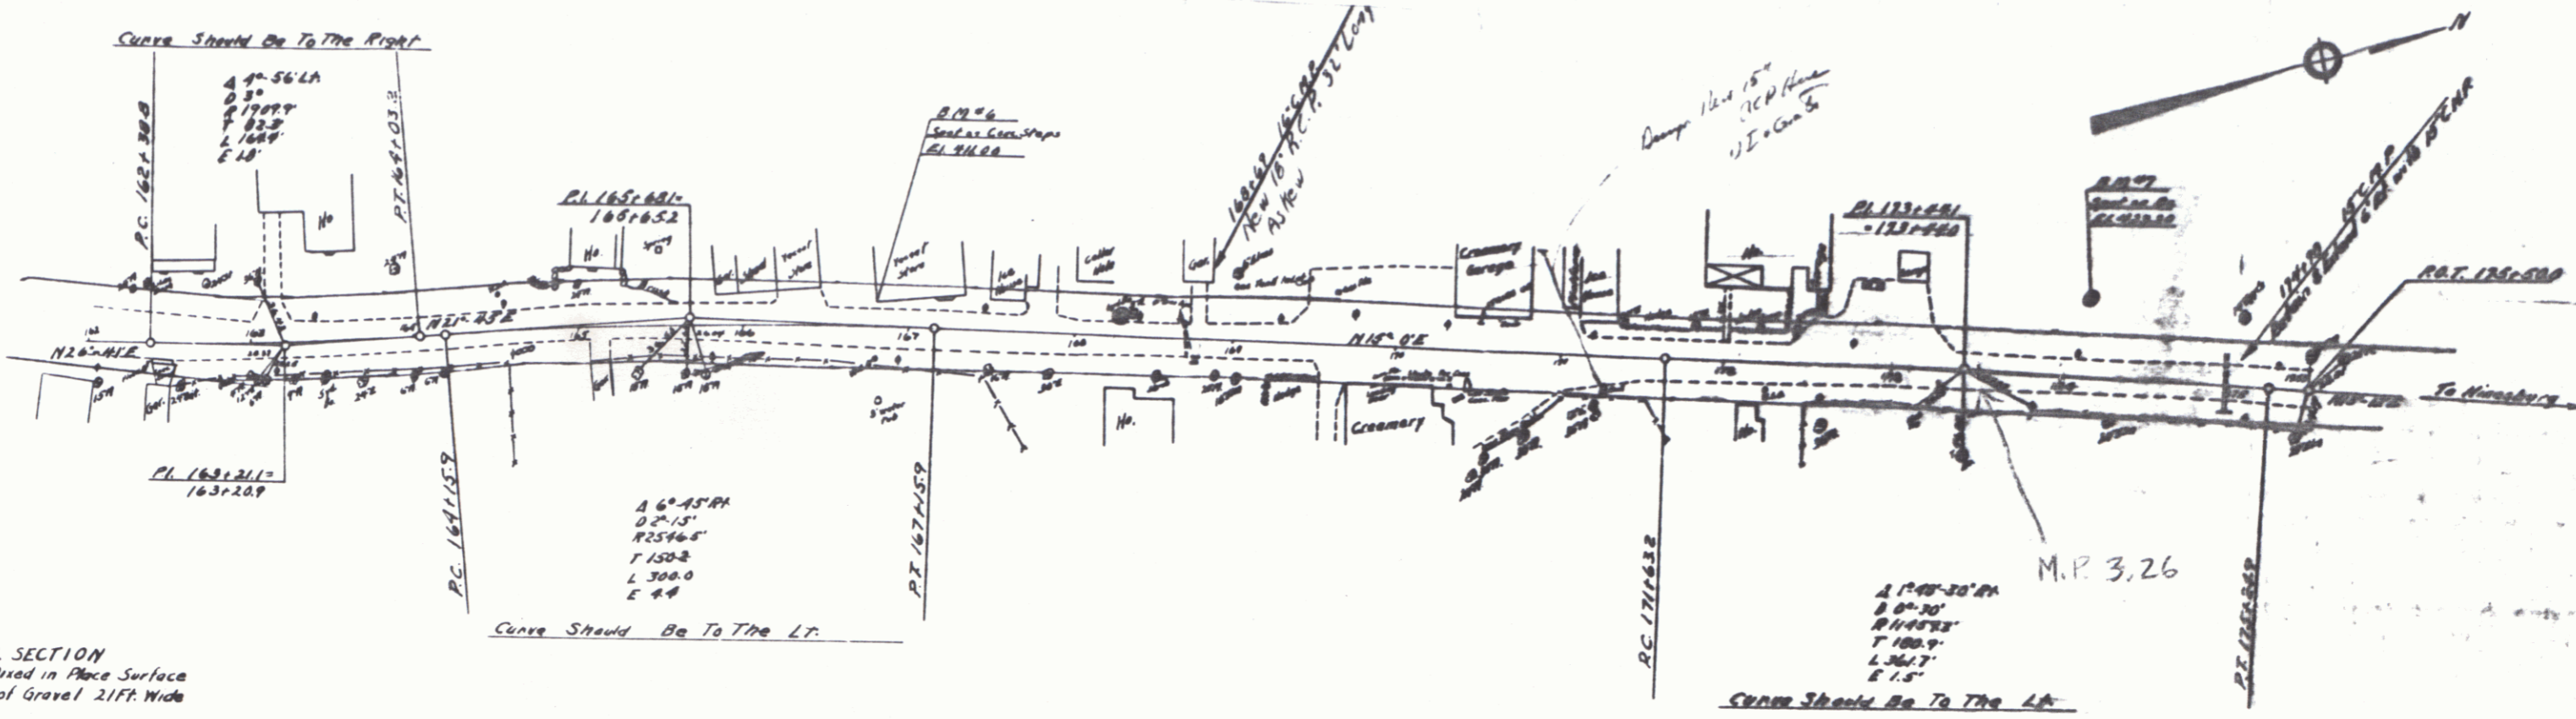



TYPICAL SECTION  
 20 FT - 2% Mixed in Place Surface  
 12" Sub-base of Gravel 2 1/2" Wide

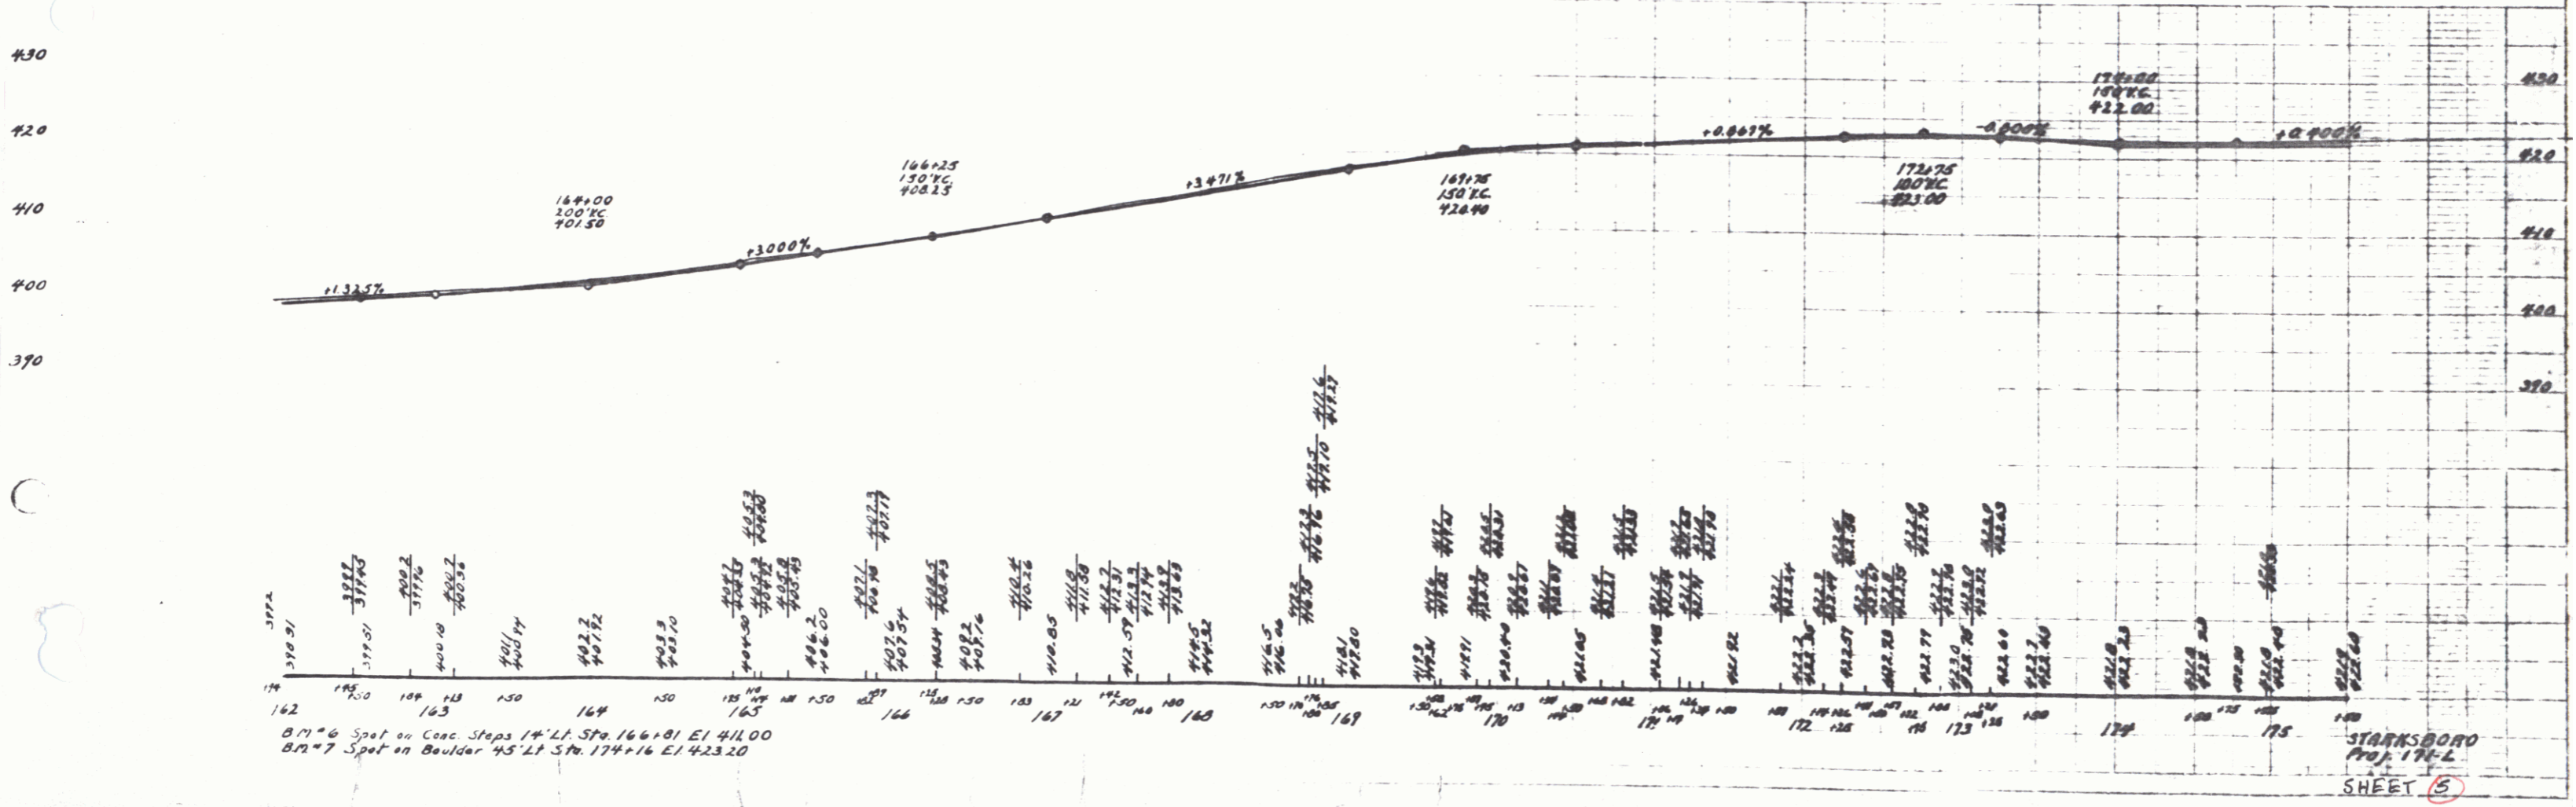

B.M. 6 Spot on Conc Steps 14' Lt. Sta. 164+81 El. 411.00  
 B.M. 7 Spot on Boulder 45' Lt. Sta. 174+16 El. 423.20

STARKS ROAD  
 Proj. 176-L  
 SHEET 5



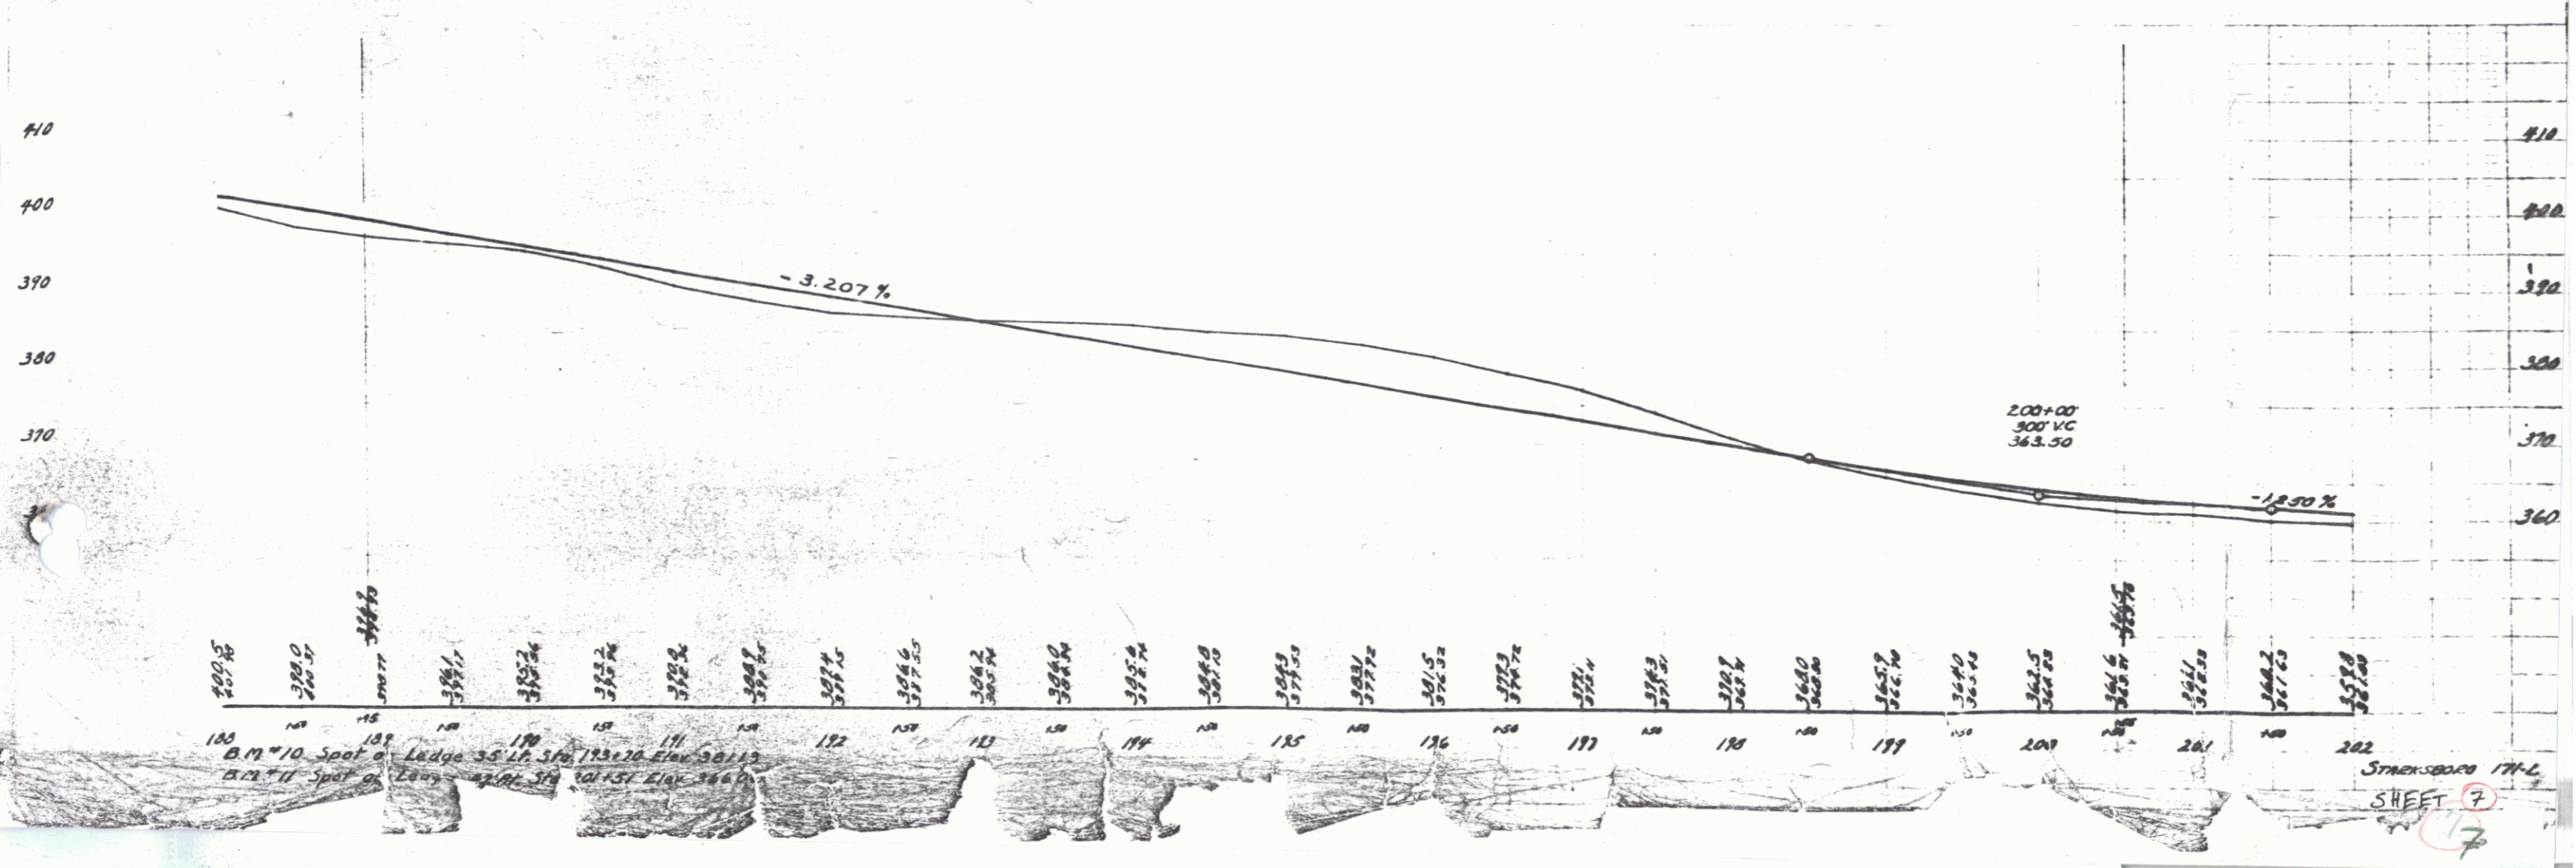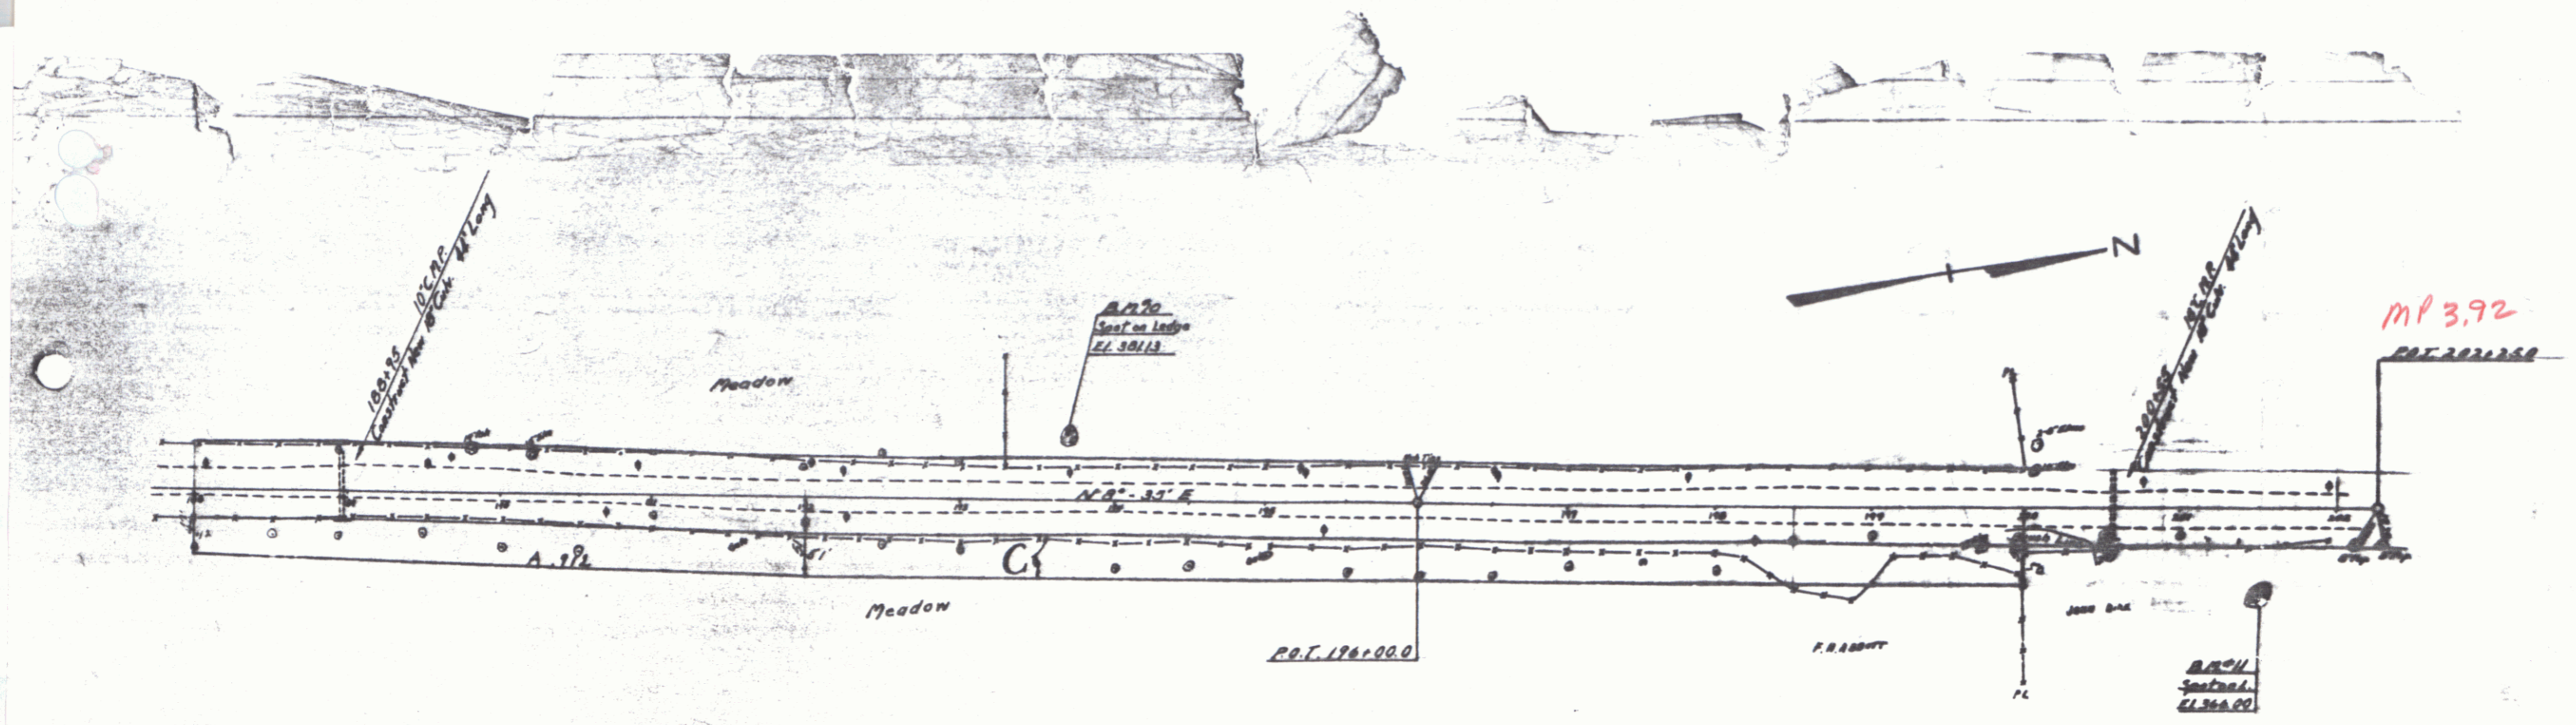

MP 3.92

STATION 174  
SHEET 7