


140 1833 6 95

PARCEL INSTRUMENT DATE 11 W.D.O.E. 9-16-30
 GRANTOR HAROLD M. & ALICE E. DEANE
 GRANTEE ST. OF VT.
 RECORDED So. BURLINGTON BOOK PAGE DATE 22 34 9-20-30
 REMARKS APPLICATION 4/25.6/1930 Slope and channel high

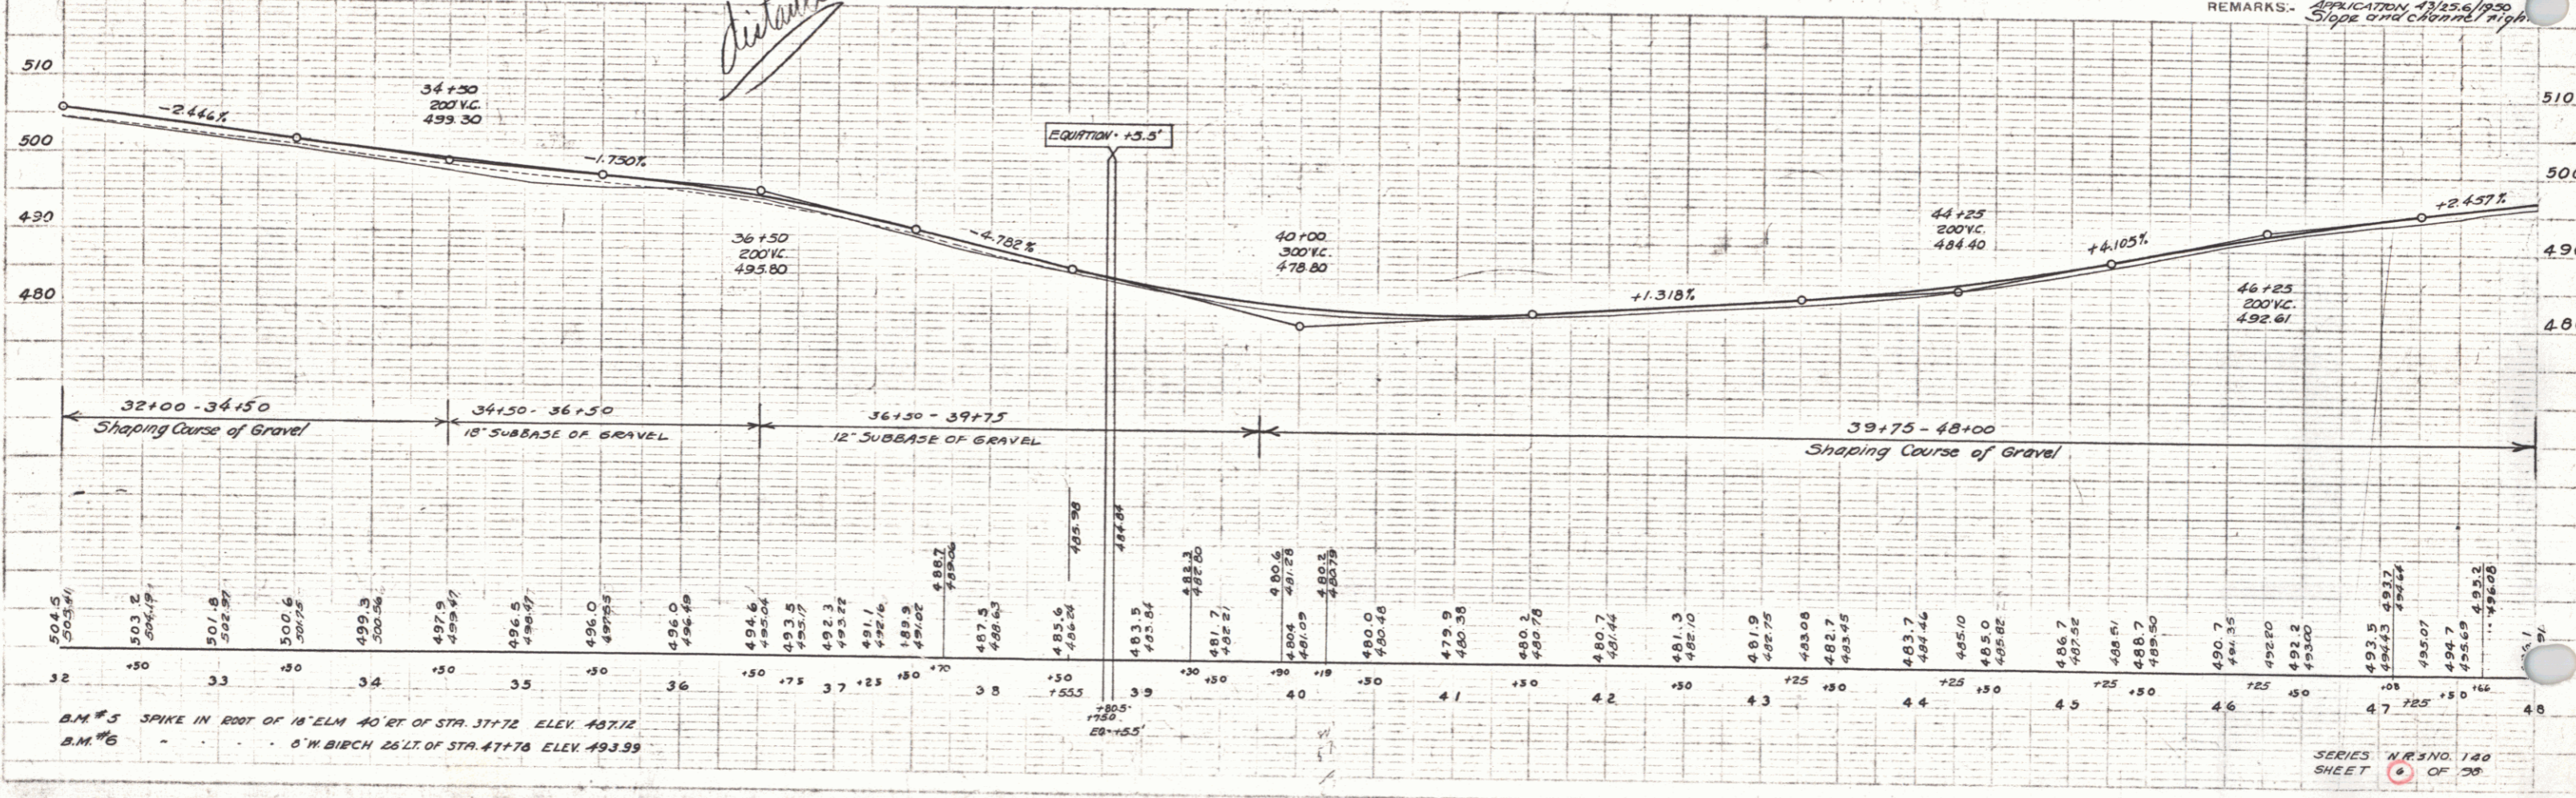

PLAN
 H.M. DEANE
 ALICE E. DEANE
 THOMAS RYAN ESTATE
 W.H. MURDOCK

PROFILE
 H.M. DEANE
 ALICE E. DEANE
 THOMAS RYAN ESTATE
 W.H. MURDOCK

B.M. #5 SPIKE IN FOOT OF 18' ELM 40' ET OF STA. 37+72 ELEV. 487.12
 B.M. #6 6" W BIRCH 26' LT. OF STA. 47+76 ELEV. 493.39

SERIES N.R. 3 NO. 120 SHEET 1 OF 30