
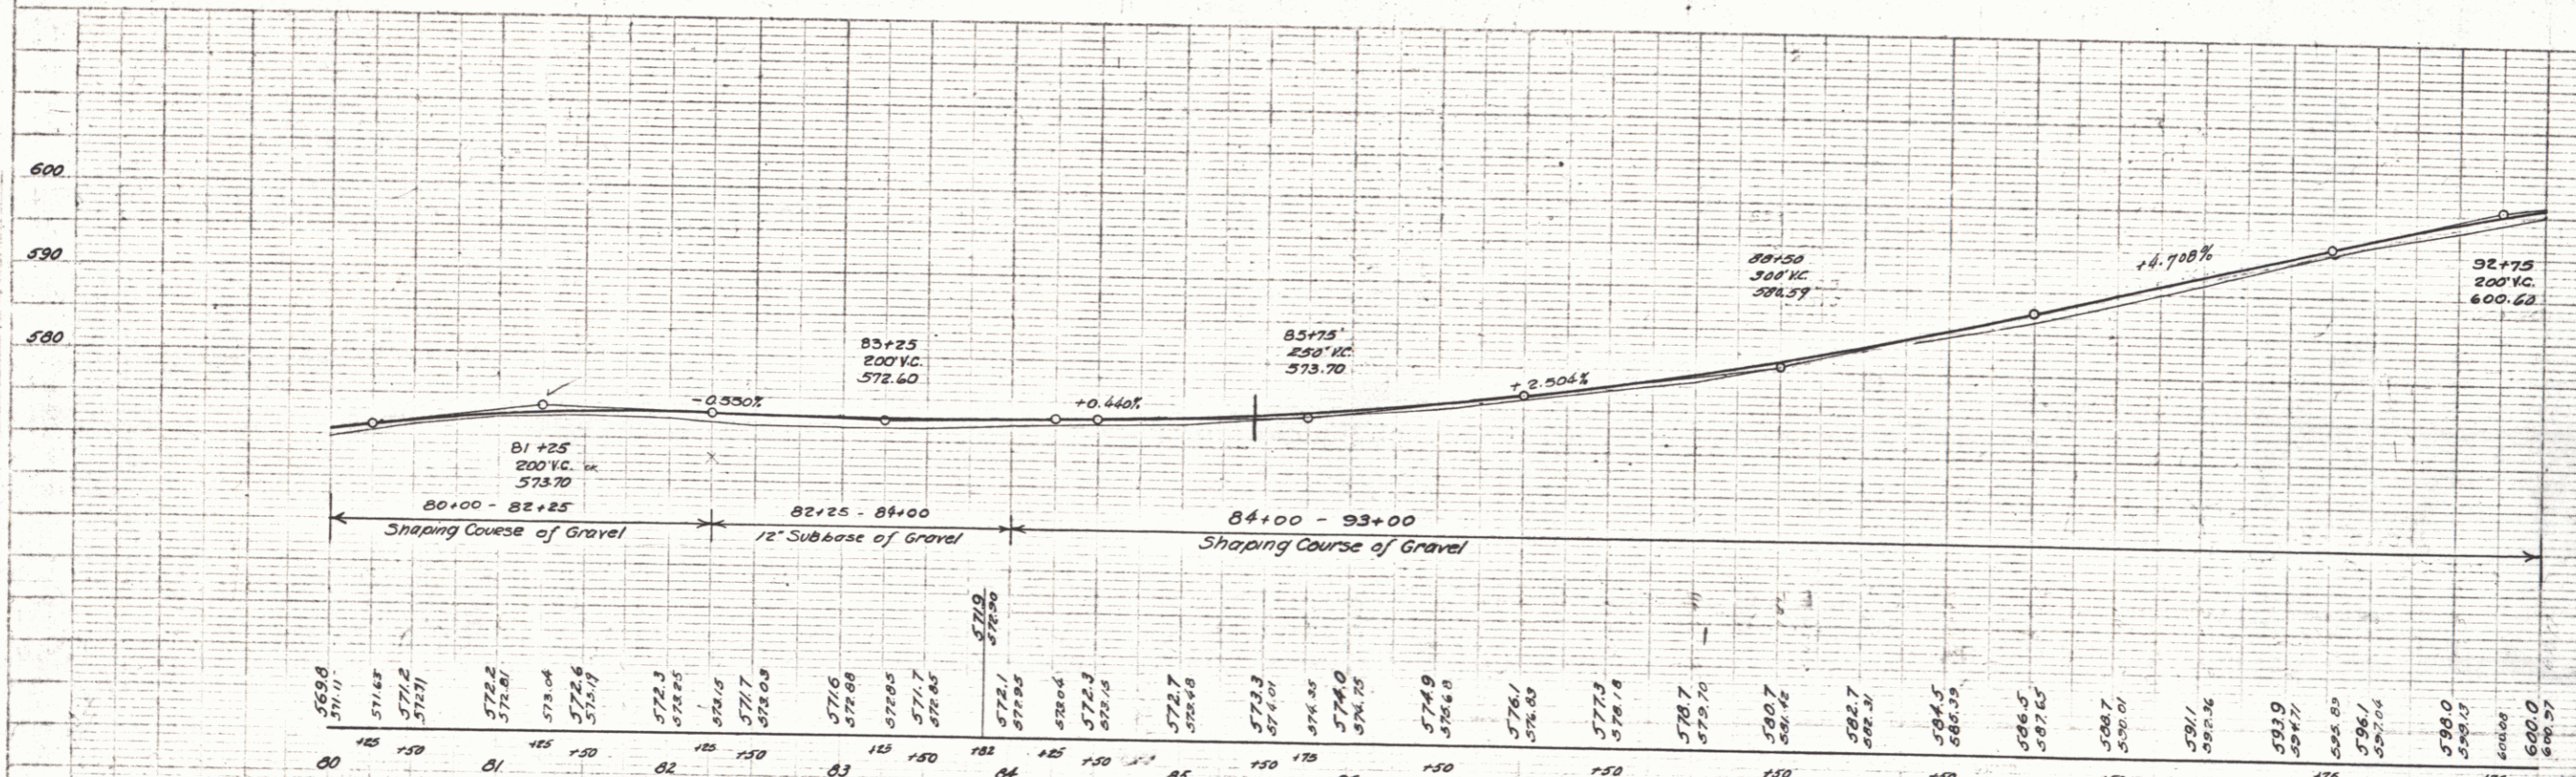


WOOD
 DIVISION & SUCCESSION
 DISTRICT ENGINEER
 STATE OF OHIO

WOOD
 DIVISION & SUCCESSION
 DISTRICT ENGINEER
 STATE OF OHIO

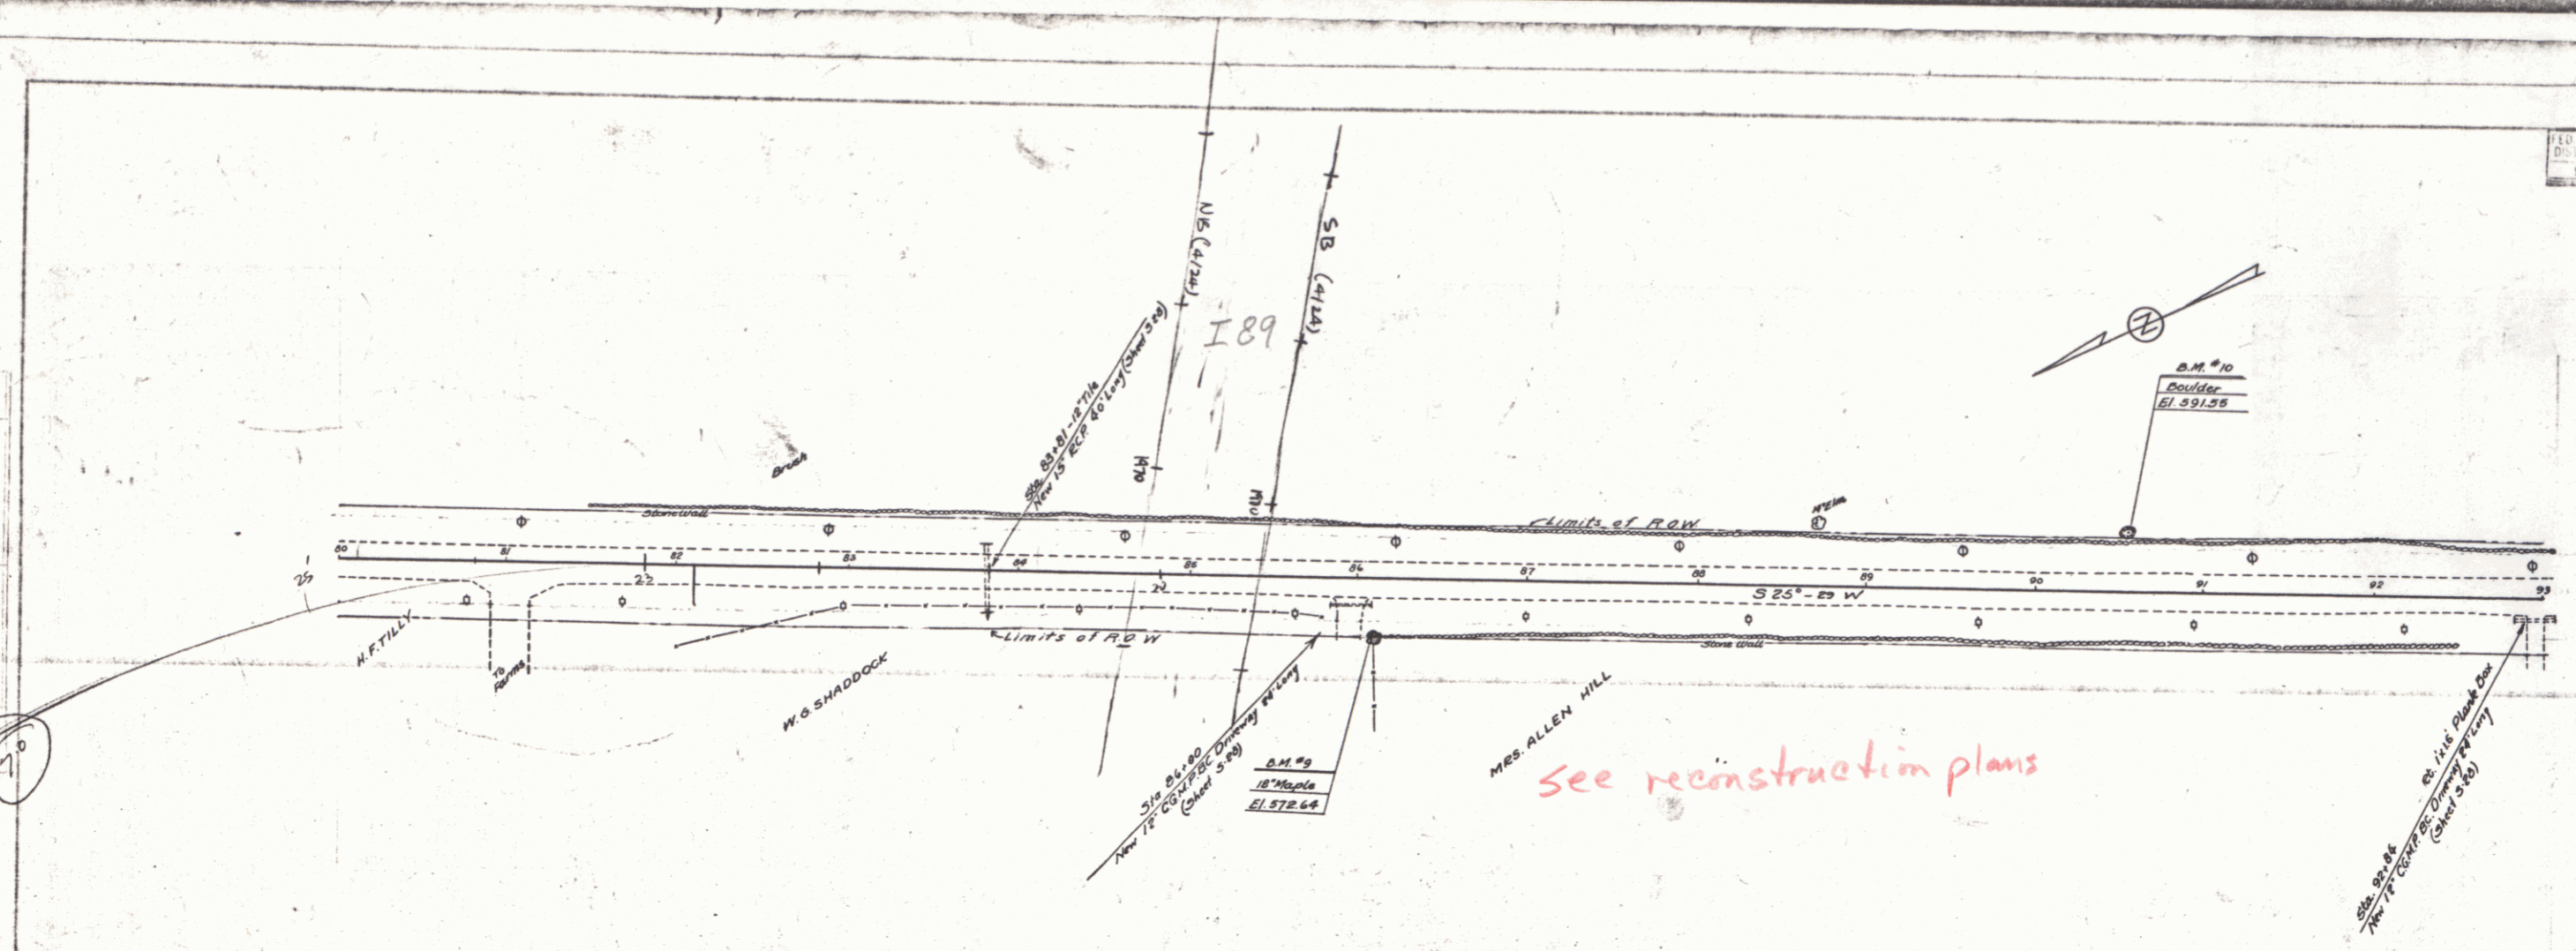

B.M. #9 SPIKE IN ROOT OF 12" MAPLE 33' RT. OF STA. 86+07 ELEV. 572.64
 B.M. #10 SPOT ON BOULDER 29' LT. OF STA. 90+54 ELEV. 591.55