
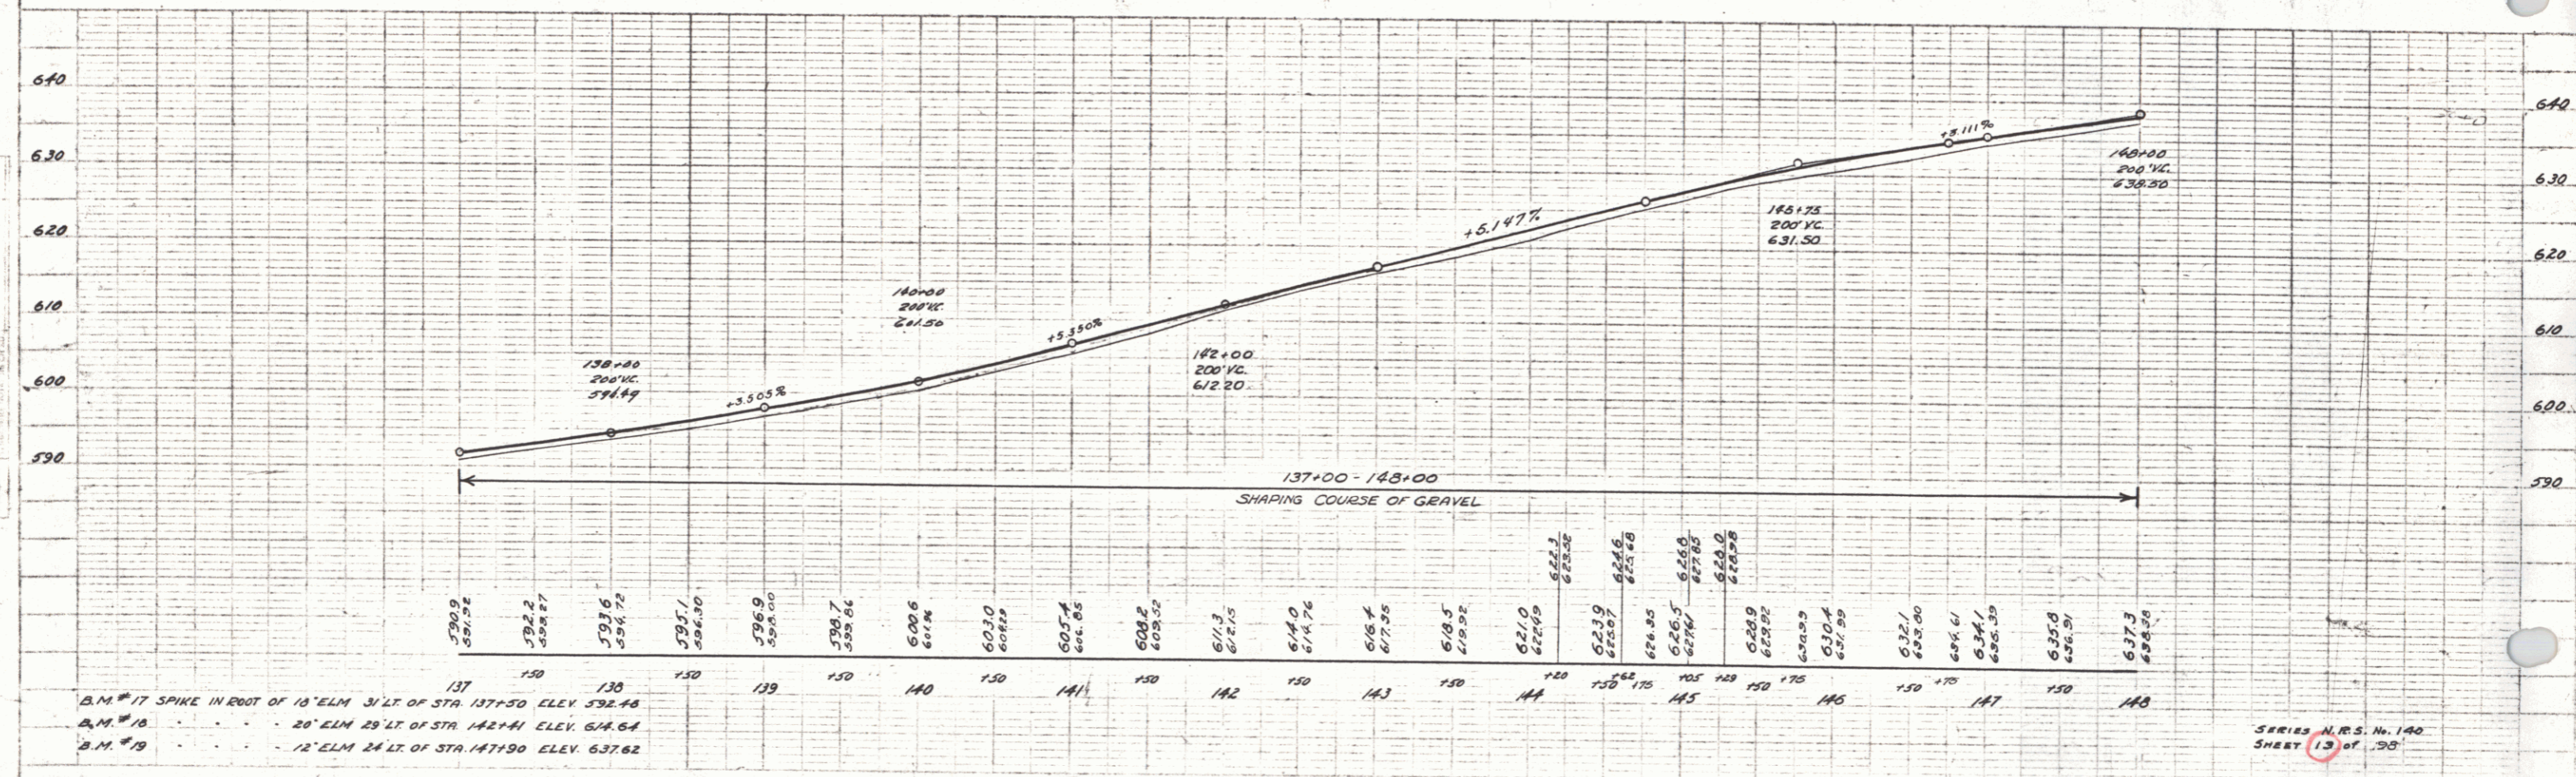


PLAN
 COUNTY Wood
 SECTION 10
 TOWNSHIP 10 N.
 RANGE 10 E.
 REF. TO MAP OF ILL. STATE

PROJ. NO. N/15190
 SHEET NO. 13 OF 28

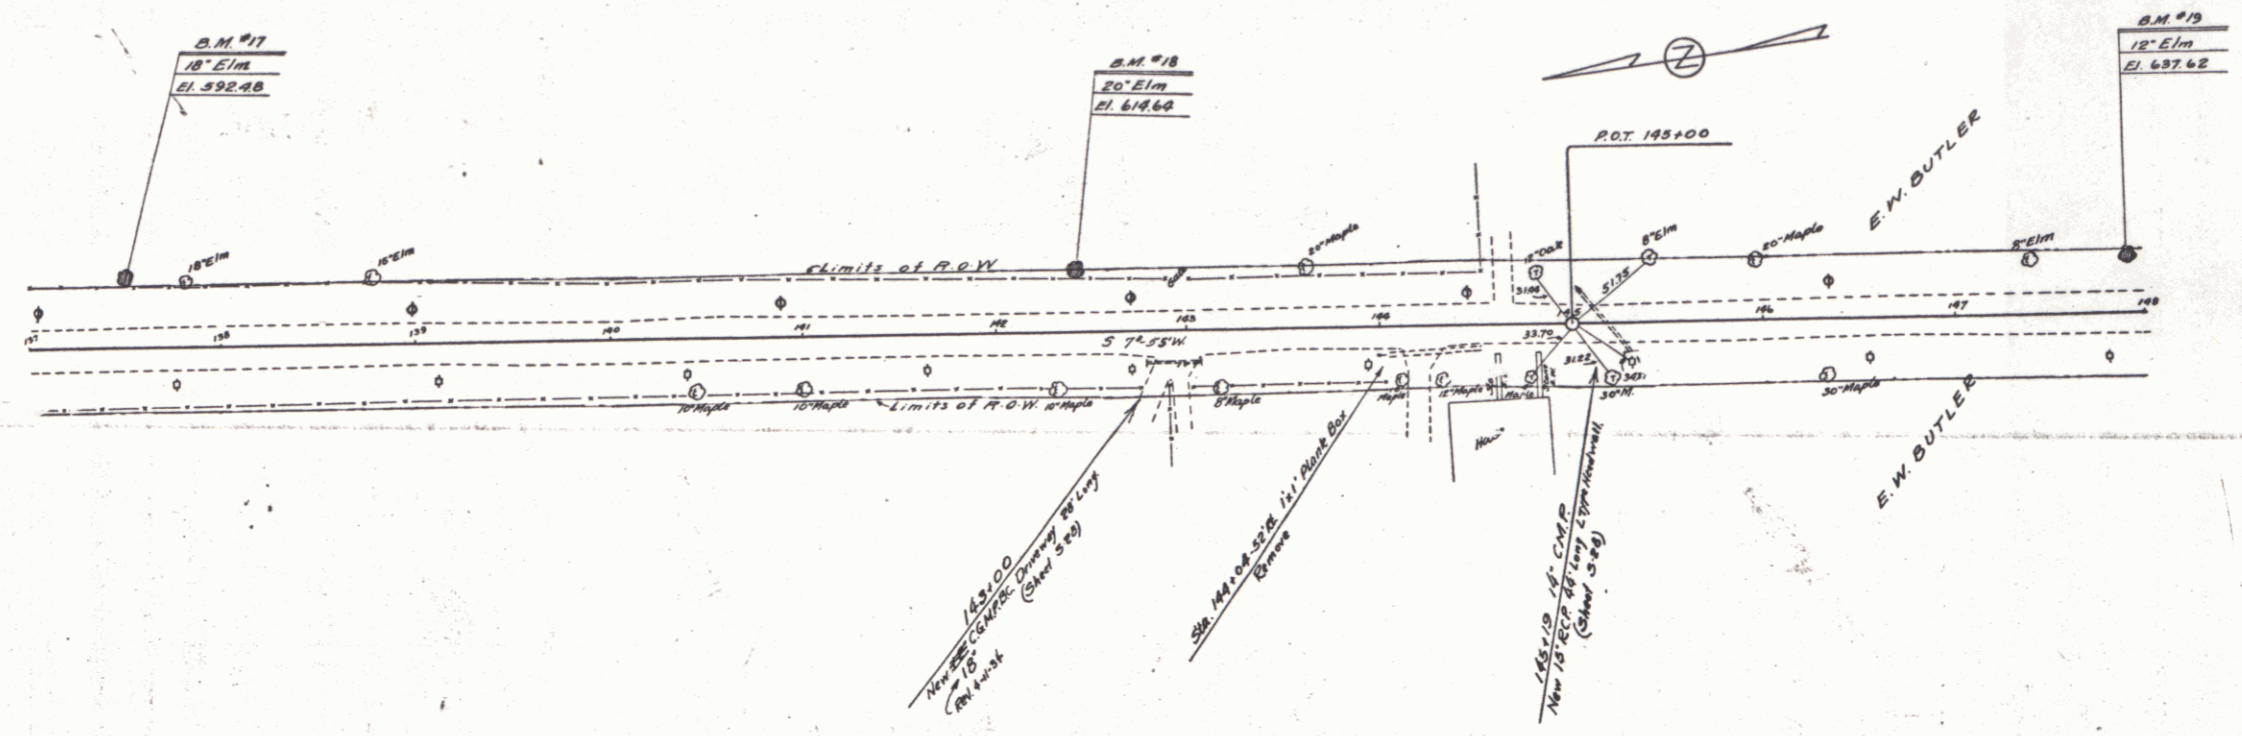

B.M. #17 SPIKE IN ROOT OF 18' ELM 31' LT. OF STA. 137+50 ELEV. 592.48
 B.M. #18 20' ELM 29' LT. OF STA. 142+41 ELEV. 618.64
 B.M. #19 12' ELM 24' LT. OF STA. 147+90 ELEV. 637.62