


PLAN
 DATE BOOK
 1933
 17
 98

PLAN
 DATE BOOK
 1933
 17
 98

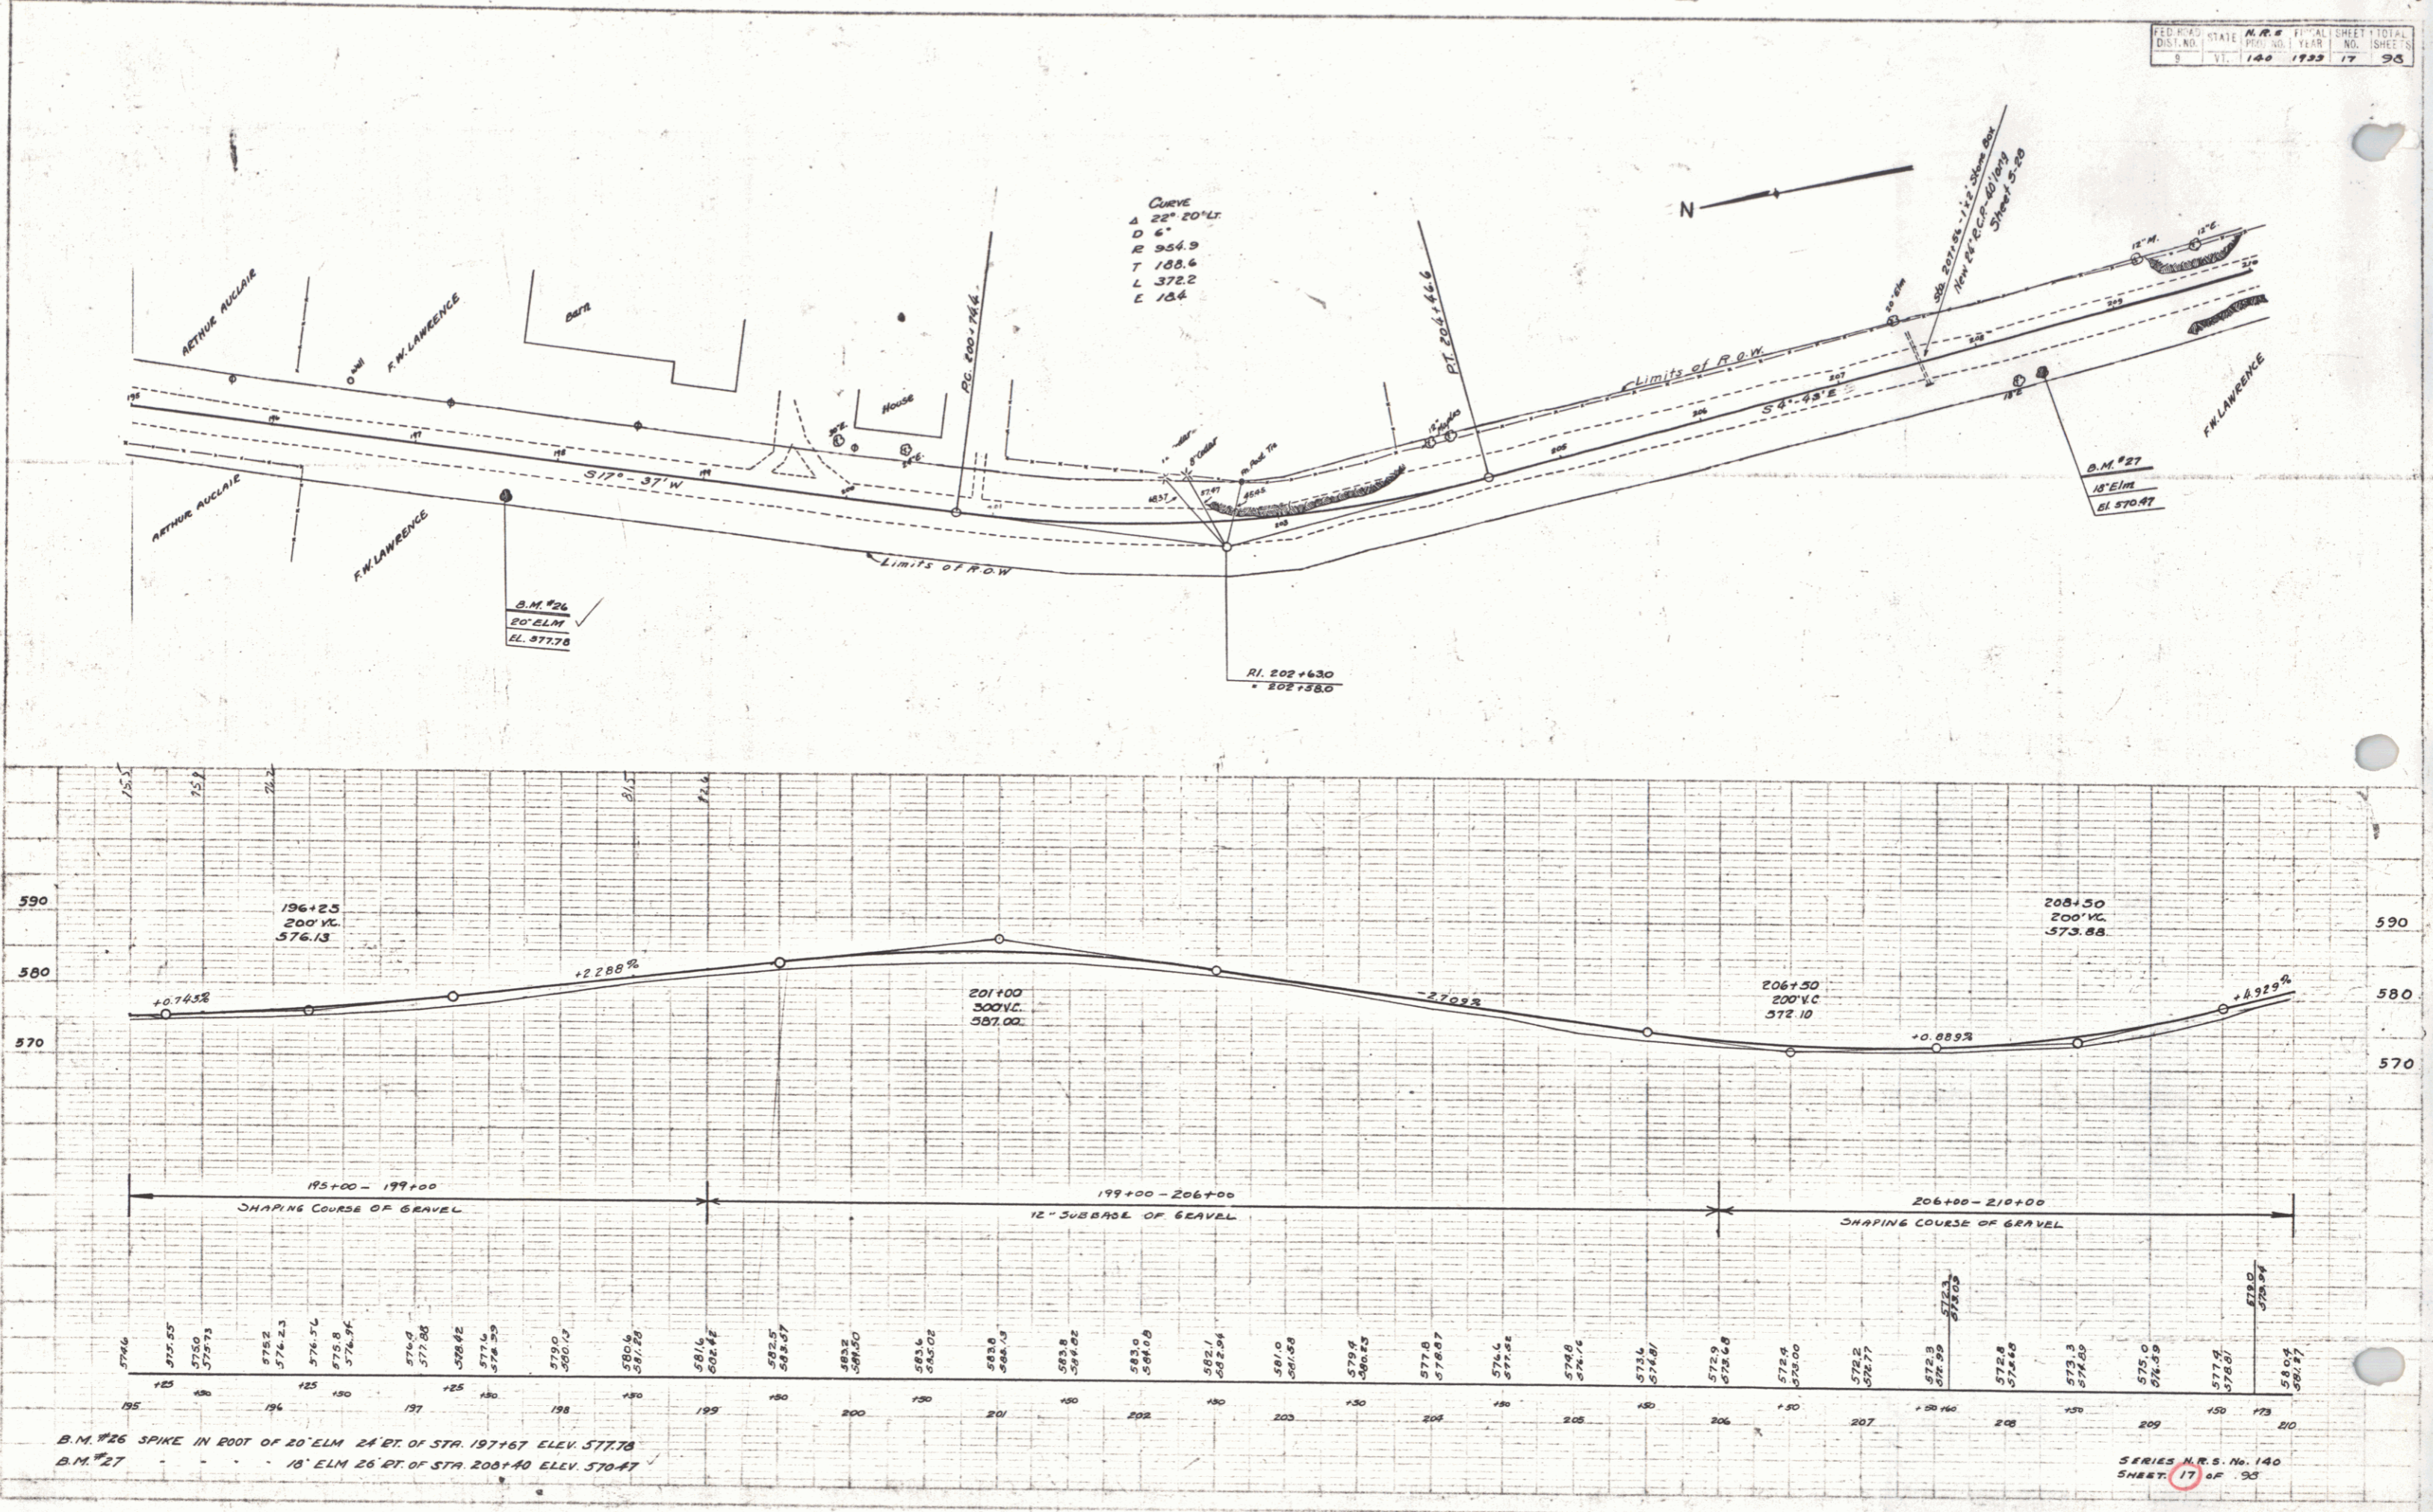

B.M. #26 SPIKE IN ROOT OF 20' ELM 24' DI. OF STA. 197+67 ELEV. 577.78
 B.M. #27 18' ELM 26' DI. OF STA. 200+40 ELEV. 570.87

SERIES N.R.S. No. 140
 SHEET 17 OF 93